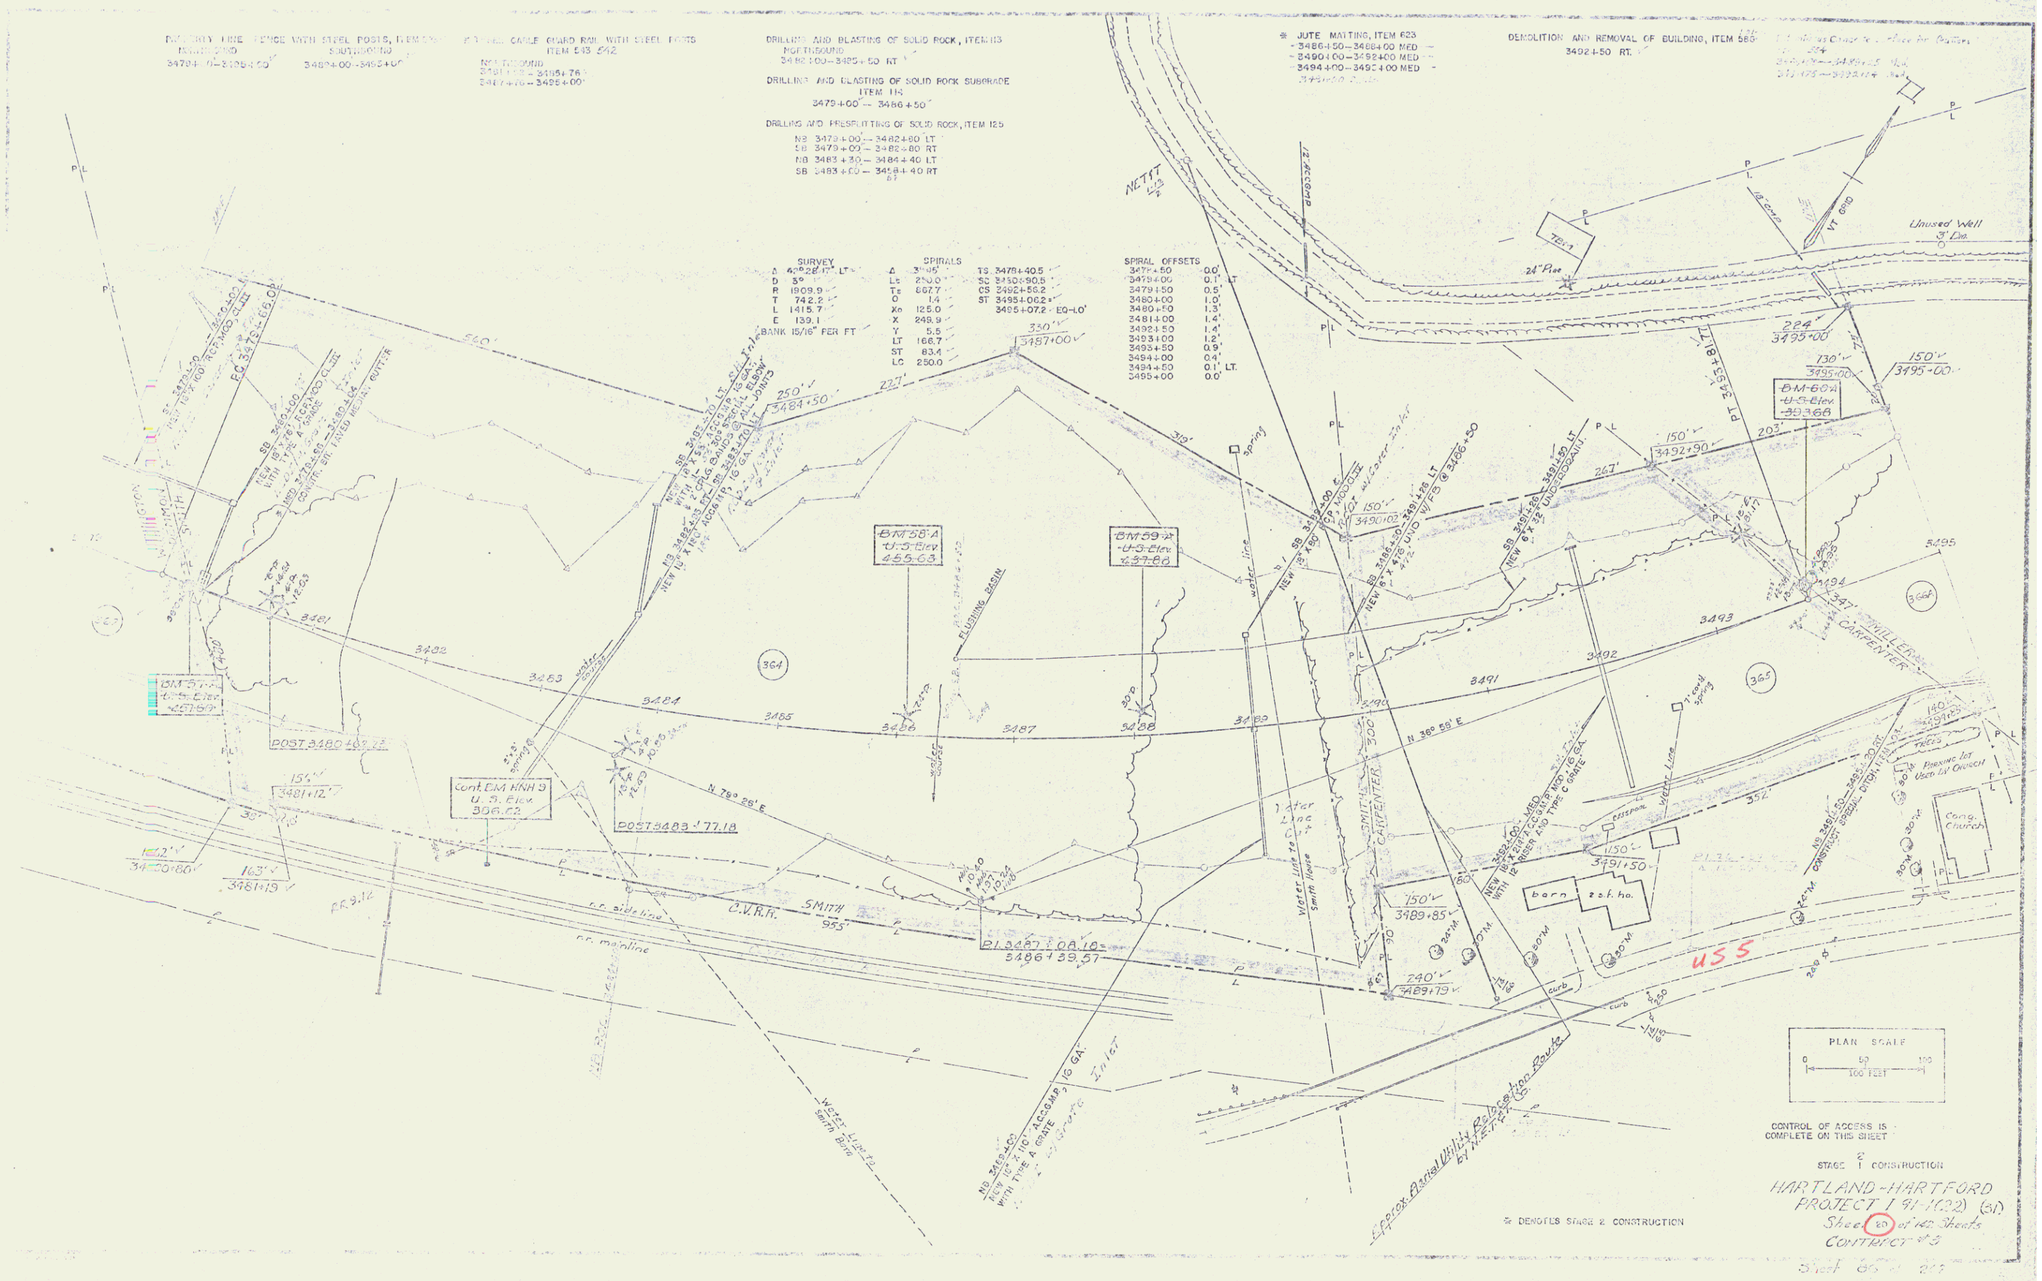
DRILLING AND BLASTING OF SOLID ROCK, ITEM 113
NORTHBOUND
3482+00 – 3485+50 RT
DRILLING AND BLASTING OF SOLID ROCK SUBGRADE
ITEM 114
3479+00 – 3486+50
DRILLING AND PRESPLITTING OF SOLID ROCK, ITEM 125
NB 3479+00 – 3482+80 LT
SB 3479+00 – 3482+80 RT
NB 3483+30 – 3484+40 LT
SB 3483+60 – 3484+40 RT
* JUTE MATTING, ITEM 623
3486+50 – 3488+00 MED
3490+00 – 3492+00 MED
3494+00 – 3492+00 MED
DEMOLITION AND REMOVAL OF BUILDING, ITEM 560
3492+50 RT.
SURVEY
Δ 42°28'10" LT
D 3°
R 1909.9'
T 742.2'
L 1415.7'
E 139.1'
BANK 15/16" PER FT
SPIRALS
Δ 3°45'
Ls 250.0'
Ts 667.7'
O 1/4'
Xo 125.0
X 248.9
Y 5.5
LT 166.7
ST 83.4
LC 250.0
TS 3478+40.5
SC 3480+90.5
CS 3492+56.2
ST 3495+06.2
3495+07.2 - EQ-LO'
SPIRAL OFFSETS
3479+50 0.0'
3479+00 0.1' LT
3479+50 0.5'
3480+00 1.0'
3480+50 1.3'
3481+00 1.4'
3482+50 1.4'
3483+00 1.2'
3483+50 0.9'
3484+00 0.4'
3484+50 0.1' LT.
3485+00 0.0'
BM 58-A U.S. Elev. 455.63
BM 59 U.S. Elev. 457.83
BM 57 U.S. Elev. 457.97
Cont. BM NNH 9 U.S. Elev. 306.62
POST 3480 163.12
POST 3483 177.18
Unused Well 3' Dia.
24" Pine
BM 60 U.S. Elev. 459.66
Pt. 3495+18.5
Pt. 3495+18.5
Spring
Water Line
Smith House
SMITH
CARPENTER
C.V.R.R.
r.r. sideline
r.r. mainline
P.I. 3487 + 0A 10
3486 + 39.57
barn
res. ho.
Cong. Church
Parking lot Vets. Lt. Church
USS
PLAN SCALE
0 50 100
100 FEET
CONTROL OF ACCESS IS COMPLETE ON THIS SHEET
STAGE 1 CONSTRUCTION
HARTLAND-HARTFORD
PROJECT I 91-1(22) (61)
Sheet 80 of 160 Sheets
CONTRACT #3
Sheet 85 of 267
* DENOTES STAGE 2 CONSTRUCTION
Approx. Partial Utility Relocation Route by N.E.T.P.C.
35