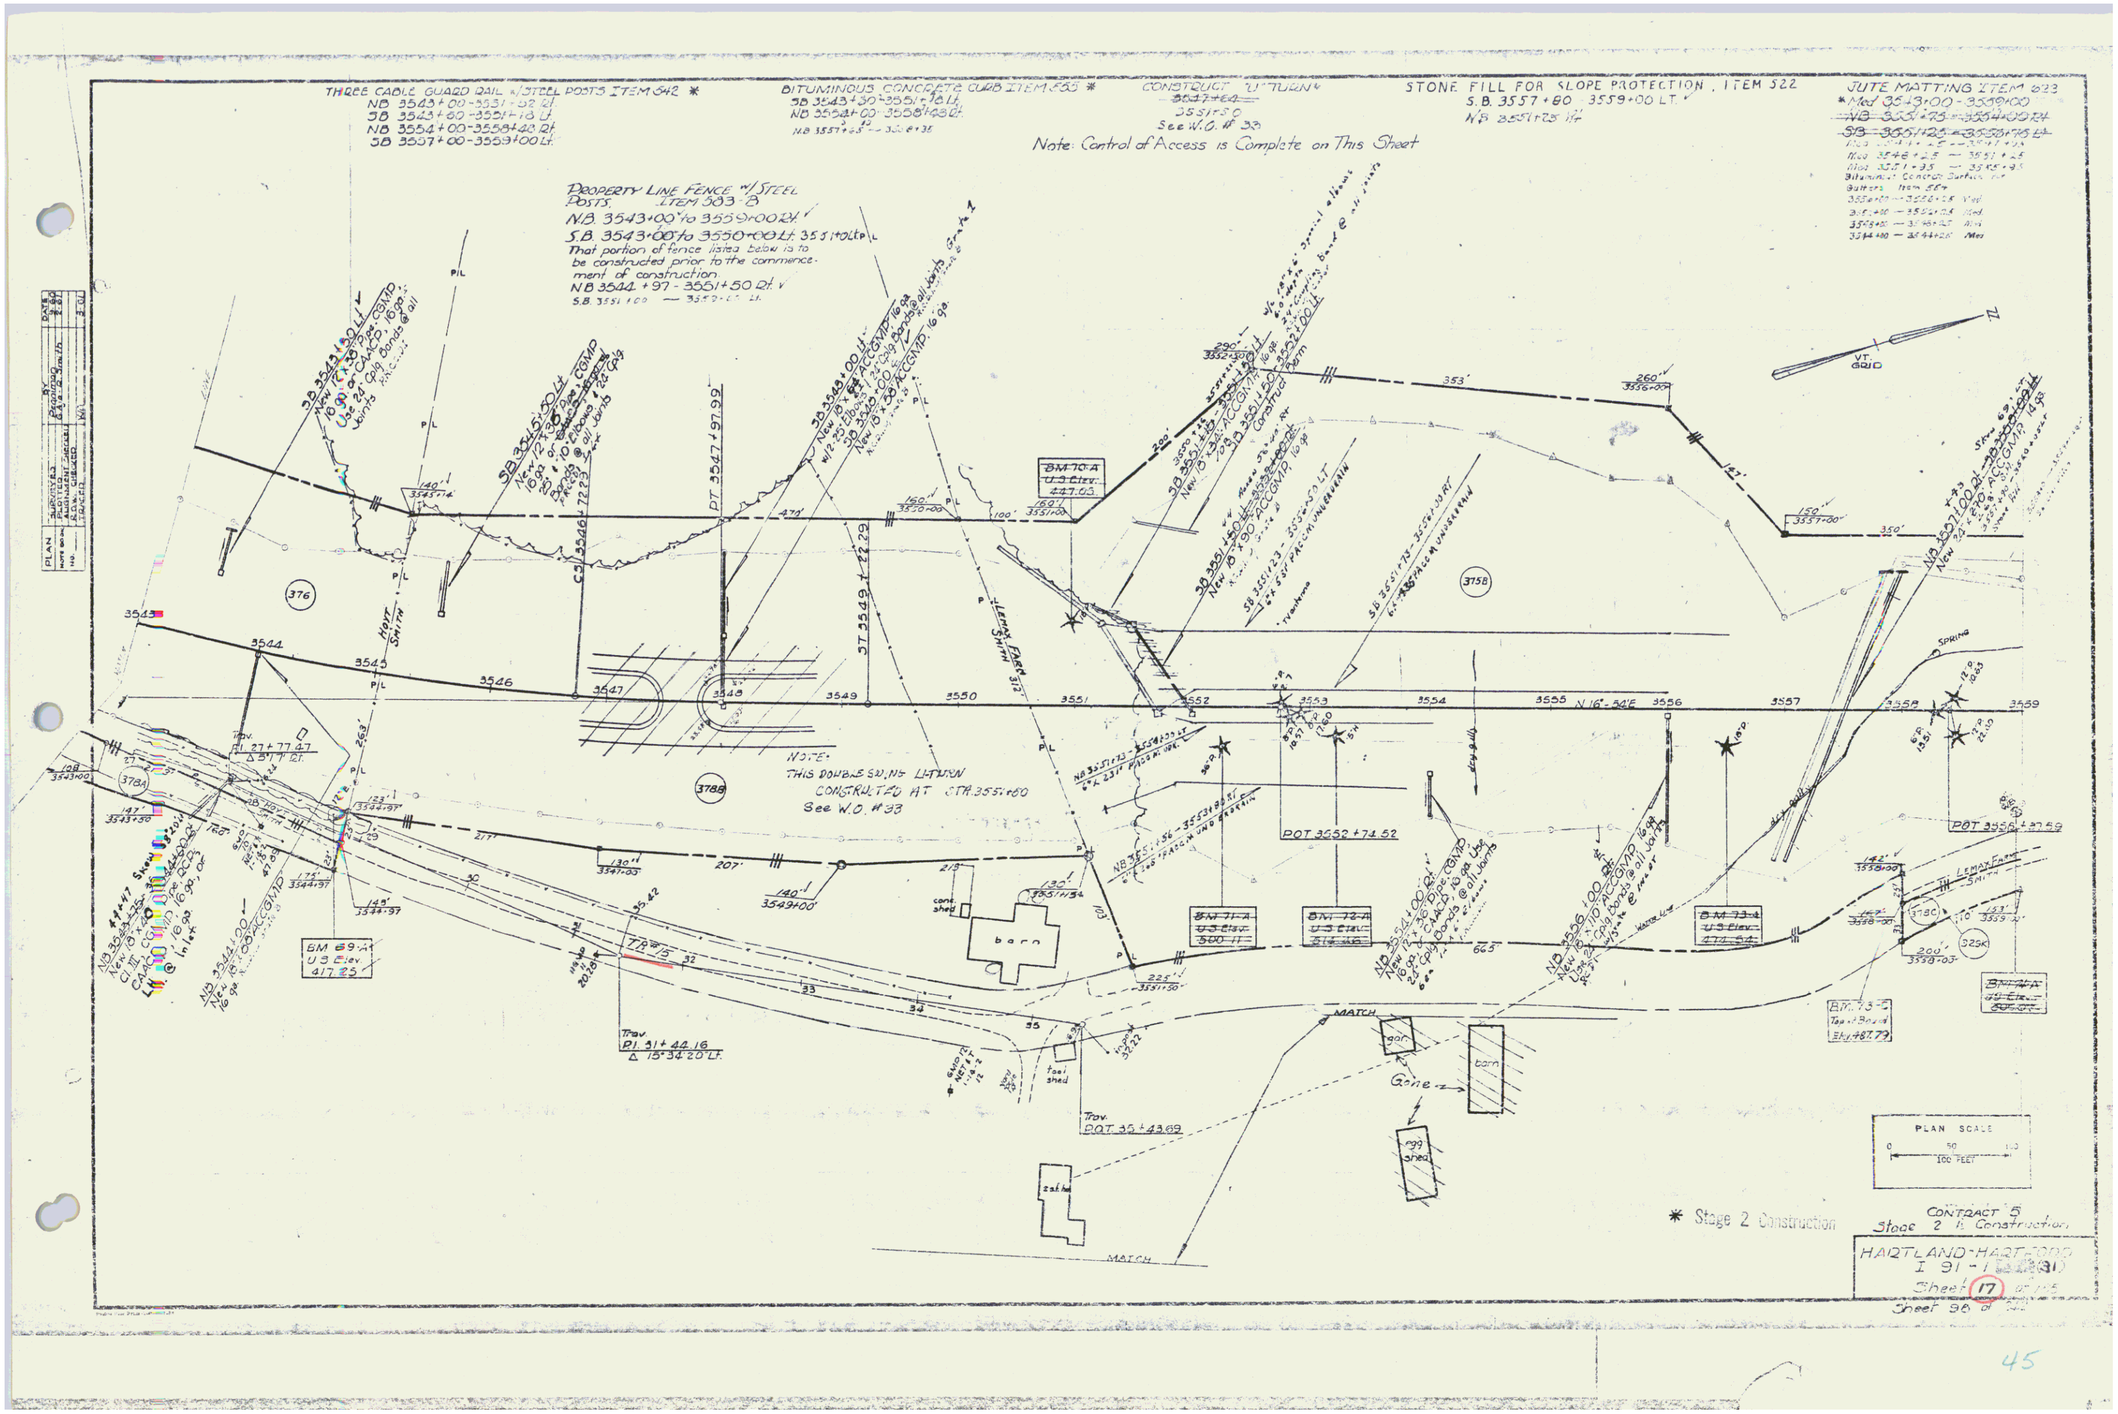
THREE CABLE GUARD RAIL w/STEEL POSTS ITEM 642 *
NB 3543+00-3551+32 Rt.
SB 3543+00-3551+13 Lt.
NB 3554+00-3558+40 Rt.
SB 3557+00-3559+00 Lt.
BITUMINOUS CONCRETE CURB ITEM 653 *
SB 3543+30-3551+18 Lt.
NB 3554+00-3558+48 Rt.
CONSTRUCT "U" TURN
See W.O. # 33
STONE FILL FOR SLOPE PROTECTION, ITEM 522
S.B. 3557+80 - 3559+00 LT.
JUTE MATTING ITEM 623
Note: Control of Access is Complete on This Sheet
PROPERTY LINE FENCE w/STEEL POSTS. ITEM 303-B
N.B. 3543+00 to 3559+00 Rt.
S.B. 3543+00 to 3550+00 Lt.
That portion of fence listed below is to be constructed prior to the commencement of construction.
NB 3544+97 - 3551+50 Rt.
NOTE:
THIS DOUBLE SWING LITTER CONSTRUCTED AT STA. 3551+60
See W.O. #33
BM 70-A
Water
447.03
BM 69-A
U.S. Elev.
417.85
BM 71-A
U.S. Elev.
BM 72-A
U.S. Elev.
BM 73-A
U.S. Elev.
BM 74-A
U.S. Elev.
BM 73-B
Top of Board
Elev. 487.77
POT 3552+74.52
POT 3558+87.59
POT 35+43.69
Trav. PI 31+44.16
Δ 15°34'20" Lt.
Trav. PI 27+77.47
Δ 37°11'21" Rt.
barn
cont. shed
tool shed
silo
MATCH
Gone
PLAN SCALE
0 50 100
100 FEET
* Stage 2 Construction
CONTRACT 5
Stage 2 & Construction
HARTLAND-HARTFORD
I 91-1
Sheet 17 of 18
Sheet 98 of 98
45