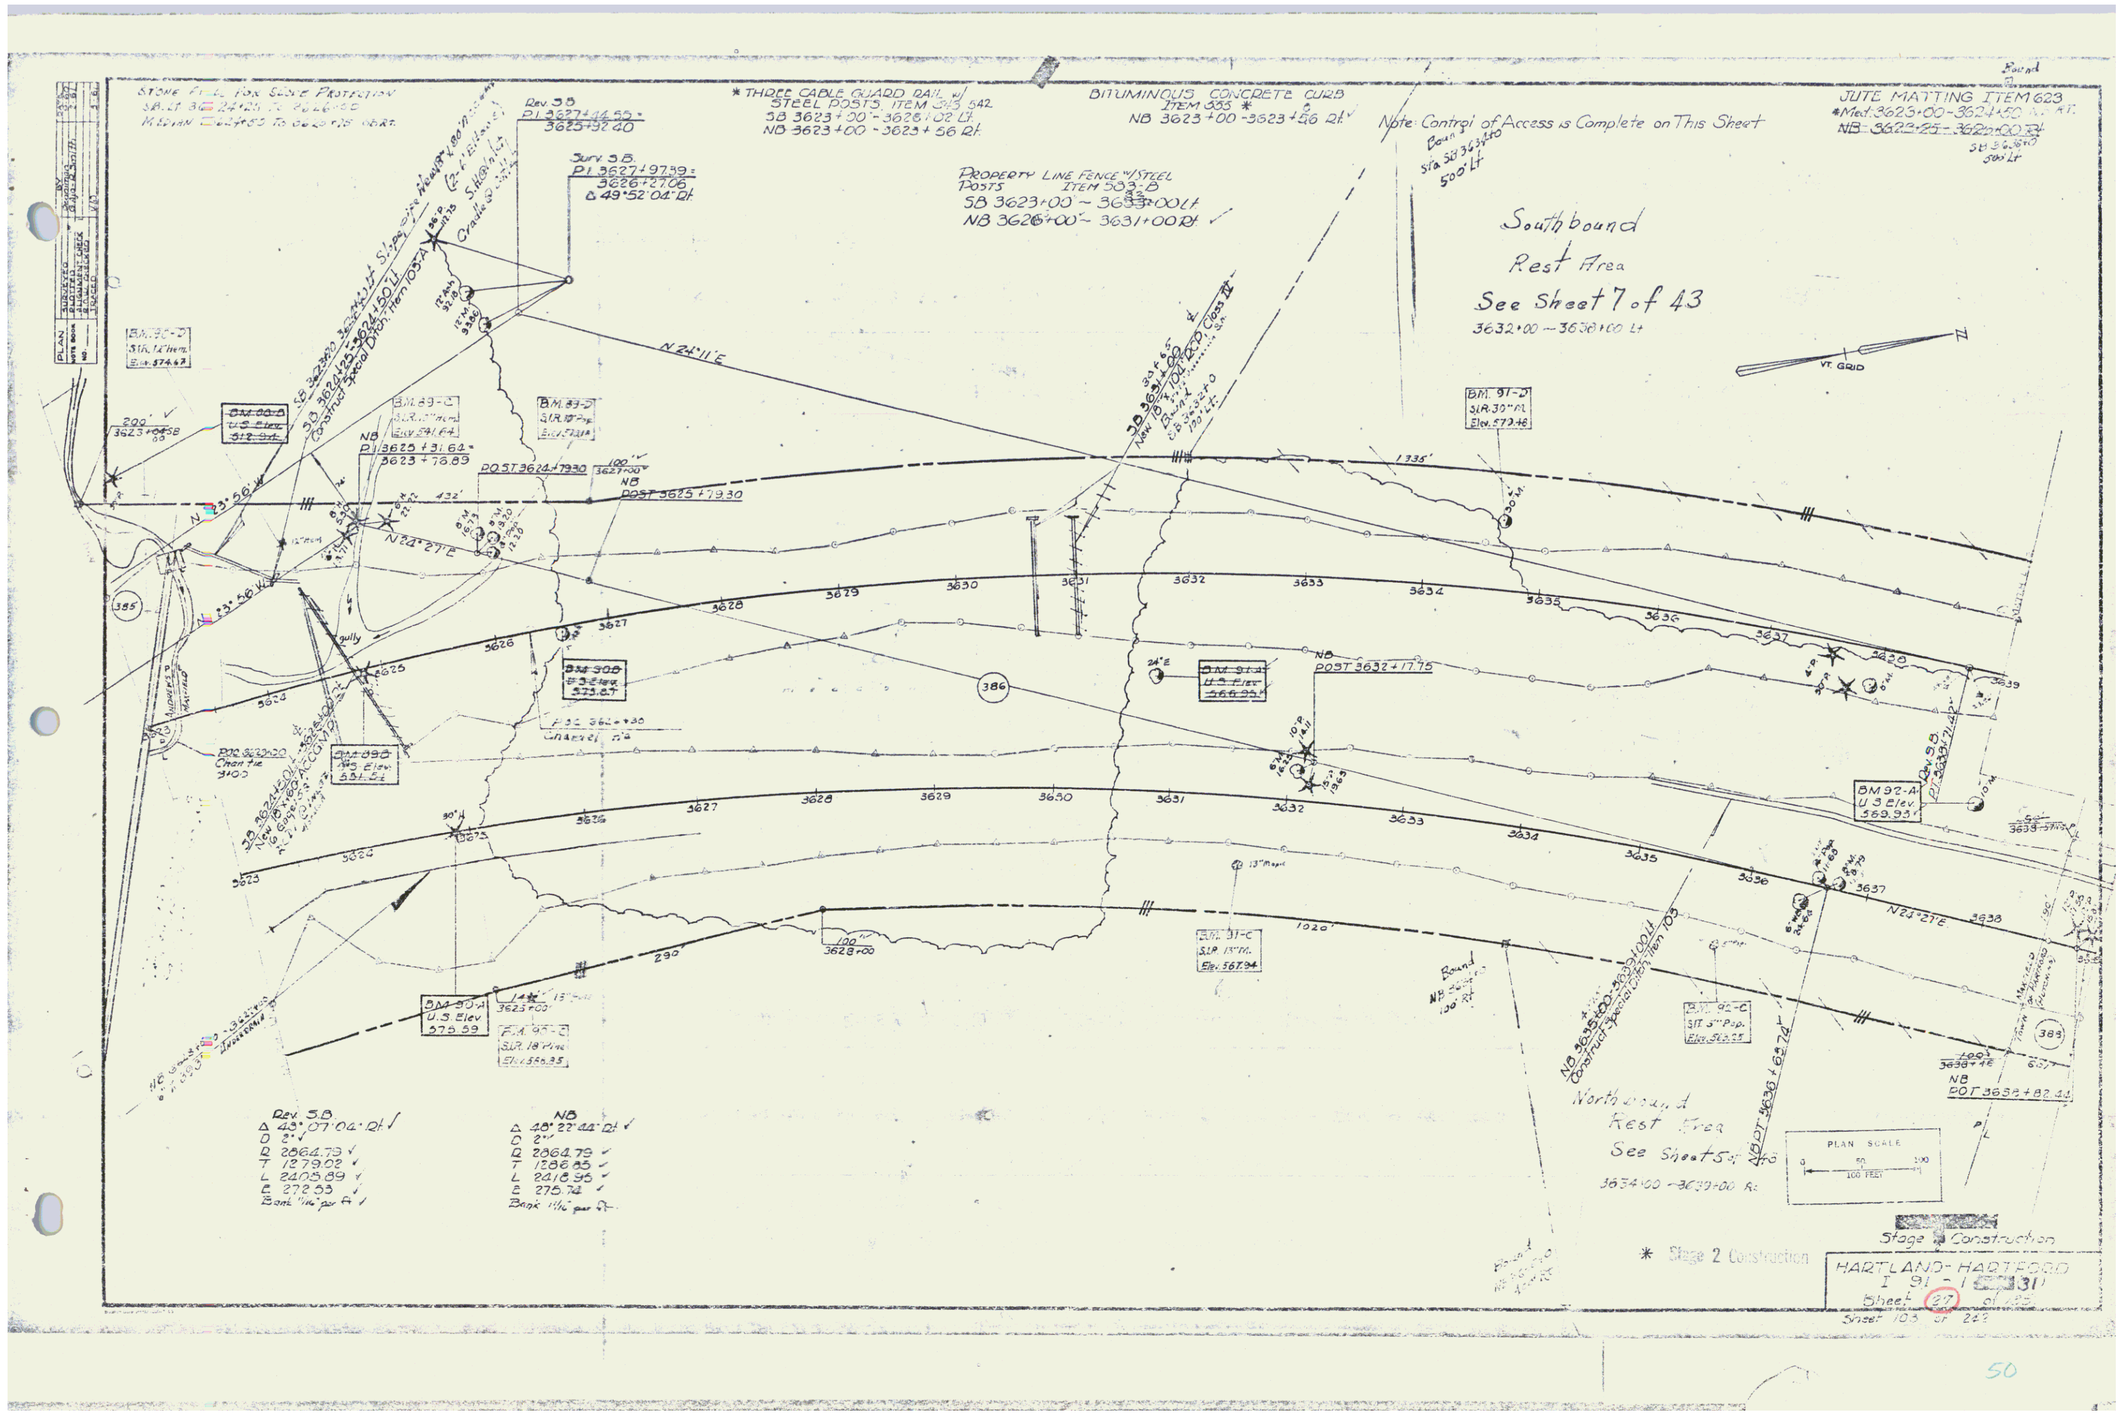
STONE FILL FOR SCOUR PROTECTION
* THREE CABLE GUARD RAIL w/ STEEL POSTS, ITEM 605.542
SB 3623+20 - 3626+02 Lt
NB 3623+00 - 3623+56 Rt
BITUMINOUS CONCRETE CURB ITEM 605 *
NB 3623+00 - 3623+46 Rt
Note: Control of Access is Complete on This Sheet
JUTE MATTING ITEM 623
PROPERTY LINE FENCE w/ STEEL POSTS
ITEM 503.6
SB 3623+00 - 3633+00 Lt
NB 3626+00 - 3631+00 Rt
Southbound Rest Area
See Sheet 7 of 43
3632+00 - 3638+00 Lt
VT. GRID
Rev. SB
Δ 48°07'04" Rt
D 2°
R 2864.79
T 1279.02
L 2405.89
E 272.53
Bank 1½" per ft
NB
Δ 48°27'44" Rt
D 2°
R 2864.79
T 1286.85
L 2416.95
E 275.74
Bank 1½" per ft
Northbound Rest Area
See Sheet 5 of 43
3634+00 - 3639+00 Rt
PLAN SCALE
0 50 100
100 FEET
Stage 1 Construction
* Stage 2 Construction
HARTLAND-HARTFORD
I 91-1(31)
Sheet 27 of 43
Sheet 103 of 243