

DRILLING & BLASTING OF SOLID ROCK, SUBGRADE
ITEM 114 H RAMP 4150-6450

Construct 3724+25

PROPERTY LINE FENCE w/
STEEL POSTS, ITEM 585-B
NB 3718+04-3724+00 RL
Ramp 'H' 0+17-7+13 RL

STONE FILL for SLOPE PROTECTION
ITEM 522
SB 3718+50 LH-Ramp 'H' 4+43 LH
Ramp 'H' 3+00 RL-SB 3724+00 LH
Ramp 'H' 6+50-7+13 RL

* THREE CABLE GUARD RAIL
w/ STEEL POSTS, ITEM 542
NB 3718+04-3721+69 LH
SB 3718+00-3721+02 LH
NB 3722+40-3724+00 LH
Ramp 'H' 0+17-4+01 LH
Ramp 'H' 3+00-5+40 LH
Ramp 'H' 5+45-7+13 LH


JUTE MATTING, ITEM 673
SB 3719+50-3724+00 LH
Med 3720+50-3722+50

* GRANITE SLOPE EDGING,
ITEM 556-A
SB 3721+90-3722+148 LH
RAMP 'H' 1+65-2+15 LH

* STANDARD STEEL BEAM GUARD RAIL
w/ STEEL POSTS, ITEM 545-A
NB 3718+04-3724+00 LH
SB 3722+67-3722+86 LH

Not part of
Project I 91-1(31)

Not part of
Project I 91-1(31)

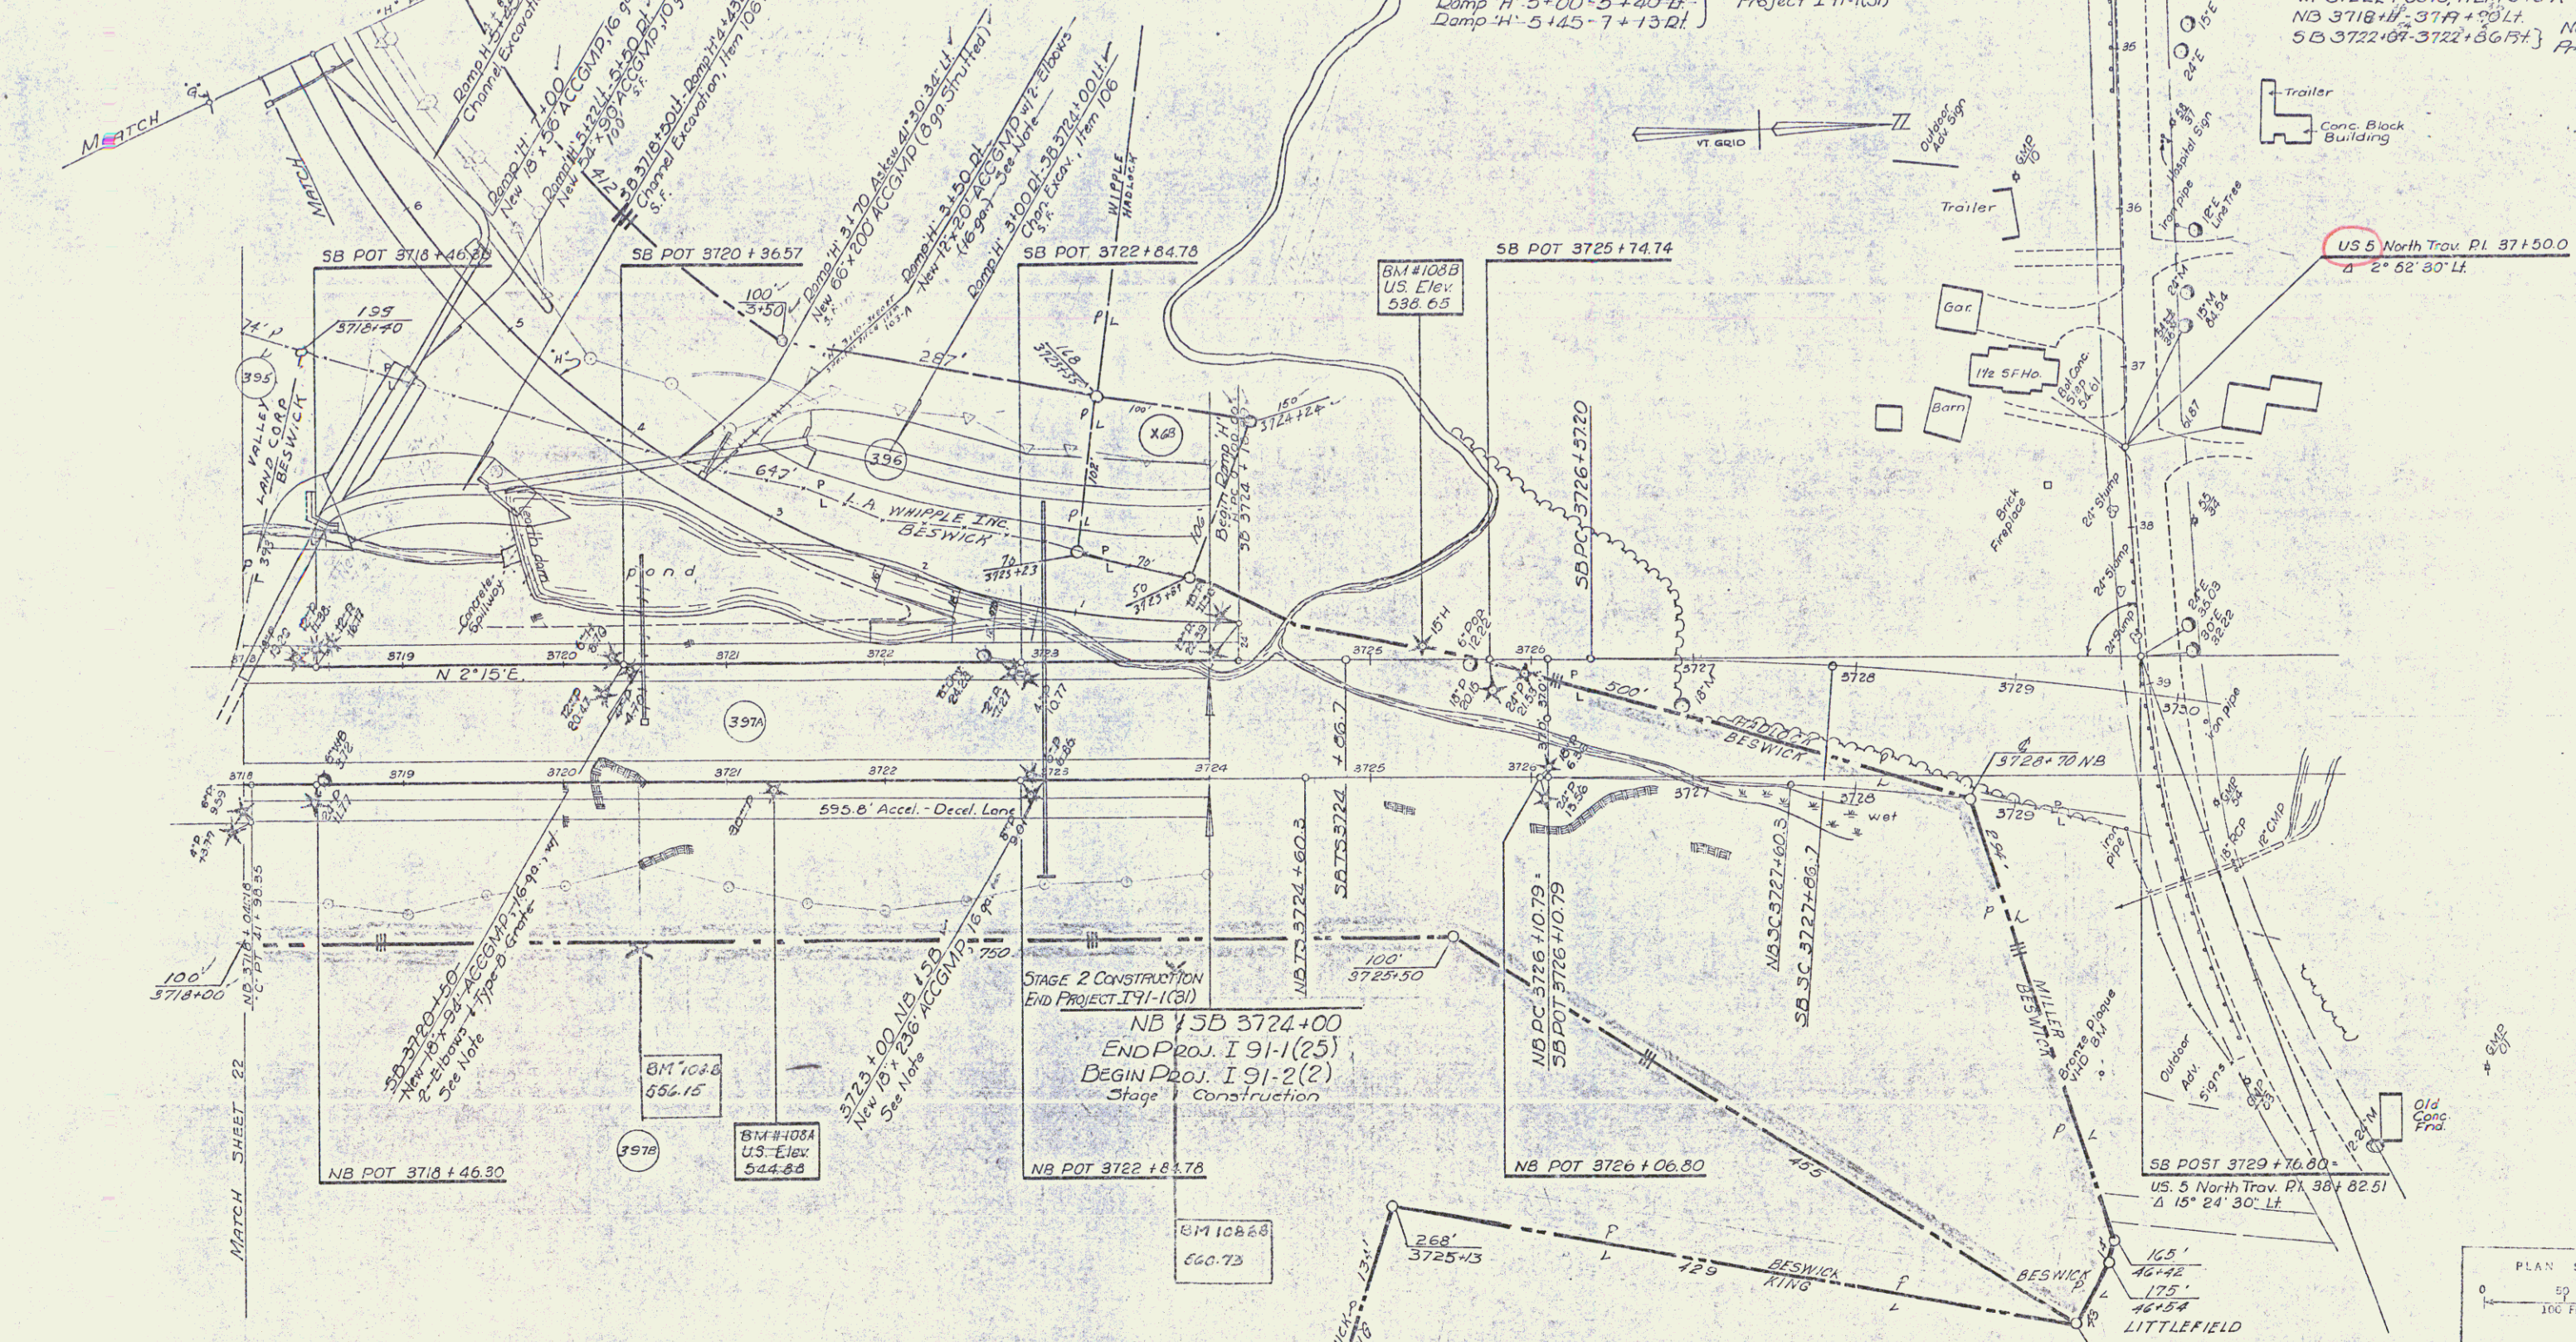

NOTE :-
These Culverts are to be installed after the Fill
has been completed by others.
-SB-3726+50
NB+SB-3723+00V
Ramp 'H'-3+50

* BITUMINOUS CONCRETE CURB
ITEM 555
Not part of
Project I 91-1(31) Ramp 'H' 0+17-3+50 RL

DRILLING & BLASTING OF SOLID ROCK
SUBGRADE, ITEM 114
Ramp 'H' 4+75-6+00

Bituminous Concrete Surface for Gutters
& Traffic Islands, ITEM 557
Ramp 'H' 1+51-1+52 RL

CONTROL OF ACCESS
COMPLETE ON THIS SHEET

RAMP 'H'
HARTLAND-HARTFORD
I 91-1(25)(31)
I 89-1(31) Interchange
Sheet 24 of
Sheet 122 of 244

Stage 2 Construction

