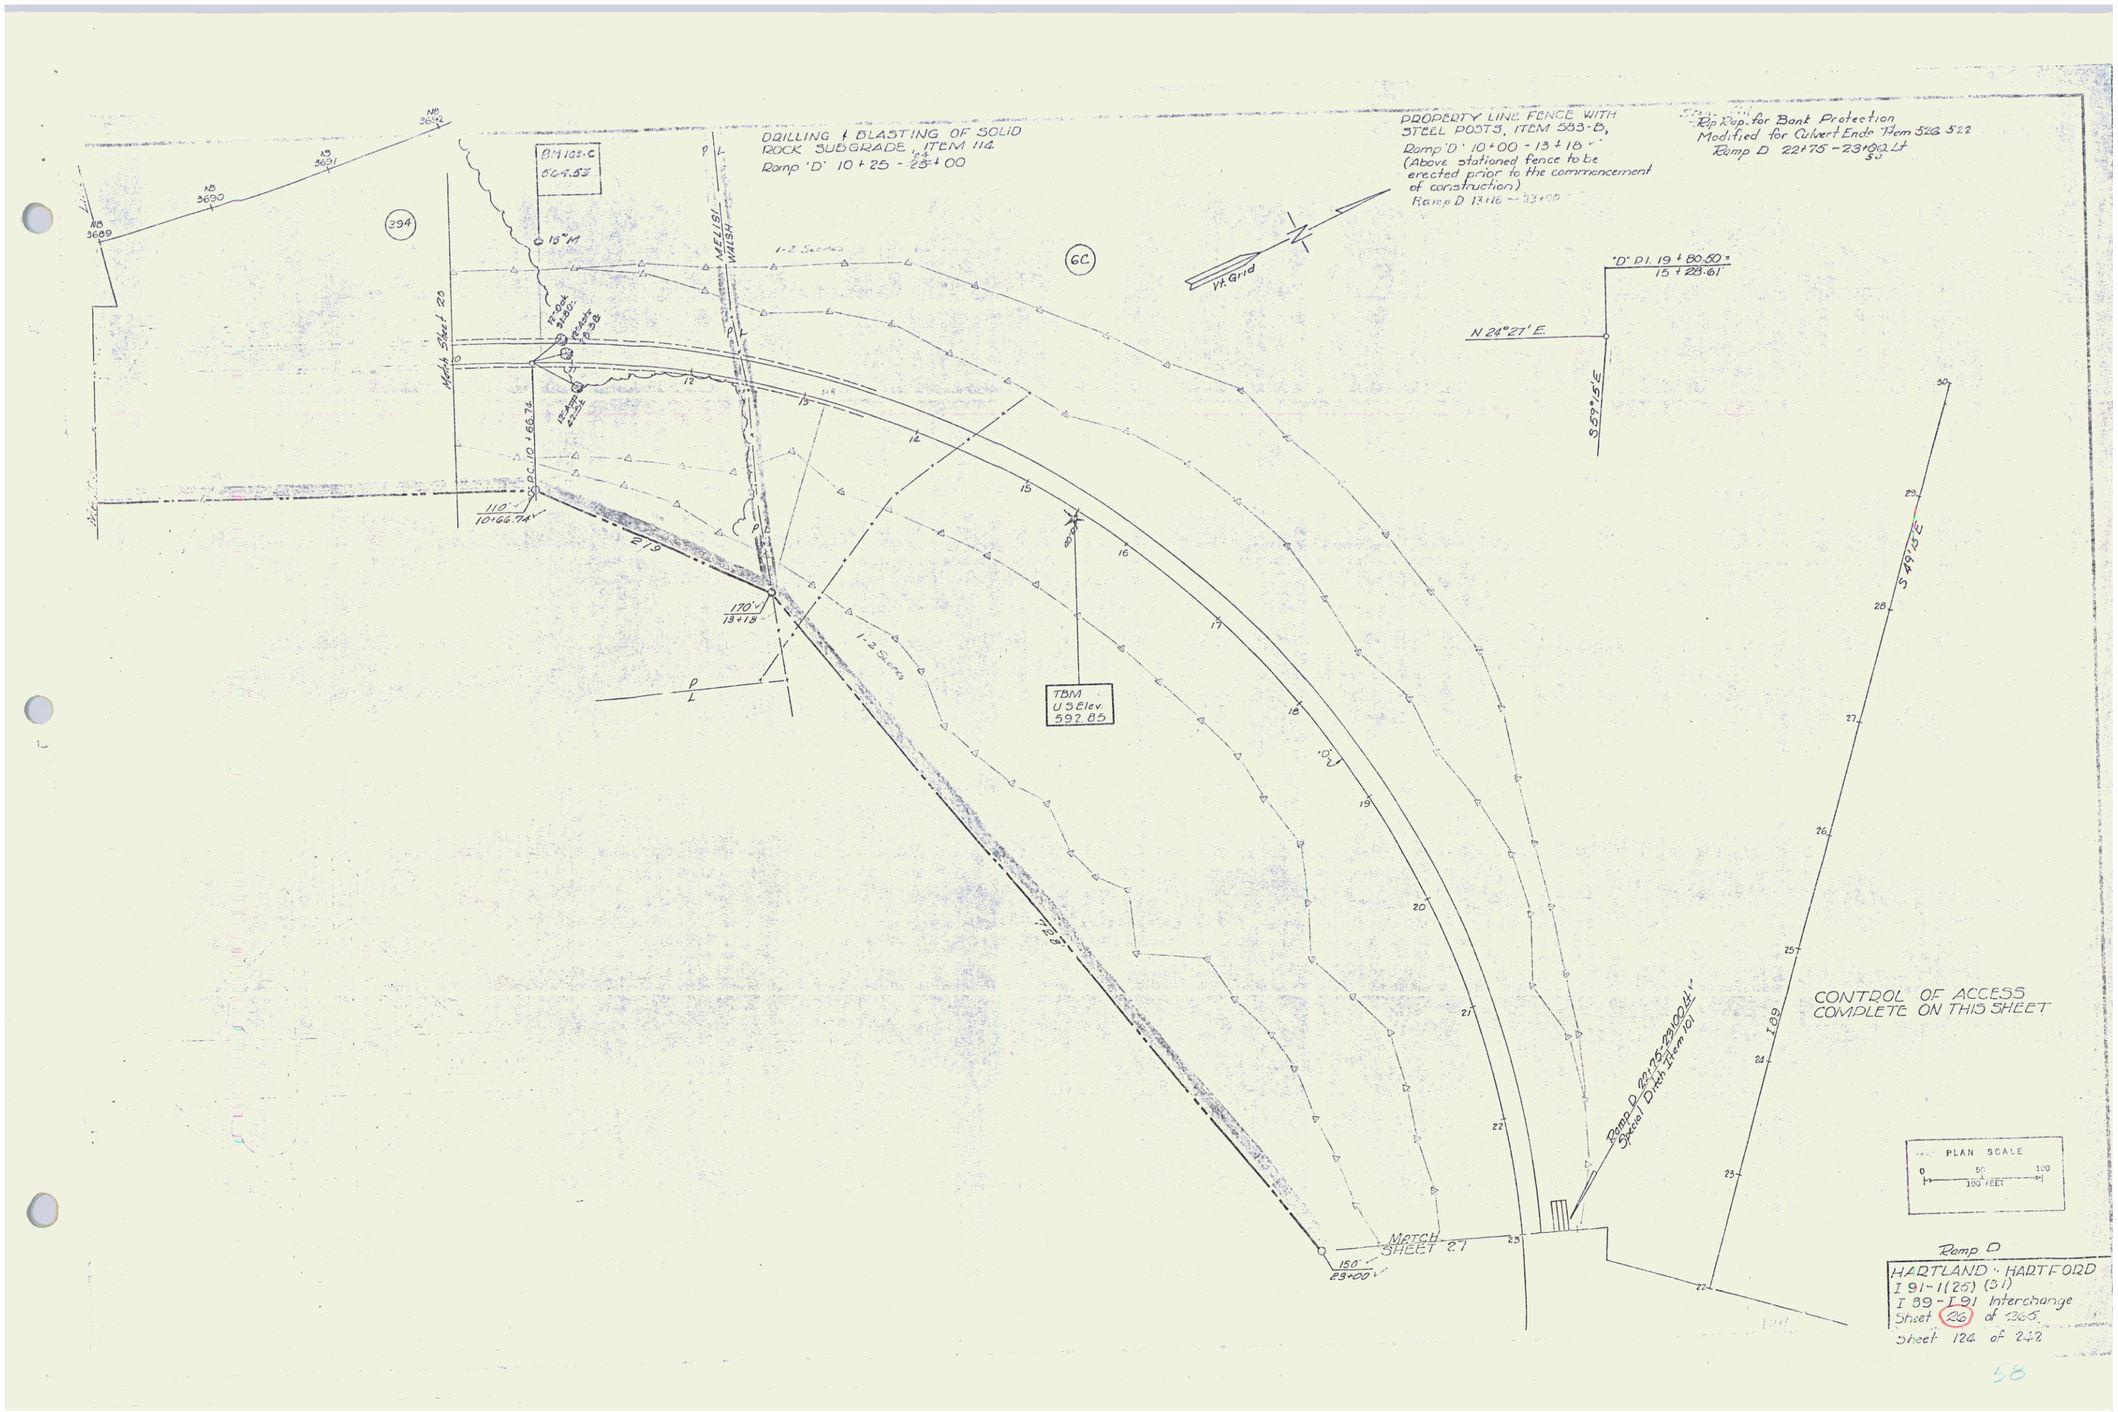
DRILLING & BLASTING OF SOLID ROCK SUBGRADE, ITEM 114
Ramp 'D' 10+25 - 23+00
PROPERTY LINE FENCE WITH STEEL POSTS, ITEM 583-B,
Ramp 'D' 10+00 - 13+18
(Above stationed fence to be erected prior to the commencement of construction)
Rip Rap for Bank Protection Modified for Culvert Ends Item 526 522
Ramp D 22+75 - 23+00 Lt
Vt. Grid
N 24°27' E
S 59°15' E
S 49°15' E
MELISI WASH
Match Sheet 25
TBM U.S. Elev. 592.85
MATCH SHEET 27
Ramp D 22+75-23+00 Lt Shoal Ditch Item 101
CONTROL OF ACCESS COMPLETE ON THIS SHEET
PLAN SCALE
0 50 100
100 FEET
Ramp D
HARTLAND - HARTFORD
I 91-1(25) (31)
I 89 - I 91 Interchange
Sheet 26 of 365
Sheet 124 of 242

58