

PROPERTY LINE FENCE w/  
STEEL POSTS, ITEM 555-B,  
Ramp C' 2+50-7+45 RL  
Ramp H' 7+13-14+28 RL  
Ramp C' 7+45-17+00 RL



The below stationed fence is to be  
erected prior to the commencement  
of construction  
Ramp C' 2+50-7+45 RL  
Ramp H' 8+40-14+28 RL

\* GRANITE SLOPE EDGING,  
ITEM 556-A  
Ramp C 3+88-4+38 RL  
Ramp C 16+86-17+00 RL  
Ramp E 16+87-17+00 RL  
Ramp F 4+50-12+00 RL  
Ramp G 0+00-4+65 RL  
Ramp G 0+97-1+47 RL

\* BITUMINOUS CONCRETE GUTTER  
ITEM 554  
Ramp F 6+00 RL  
Ramp F 7+50 RL  
Ramp F 10+00 RL  
Ramp G 5+40 RL  
Ramp G 17+5-17+15 RL

\* BITUMINOUS CONCRETE CURB  
ITEM 555  
Ramp H 13+00-14+28 RL

Not part of  
Project I 91-1(3)

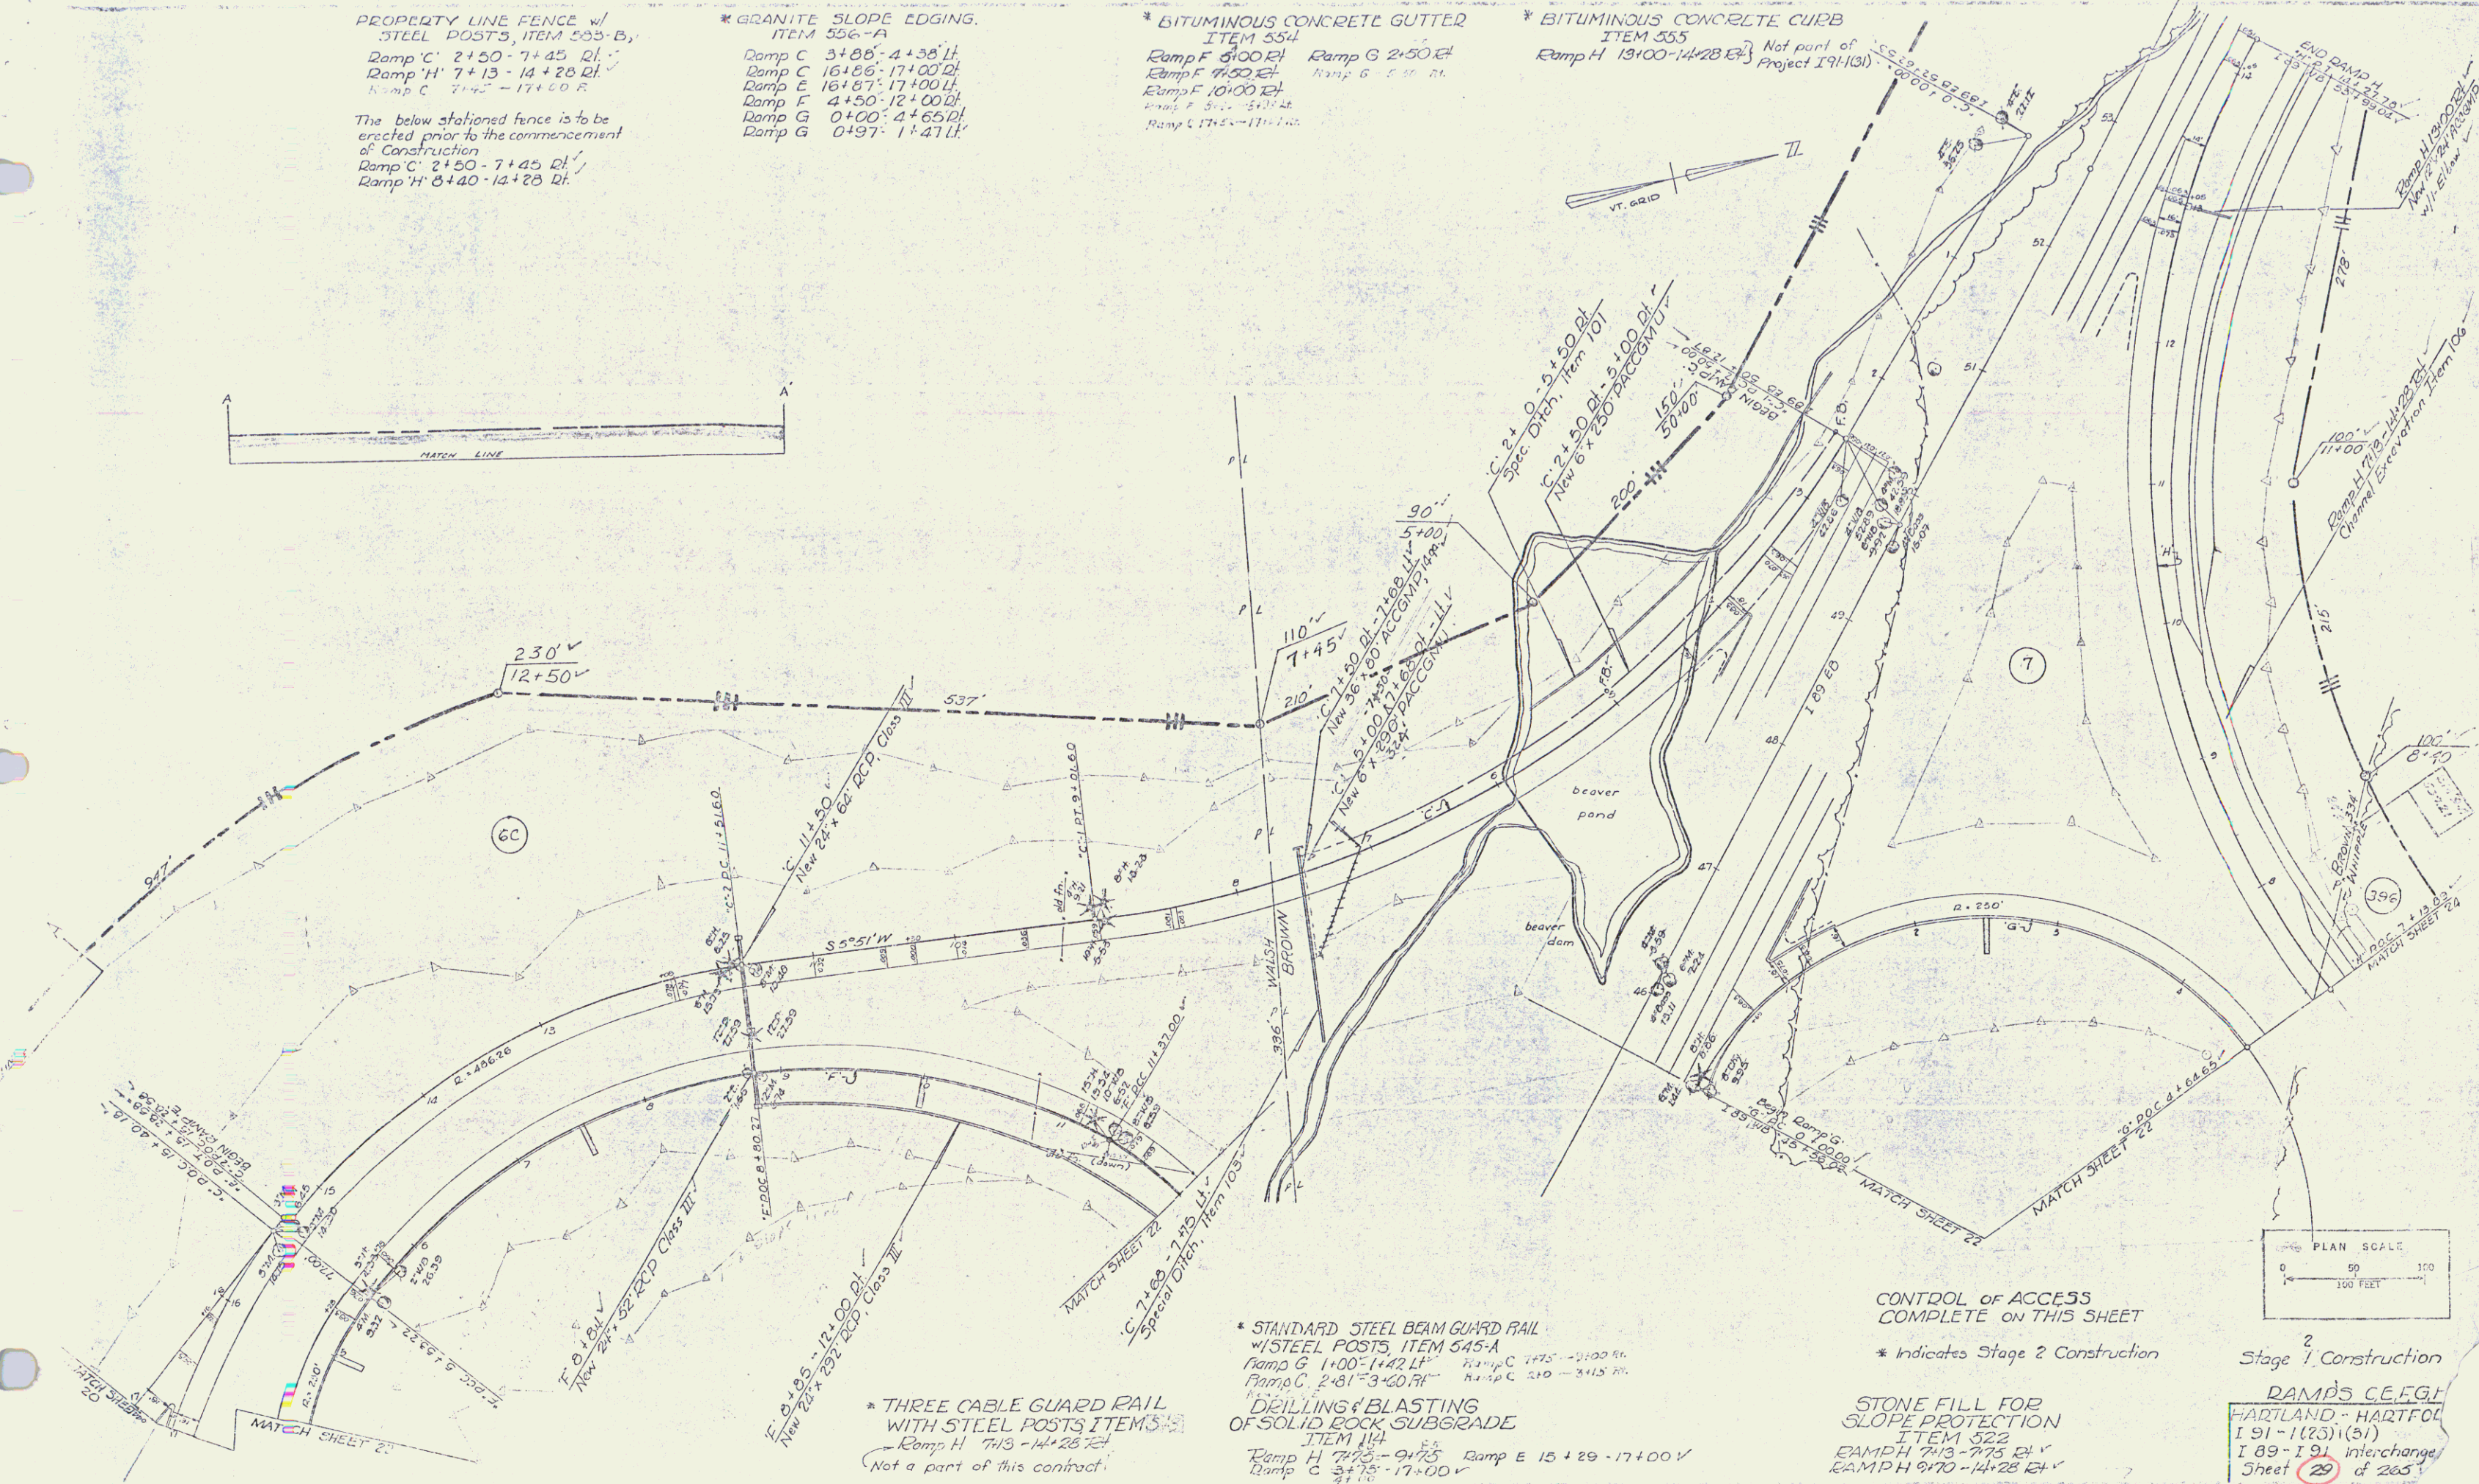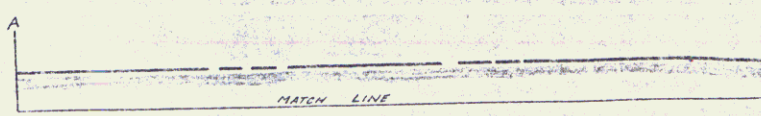


\* THREE CABLE GUARD RAIL  
WITH STEEL POSTS ITEM 545-A  
Ramp H 7+13-14+28 RL  
Not a part of this contract.

\* STANDARD STEEL BEAM GUARD RAIL  
WITH STEEL POSTS, ITEM 545-A  
Ramp G 1+00-1+42 RL  
Ramp C 2+81-3+40 RL  
DRILLING & BLASTING  
OF SOLID ROCK SUBGRADE  
ITEM 114  
Ramp H 7+13-9+75  
Ramp C 3+15-17+00 RL  
Ramp E 15+29-17+00 RL

CONTROL OF ACCESS  
COMPLETE ON THIS SHEET

\* Indicates Stage 2 Construction

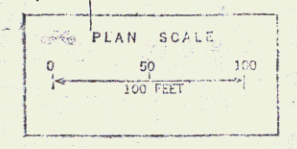

Stage 2 Construction  
DAMPS CE, E, G, I  
HARTLAND - HARTFOL  
I 91-1(23)(21)  
I 89-I 91 interchange  
Sheet 29 of 265  
Sheet 12 of 242

61