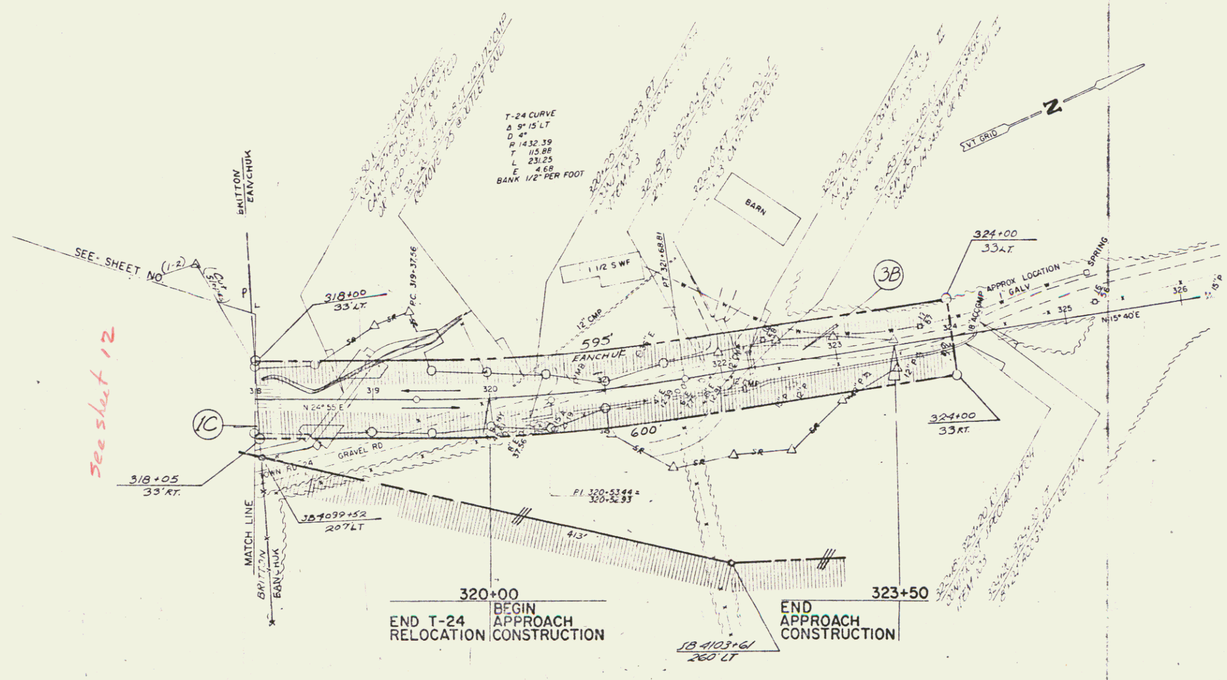

CONSTRUCT DRIVE	
STATION	POS
T-24 RELOCATION	
322+65	LT
322+00	RT
322+05	LT

STATE OF VERMONT
DEPARTMENT OF HIGHWAYS

INTERSTATE PROJECT in the towns of
NORWICH-THETFORD
TOWN HIGHWAY NO 24 RELOCATION

PLAN

STA 316+00 TO 326+00

WEBSTER-MARTIN, INC.
CONSULTING ENGINEERS
SO. BURLINGTON, VT.

SURVEYED BY	W-M, INC	CHECKED BY	AVM
DRAWN BY	HCM	IN CHARGE	RES
SCALE AS SHOWN		DATE 6/75	

PROJECT NO I 91-2 (13) SHEET 16 OF 55

15

10