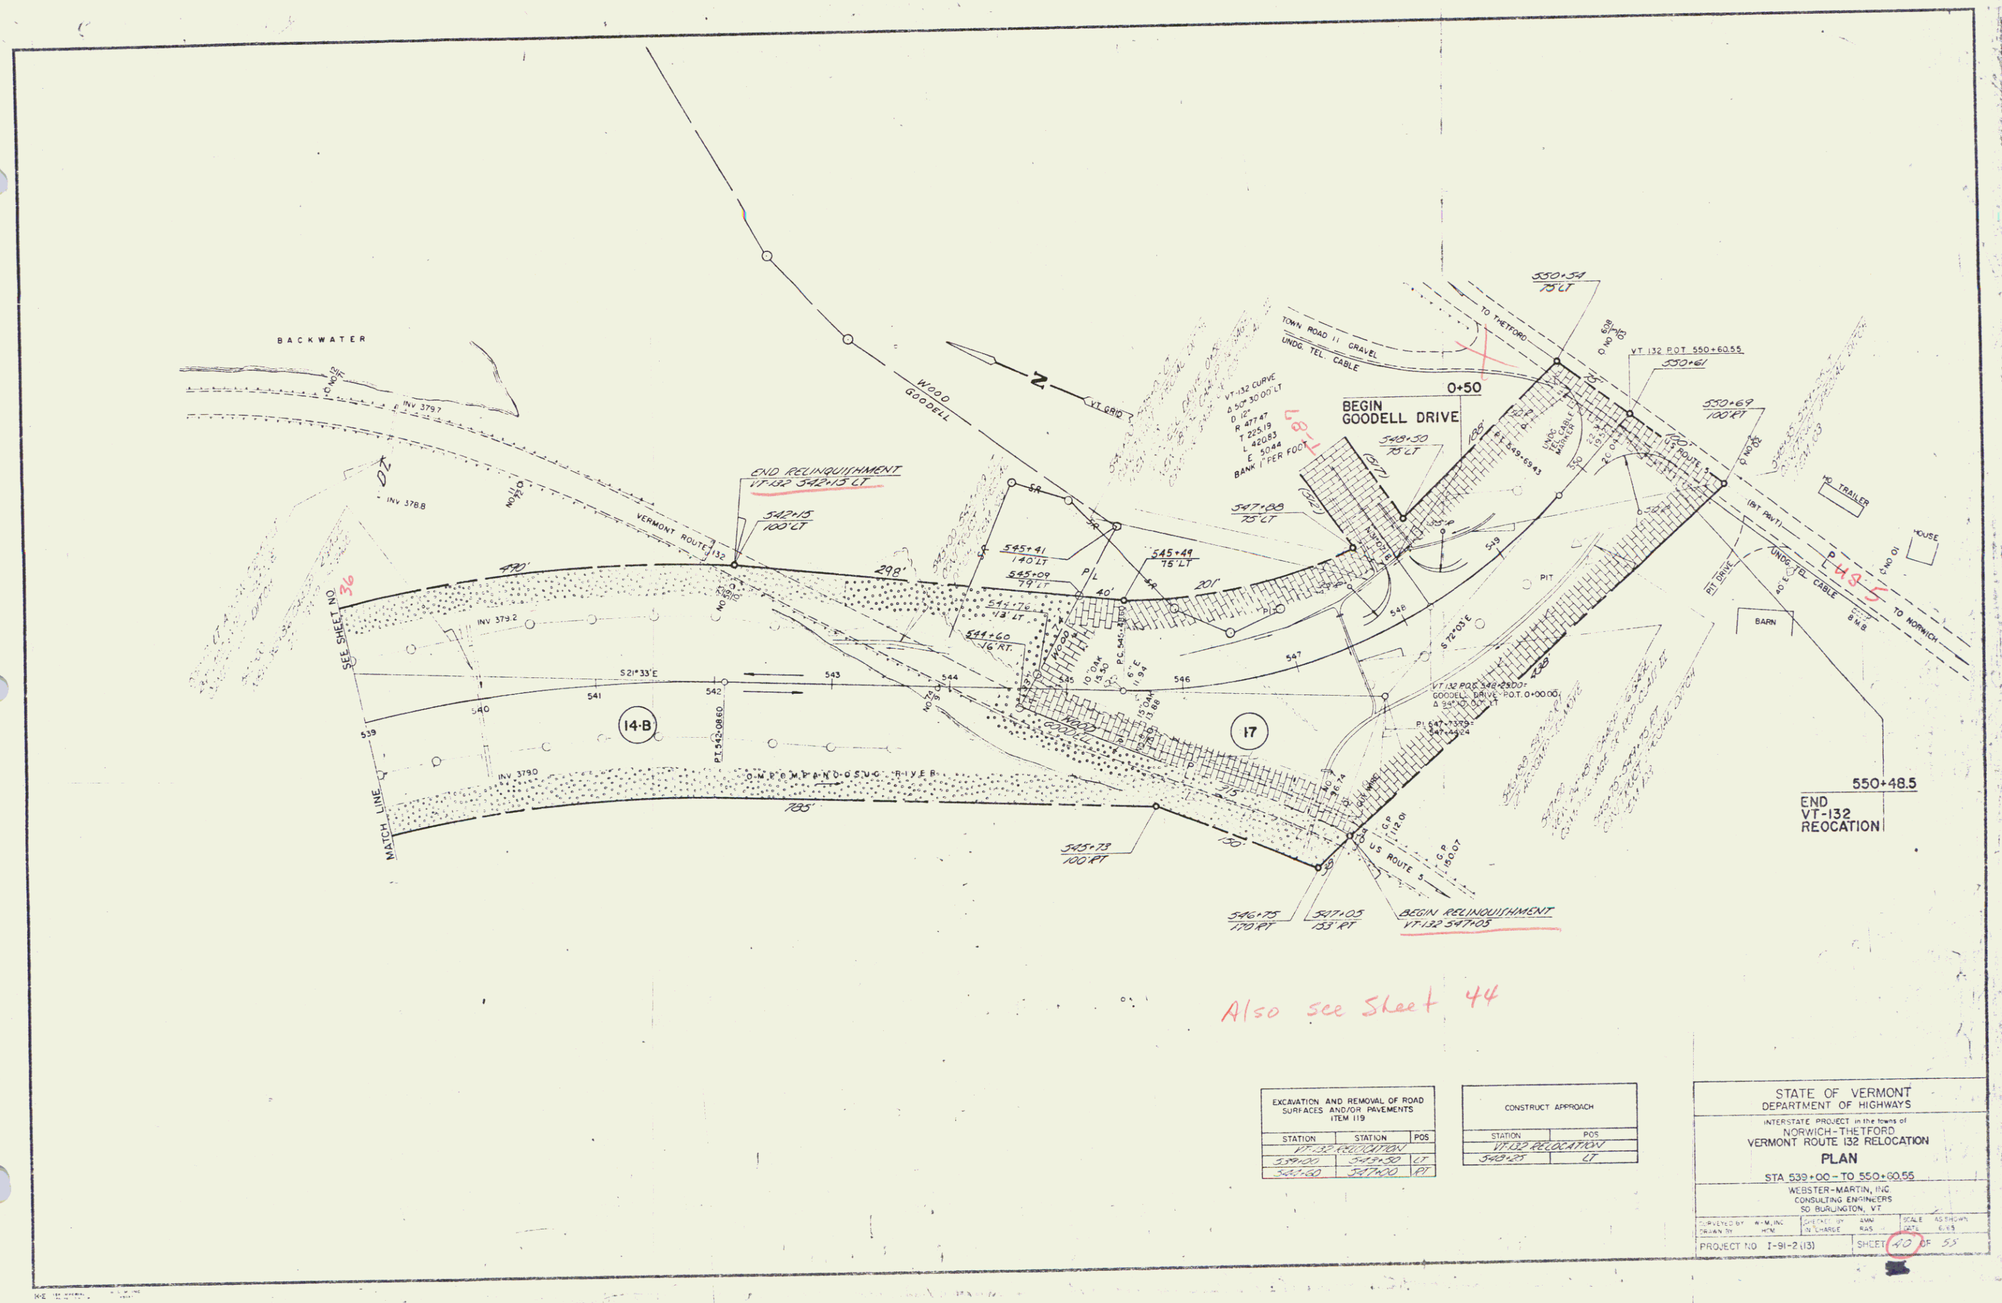

EXCAVATION AND REMOVAL OF ROAD SURFACES AND/OR PAVEMENTS ITEM 119		
STATION	STATION	POS
VT-132 RELOCATION		
539+00	549+50	LT
549+50	547+00	RT

CONSTRUCT APPROACH	
STATION	POS
VT-132 RELOCATION	
549+25	LT

STATE OF VERMONT
DEPARTMENT OF HIGHWAYS

INTERSTATE PROJECT in the towns of
NORWICH-THETFORD
VERMONT ROUTE 132 RELOCATION

PLAN

STA 539+00 - TO 550+60.55

WEBSTER-MARTIN, INC
CONSULTING ENGINEERS
SO. BURLINGTON, VT

COMPUTED BY R.M. INC	CHECKED BY SMW	SCALE AS SHOWN	
DRAWN BY HTW	IN CHARGE RAS	DATE 6-83	

PROJECT NO I-91-2 (13) SHEET 40 OF 53

23