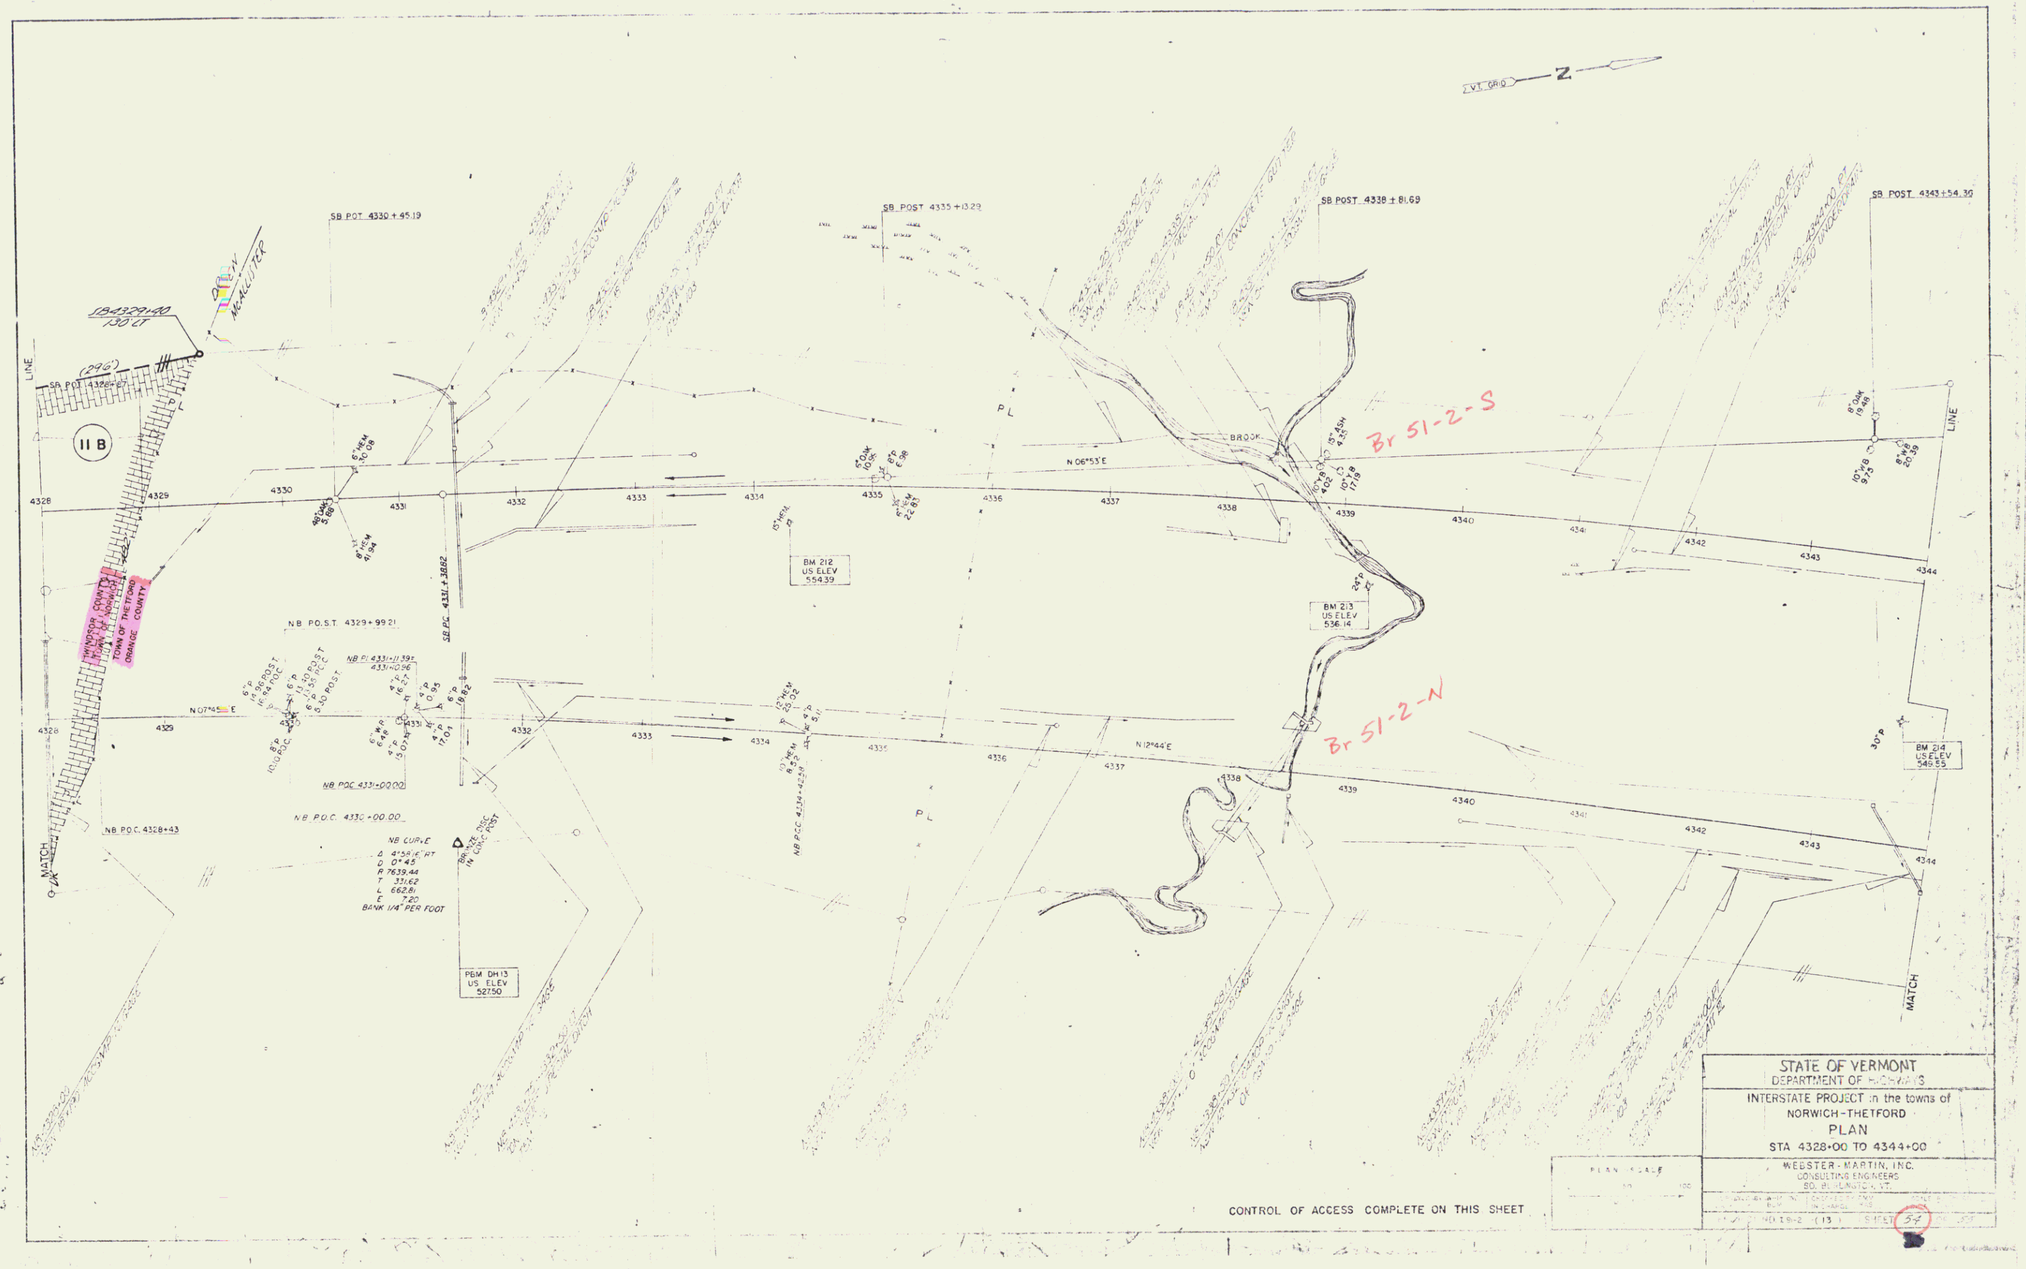
VT. GRID
N
SB POST 4330+45.19
SB POST 4335+13.29
SB POST 4338+81.69
SB POST 4343+54.30
IB4329+20
130 LT
McALLISTER
II B
WINDSOR COUNTY
TOWN OF NORWICH
TOWN OF THETFORD
ORANGE COUNTY
Br 51-2-S
Br 51-2-N
BROOK
N 06°53'E
N 07°45'E
N 12°44'E
BM 212
US ELEV
554.39
BM 213
US ELEV
536.14
BM 214
US ELEV
546.55
PBM DH13
US ELEV
527.50
NB P.O.S.T 4329+99.21
NB P.O.C. 4328+43
NB POC 4331+00.00
NB P.O.C. 4330+00.00
NB CURVE
Δ 4°54'6" RT
D 0°45'
R 7639.44
BANK 1/4" PER FOOT
MATCH
CONTROL OF ACCESS COMPLETE ON THIS SHEET
STATE OF VERMONT
DEPARTMENT OF HIGHWAYS
INTERSTATE PROJECT in the towns of
NORWICH-THETFORD
PLAN
STA 4328+00 TO 4344+00
WEBSTER-MARTIN, INC.
CONSULTING ENGINEERS
SHEET 54

30