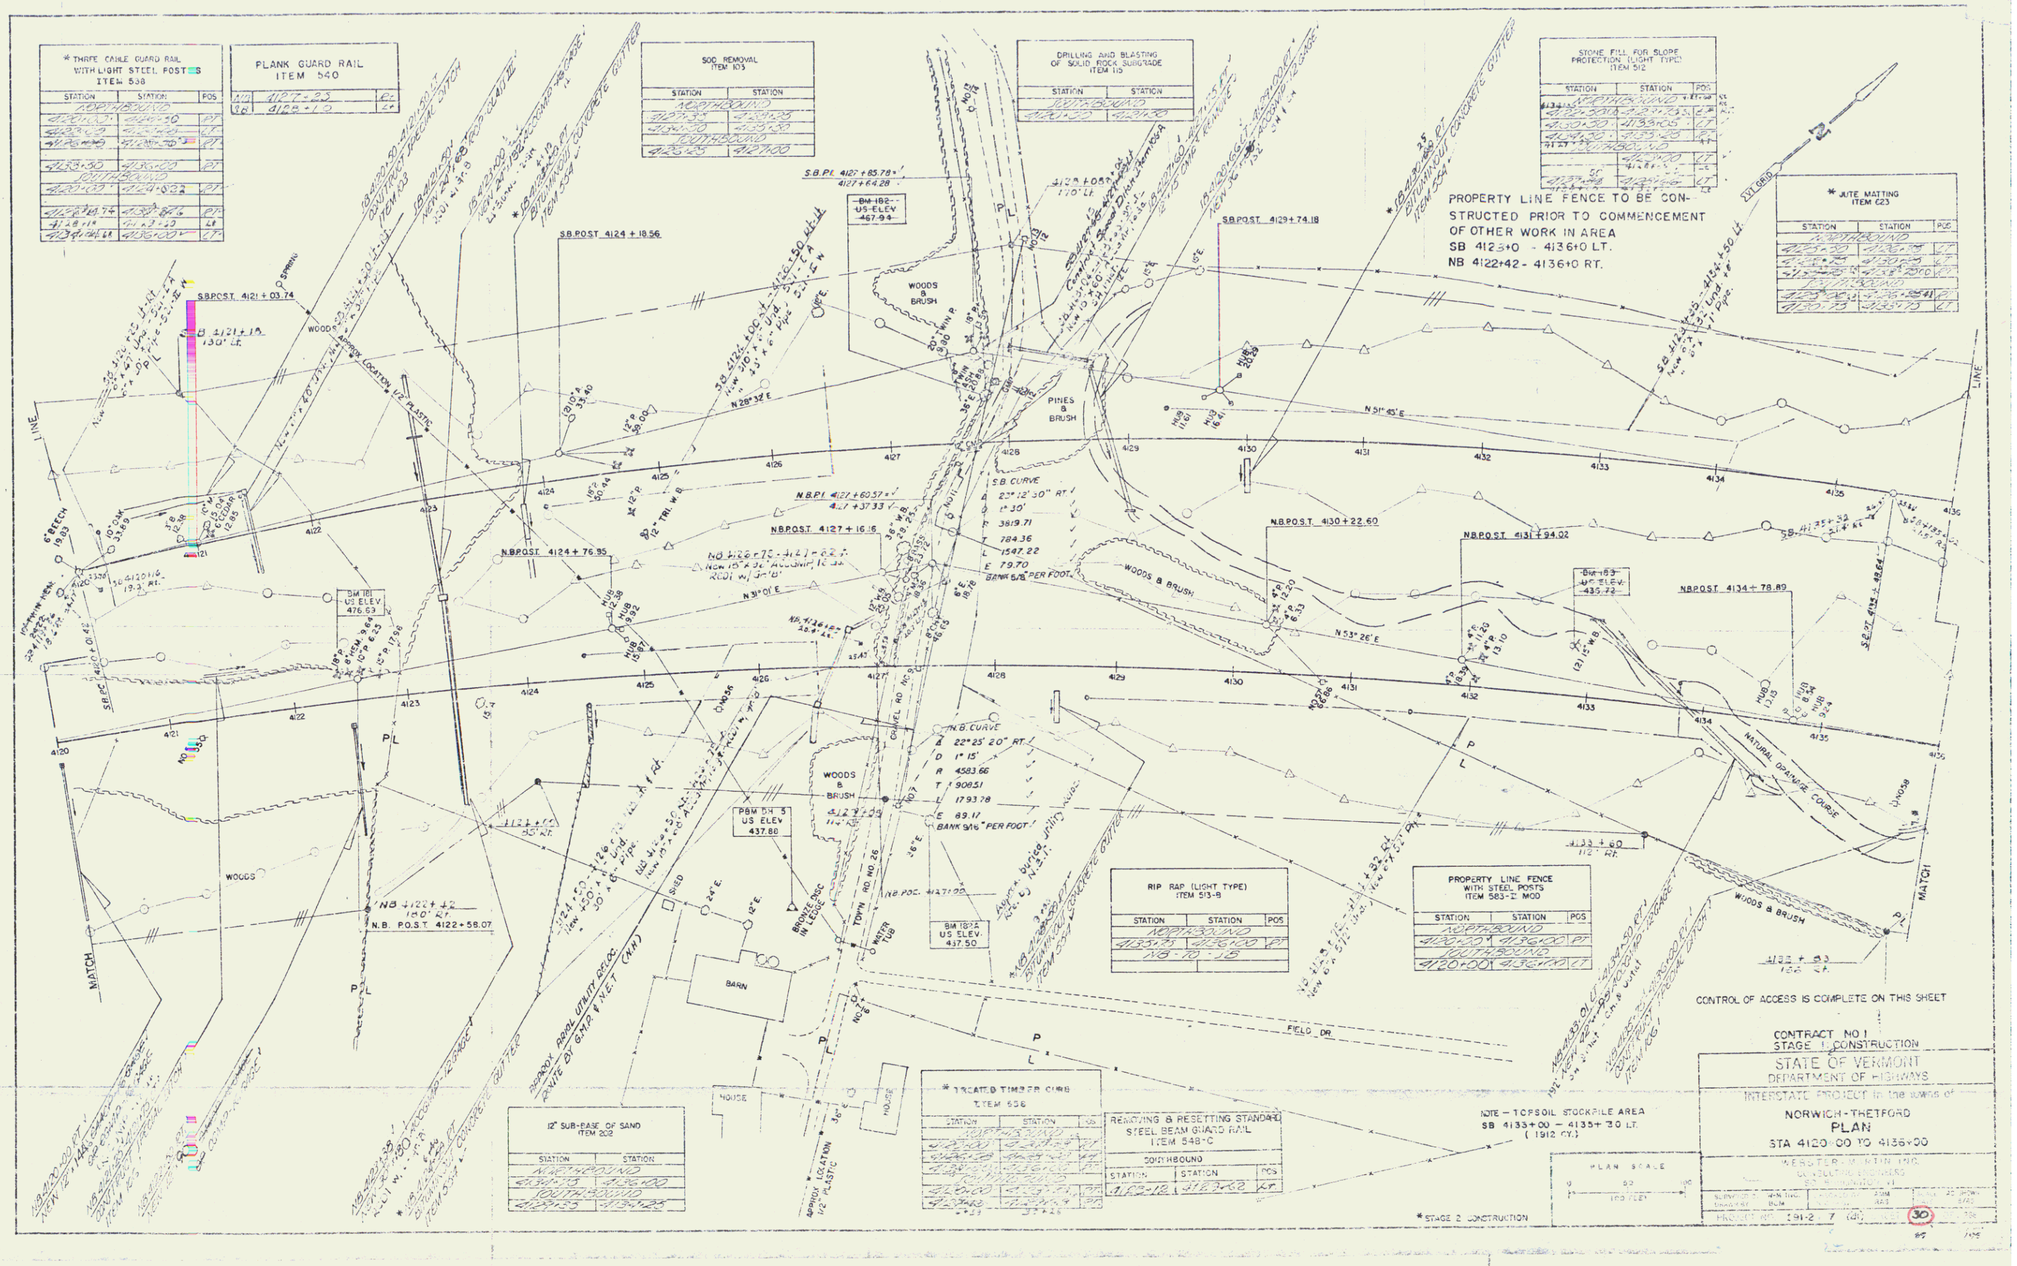
* THREE CABLE GUARD RAIL WITH LIGHT STEEL POSTS ITEM 538
PLANK GUARD RAIL ITEM 540
SOD REMOVAL ITEM 103
DRILLING AND BLASTING OF SOLID ROCK SUBGRADE ITEM 110
STONE FILL FOR SLOPE PROTECTION (LIGHT TYPE) ITEM 512
* JUTE MATTING ITEM 623
PROPERTY LINE FENCE TO BE CONSTRUCTED PRIOR TO COMMENCEMENT OF OTHER WORK IN AREA
SB 4123+0 - 4136+0 LT.
NB 4122+42 - 4136+0 RT.
RIP RAP (LIGHT TYPE) ITEM 513-B
PROPERTY LINE FENCE WITH STEEL POSTS ITEM 583-2 MOD
12" SUB-BASE OF SAND ITEM 202
* TREATED TIMBER CURB ITEM 656
REMOVING & RESETTING STANDARD STEEL BEAM GUARD RAIL ITEM 548-C
CONTROL OF ACCESS IS COMPLETE ON THIS SHEET
NOTE - TOPSOIL STOCKPILE AREA SB 4133+00 - 4135+30 LT. (1912 CY.)
* STAGE 2 CONSTRUCTION
CONTRACT NO. 1
STAGE 1 CONSTRUCTION
STATE OF VERMONT
DEPARTMENT OF HIGHWAYS
INTERSTATE PROJECT in the towns of
NORWICH - THETFORD
PLAN
STA 4120+00 TO 4136+00
WEBSTER-WATKINS INC.
CONSULTING ENGINEERS
ST. JOHNSBURY, VT.
PROJECT NO. I91-2 7 (3)
30
WOODS & BRUSH
PINES & BRUSH
BARN
HOUSE
FIELD DR.
NATURAL DRAINAGE COURSE
MATCH LINE
S.B. CURVE
N.B. CURVE
PLAN SCALE
0 50 100
(FEET)

63