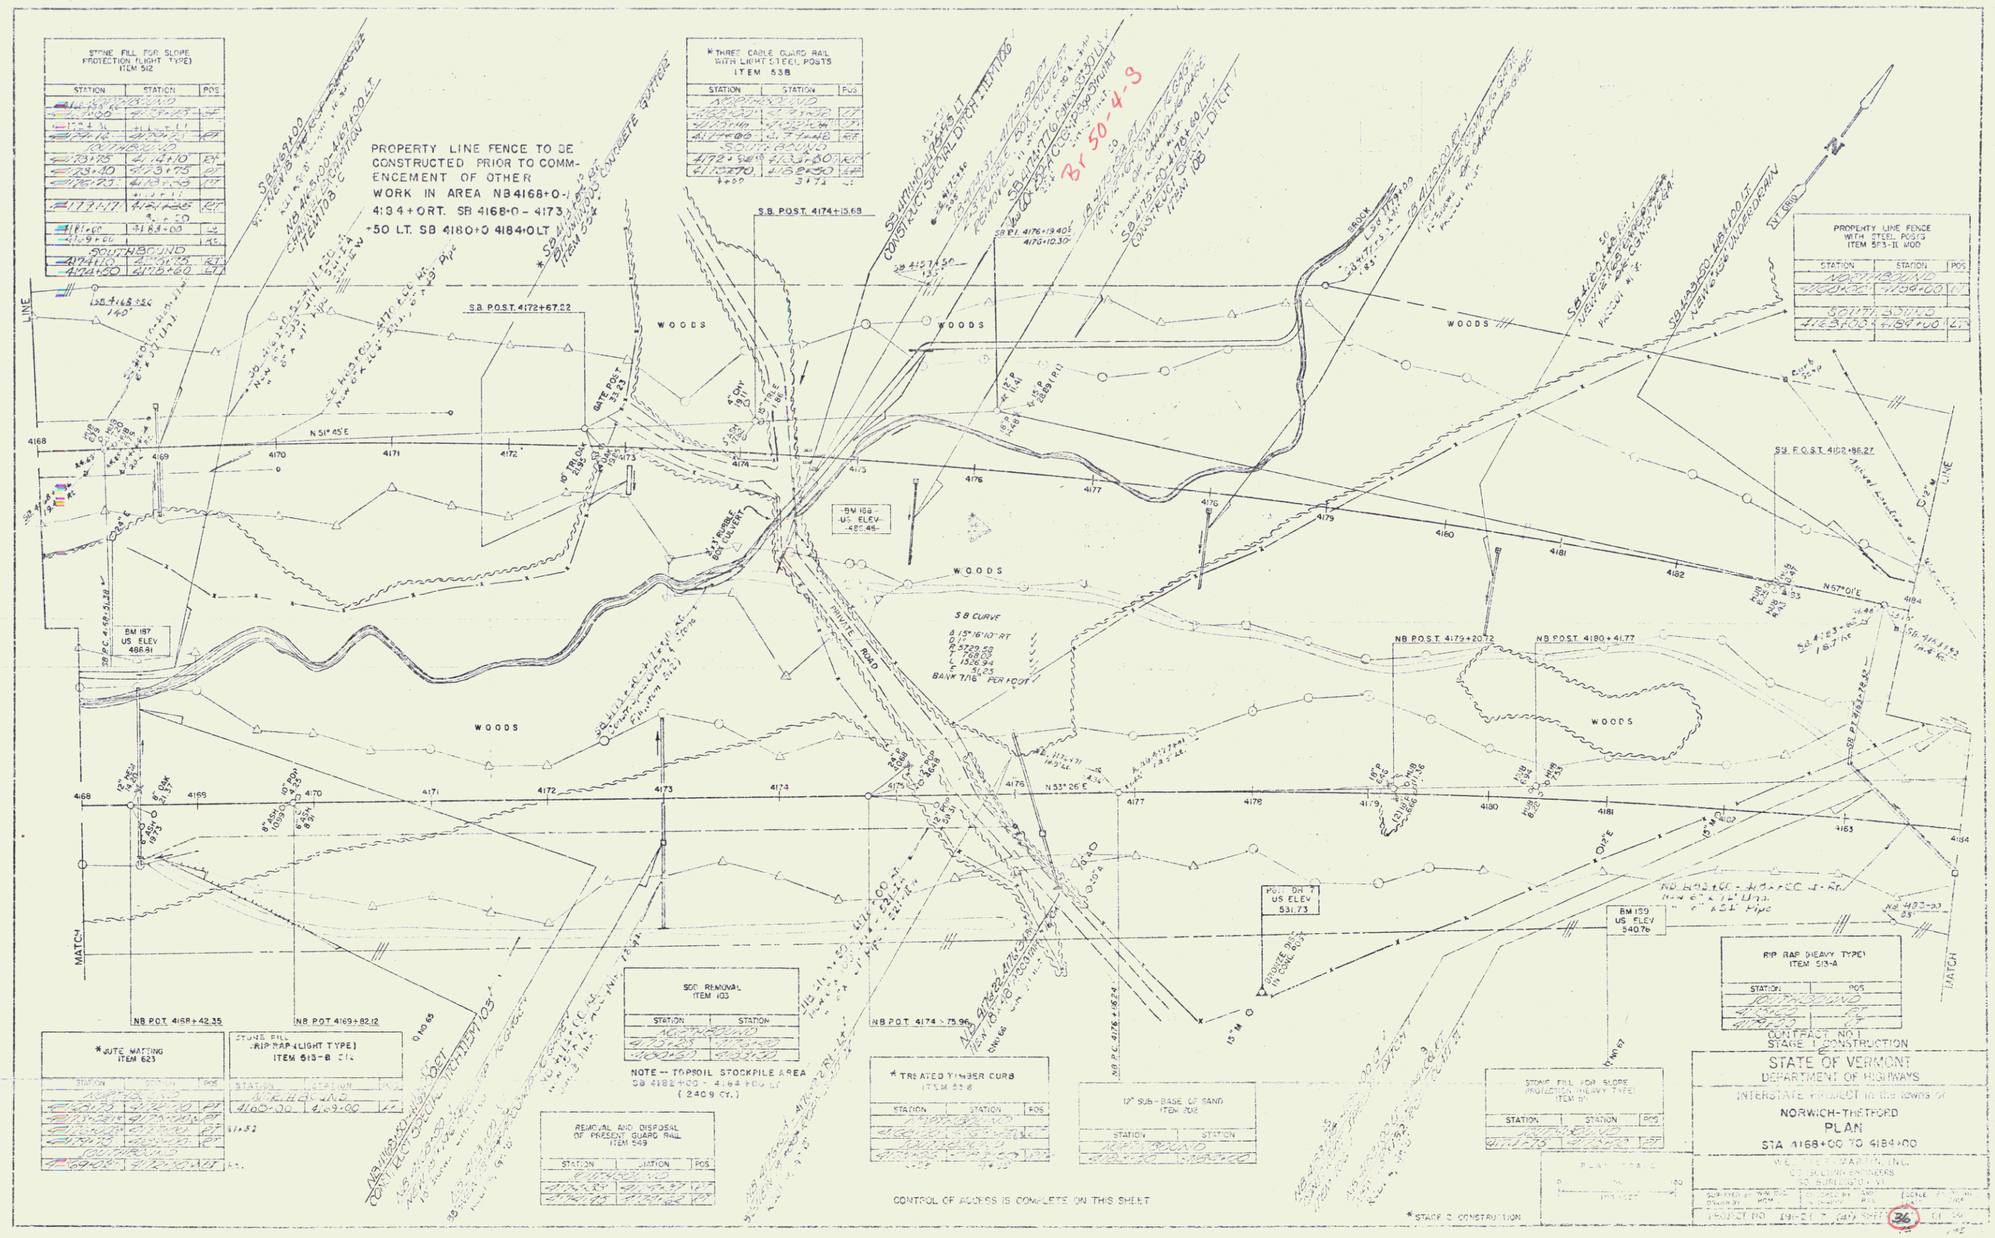
PROPERTY LINE FENCE TO BE CONSTRUCTED PRIOR TO COMMENCEMENT OF OTHER WORK IN AREA NB4168+0-4184+ORT. SB 4168+0 - 4173+50 LT. SB 4180+0 4184+0LT
STONE FILL FOR SLOPE PROTECTION (LIGHT TYPE) ITEM 512
THREE CABLE GUARD RAIL WITH LIGHT STEEL POSTS ITEM 538
PROPERTY LINE FENCE WITH STEEL POSTS ITEM 573-11.100
RIP RAP (HEAVY TYPE) ITEM 513-A
*JUTE MATTING ITEM 623
STONE FILL FOR RIP-RAP (LIGHT TYPE) ITEM 613-B 014
SOD REMOVAL ITEM 103
NOTE -- TOPSOIL STOCKPILE AREA
REMOVAL AND DISPOSAL OF PRESENT GUARD RAIL ITEM 569
*TREATED TIMBER CURB ITEM 556
12" SUB-BASE OF SAND ITEM 208
CONTROL OF ACCESS IS COMPLETE ON THIS SHEET
*STAGE 2 CONSTRUCTION
CONTRACT NO.1
STAGE 1 CONSTRUCTION
STATE OF VERMONT
DEPARTMENT OF HIGHWAYS
INTERSTATE PROJECT IN THE TOWNS OF
NORWICH-THETFORD
PLAN
STA 4168+00 TO 4184+00
WILSON, WARNER & HILL
CONSULTING ENGINEERS
BURLINGTON, VT.
PROJECT NO. I-91-2-1 (24) STEP 1
36
66