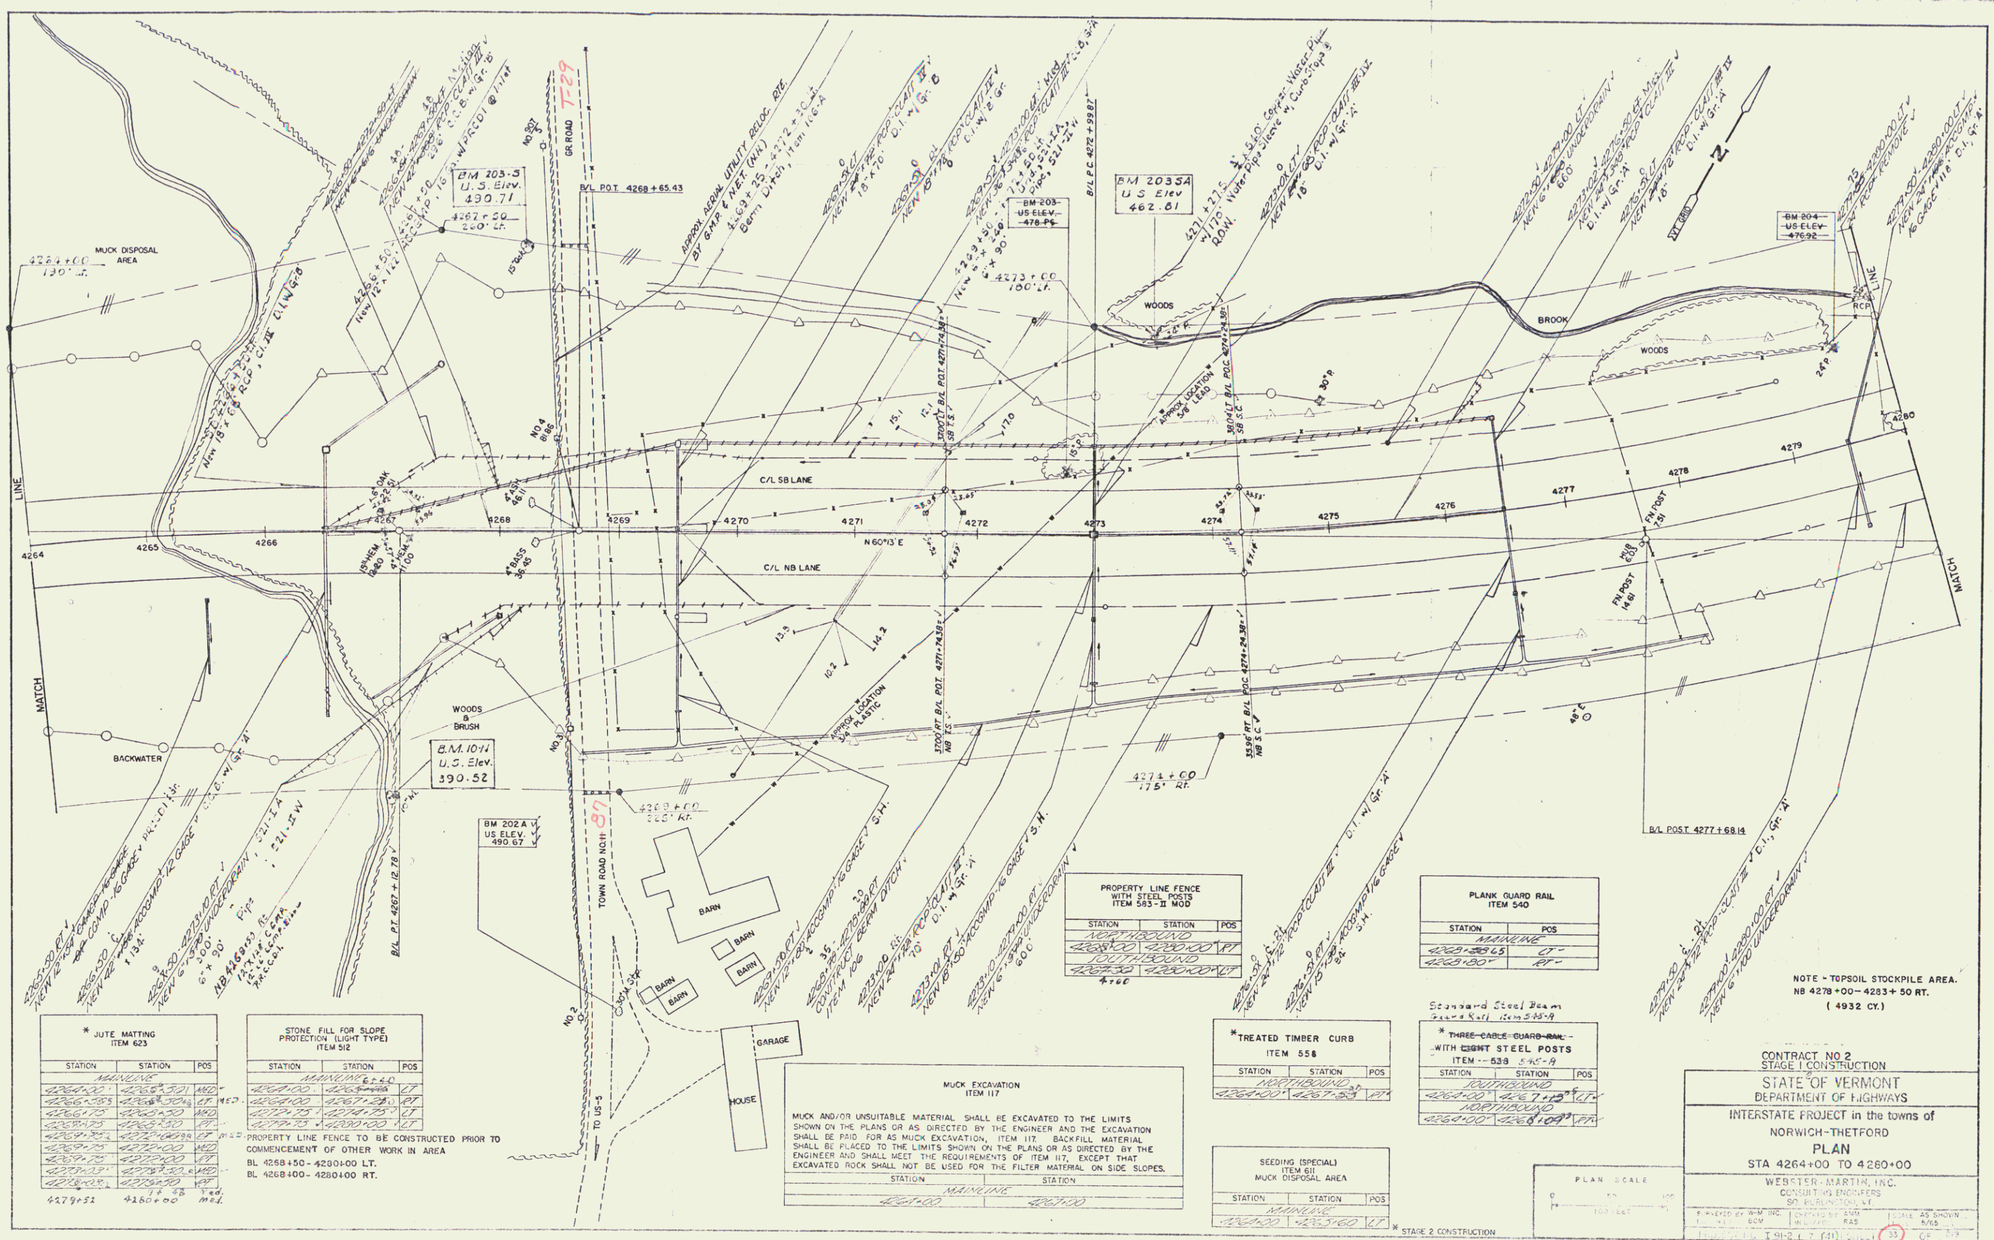
MUCK DISPOSAL AREA
BM 203-3 U.S. Elev. 490.71
BM 203A U S Elev 462.61
BM 204 US ELEV 476.92
B.M. 1014 U.S. Elev. 390.52
BM 202A U US ELEV. 490.67
GR. ROAD
B/L POT 4268+65.43
B/L PC 4272+99.81
WOODS
BROOK
C/L SB LANE
C/L NB LANE
N 60°13' E
BACKWATER
WOODS & BRUSH
BARN
GARAGE
HOUSE
TOWN ROAD NO. 11
TO US-5
B/L POST 4277+68.14
MATCH LINE
NOTE - TOPSOIL STOCKPILE AREA. NB 4278+00 - 4283+50 RT. (4932 CY.)
PROPERTY LINE FENCE WITH STEEL POSTS ITEM 583-2 MOD
PLANK GUARD RAIL ITEM 540
* JUTE MATTING ITEM 623
STONE FILL FOR SLOPE PROTECTION (LIGHT TYPE) ITEM 512
PROPERTY LINE FENCE TO BE CONSTRUCTED PRIOR TO COMMENCEMENT OF OTHER WORK IN AREA
BL 4268+50 - 4280+00 LT.
BL 4268+00 - 4280+00 RT.
MUCK EXCAVATION ITEM 117
MUCK AND/OR UNSUITABLE MATERIAL SHALL BE EXCAVATED TO THE LIMITS SHOWN ON THE PLANS OR AS DIRECTED BY THE ENGINEER AND THE EXCAVATION SHALL BE PAID FOR AS MUCK EXCAVATION, ITEM 117. BACKFILL MATERIAL SHALL BE PLACED TO THE LIMITS SHOWN ON THE PLANS OR AS DIRECTED BY THE ENGINEER AND SHALL MEET THE REQUIREMENTS OF ITEM 117, EXCEPT THAT EXCAVATED ROCK SHALL NOT BE USED FOR THE FILTER MATERIAL ON SIDE SLOPES.
* TREATED TIMBER CURB ITEM 558
SEEDING (SPECIAL) ITEM 611 MUCK DISPOSAL AREA
* STAGE 2 CONSTRUCTION
Standard Steel Beam Guard Rail Item 538-9
* THREE-CABLE GUARD RAIL WITH EIGHT STEEL POSTS ITEM 538
PLAN SCALE
CONTRACT NO. 2
STAGE 1 CONSTRUCTION
STATE OF VERMONT
DEPARTMENT OF HIGHWAYS
INTERSTATE PROJECT in the towns of
NORWICH-THETFORD
PLAN
STA 4264+00 TO 4280+00
WEBSTER-MARTIN, INC.
CONSULTING ENGINEERS
SCALE AS SHOWN
5/65