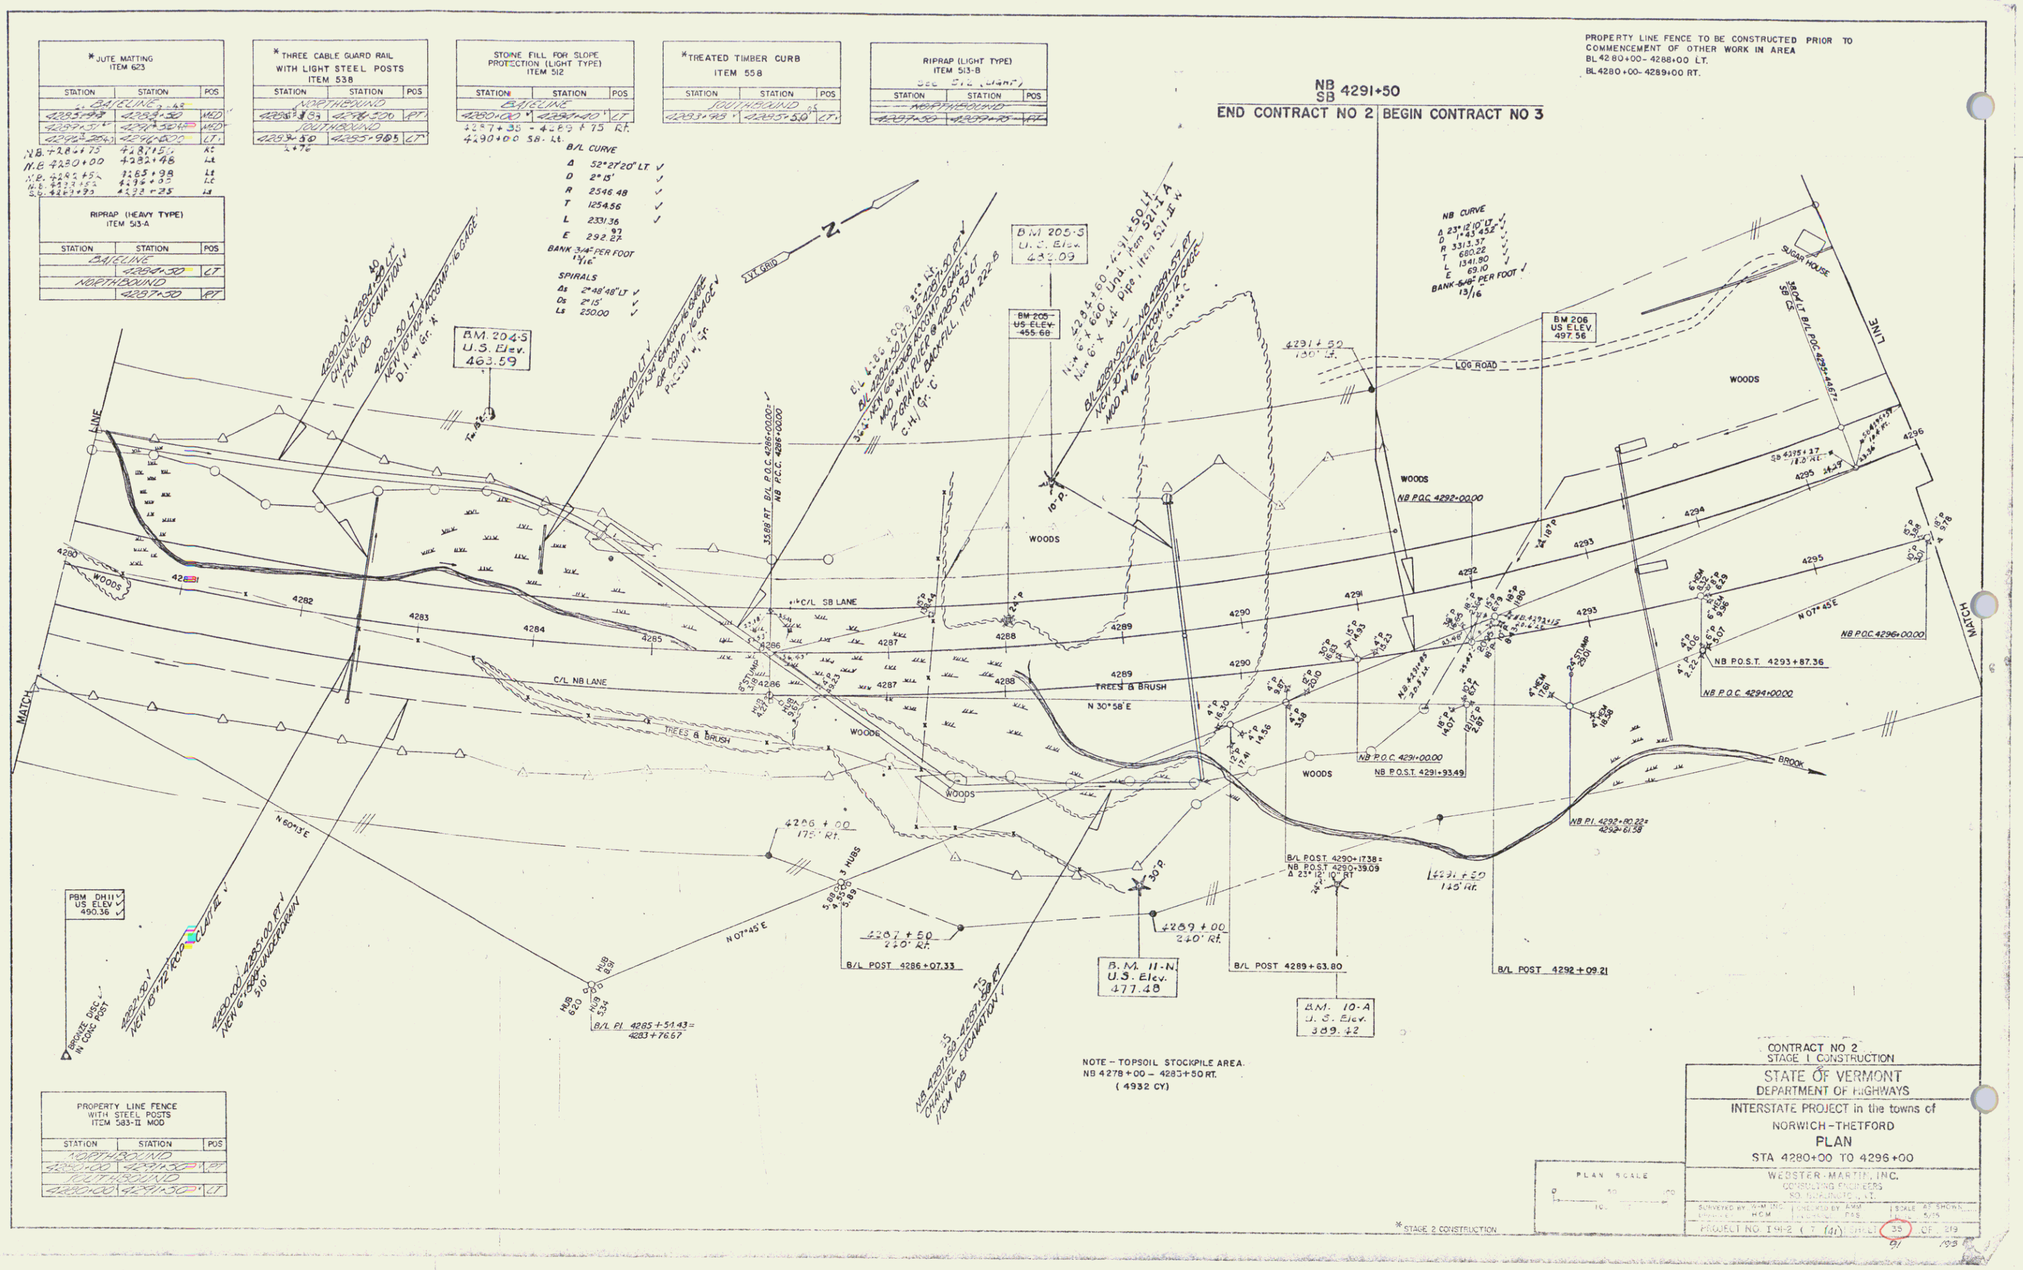
NB
SB 4291+50
END CONTRACT NO 2 | BEGIN CONTRACT NO 3
PROPERTY LINE FENCE TO BE CONSTRUCTED PRIOR TO COMMENCEMENT OF OTHER WORK IN AREA
BL 4280+00 - 4288+00 LT.
BL 4280+00 - 4289+00 RT.
* JUTE MATTING ITEM 623
* THREE CABLE GUARD RAIL WITH LIGHT STEEL POSTS ITEM 538
STONE FILL FOR SLOPE PROTECTION (LIGHT TYPE) ITEM 512
* TREATED TIMBER CURB ITEM 558
RIPRAP (LIGHT TYPE) ITEM 513-B
RIPRAP (HEAVY TYPE) ITEM 513-A
B/L CURVE
Δ 52°27'20" LT
D 2°15'
R 2546.48
T 1254.56
L 2331.36
E 292.27
BANK 3/4:1 PER FOOT 13/16
SPIRALS
As 2°48'48" LT
Ds 2°15'
Ls 230.00
NB CURVE
Δ 23°12'10" LT
D 1°43'52"
R 3313.37
T 680.22
L 1341.80
E 69.10
BANK 5/4:1 PER FOOT 13/16
B.M. 204-S U.S. Elev. 463.59
B.M. 205-S U.S. Elev. 442.09
BM 205 US ELEV. 455.66
B.M. 206 US ELEV. 497.56
B.M. 11-N U.S. Elev. 477.48
B.M. 10-A U.S. Elev. 389.42
PBM DH11 US ELEV 490.36
BROOK
LOG ROAD
SUGAR HOUSE
WOODS
TREES & BRUSH
C/L SB LANE
C/L NB LANE
N 30°58' E
N 60°45' E
N 07°45' E
N 07°45' E
MATCH LINE
NB P.O.C. 4292+00.00
NB P.O.C. 4294+00.00
NB P.O.C. 4296+00.00
NB P.O.S.T. 4293+87.36
NB P.O.C. 4291+00.00
NB P.O.S.T. 4291+93.49
B/L POST 4286+07.33
B/L POST 4289+63.80
B/L POST 4292+09.21
B/L PI 4285+54.43 = 4283+76.57
4286+00 175' Rt.
4287+50 220' Rt.
4289+00 220' Rt.
4291+50 145' Rt.
4291+50 130' Lt.
NOTE - TOPSOIL STOCKPILE AREA.
NB 4278+00 - 4285+50 RT.
(4932 CY)
PROPERTY LINE FENCE WITH STEEL POSTS ITEM 543-B MOD
* STAGE 2 CONSTRUCTION
PLAN SCALE
CONTRACT NO 2
STAGE 1 CONSTRUCTION
STATE OF VERMONT
DEPARTMENT OF HIGHWAYS
INTERSTATE PROJECT in the towns of
NORWICH - THETFORD
PLAN
STA 4280+00 TO 4296+00
WEBSTER-MARTIN, INC.
CONSULTING ENGINEERS
SURVEYED BY KWP
DESIGNED BY KWP
DRAWN HCM
CHECKED POB
SCALE AS SHOWN
DATE 5/75
PROJECT NO. I 91-2 (7) (31) SHEET 35 OF 319
91
103

79