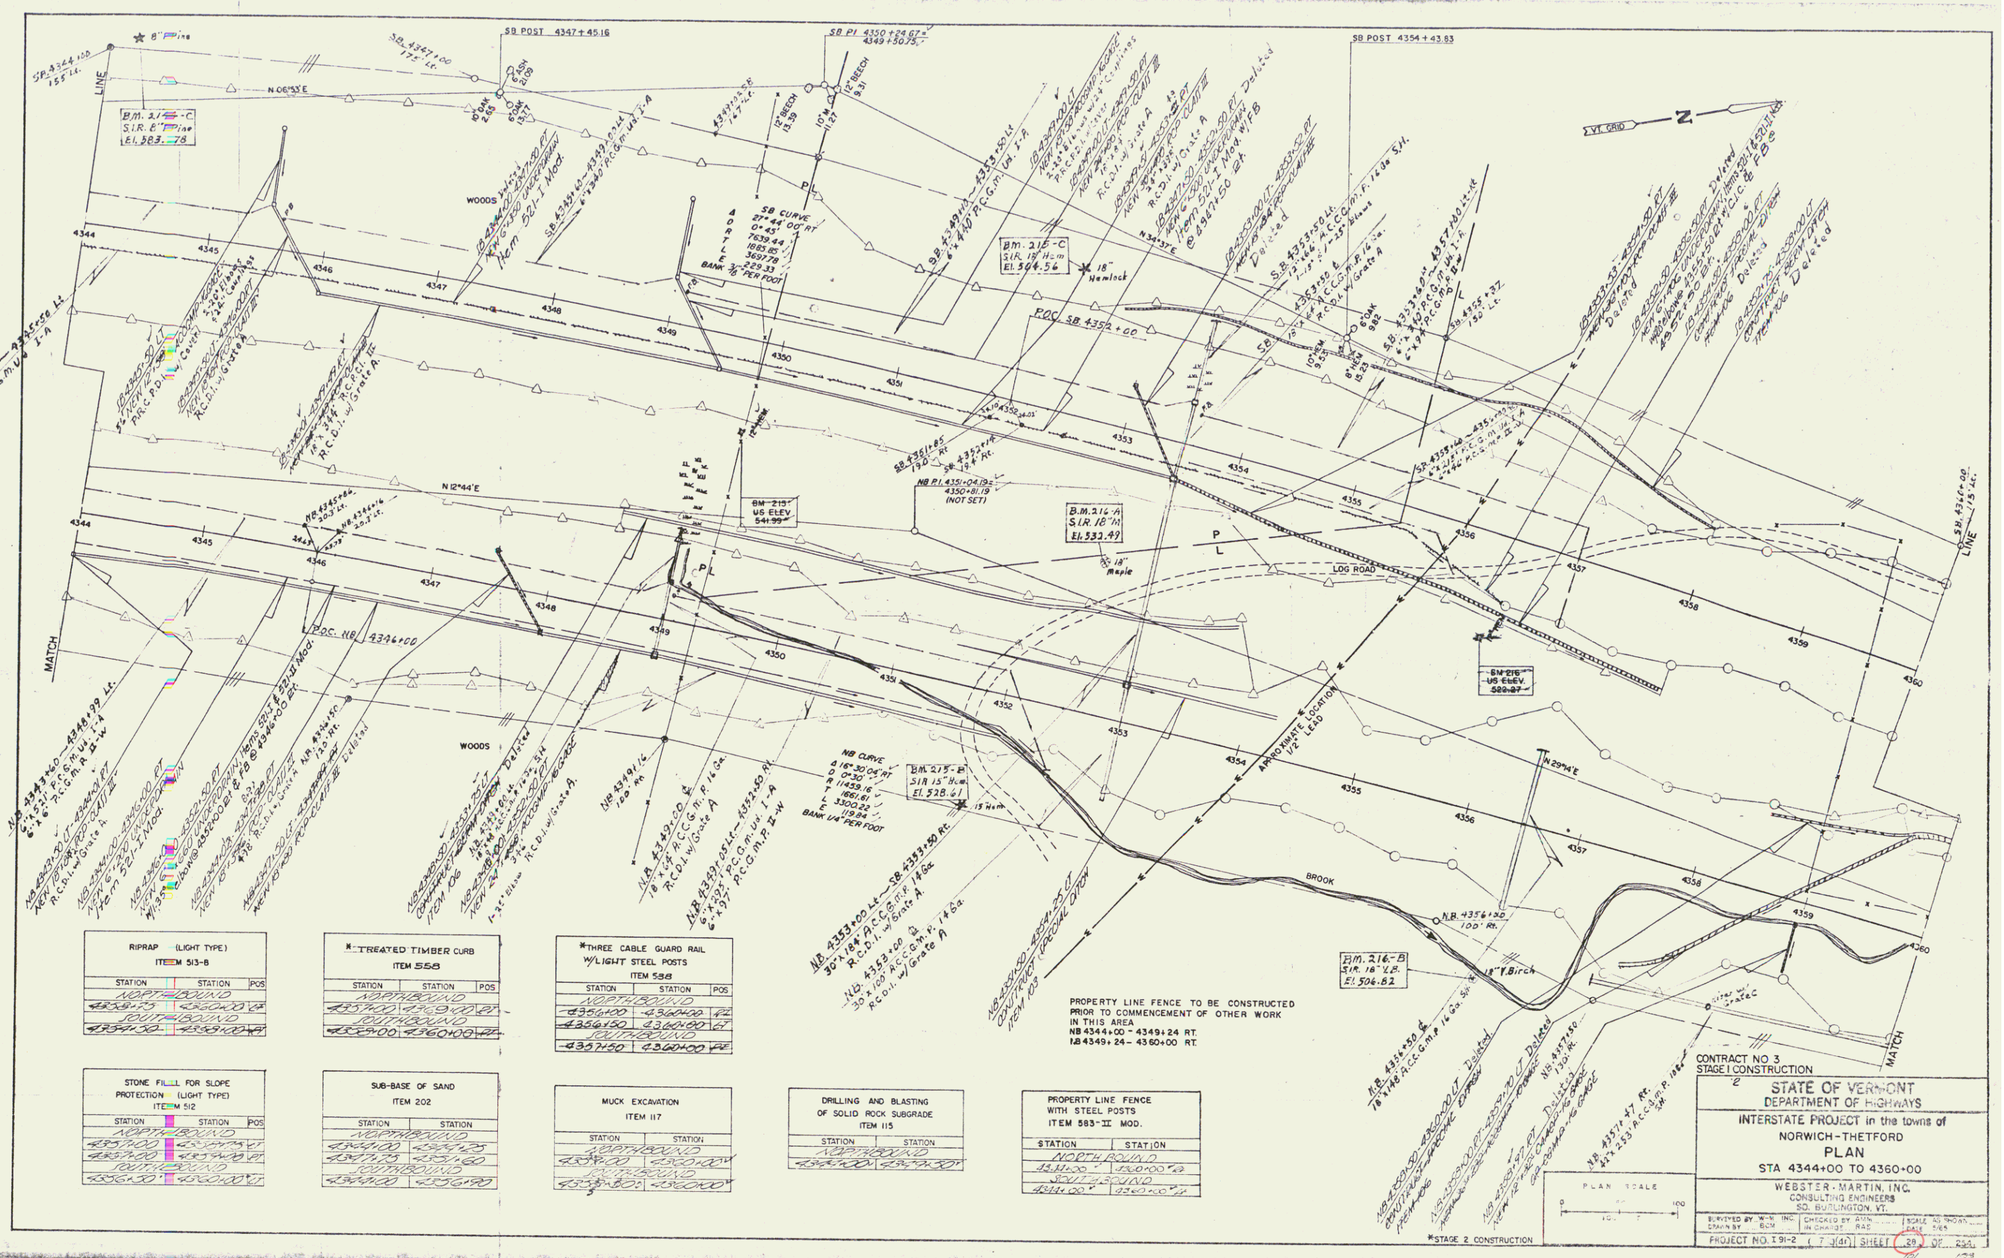
SB POST 4347+45.16
SB PI 4350+24.67
SB POST 4354+43.83
B.M. 215-C
S.I.R. 8" Pine
El. 583.78
B.M. 215-C
S.I.R. 18" Hemlock
El. 504.56
18" Hemlock
P.O.C. SB 4352+00
BM 215
US ELEV.
541.99
NB PI. 4351+04.82
4350+81.19
(NOT SET)
B.M. 216-A
S.I.R. 18" Ash
El. 532.49
18" Maple
LOG ROAD
BM 216
US ELEV.
520.87
P.O.C. NB 4346+00
NB CURVE
D 16°30'05" RT.
L 3350.32
BANK 1/4" PER FOOT
B.M. 215-B
S.I.R. 15" Hem.
El. 528.61
15" Hem.
APPROXIMATE LOCATION
1/2 E.O.
BROOK
N.B. 4356+30
100' Rt.
B.M. 216-B
S.I.R. 18" Yl. Birch
El. 506.82
18" Yl. Birch
WOODS
MATCH
LINE
N 06°53'E
N 12°44'E
N 29°34'E
N 34°37'E
Z
VT. GRID
PROPERTY LINE FENCE TO BE CONSTRUCTED
PRIOR TO COMMENCEMENT OF OTHER WORK
IN THIS AREA
NB 4344+00 - 4349+24 RT.
LB 4349+24 - 4360+00 RT.
RIPRAP (LIGHT TYPE)
ITEM 513-B
STATION | STATION | POS
NORTHBOUND
4338+75 | 4350+00 RT
SOUTHBOUND
4354+50 | 4359+00 RT
*TREATED TIMBER CURB
ITEM 558
STATION | STATION | POS
NORTHBOUND
4357+00 | 4359+00 RT
SOUTHBOUND
4355+00 | 4360+00 RT
*THREE CABLE GUARD RAIL
W/LIGHT STEEL POSTS
ITEM 588
STATION | STATION | POS
NORTHBOUND
4356+00 | 4360+00 RT
4356+50 | 4360+00 LT
SOUTHBOUND
4357+50 | 4360+00 RT
STONE FILL FOR SLOPE
PROTECTION (LIGHT TYPE)
ITEM 512
STATION | STATION | POS
NORTHBOUND
4357+00 | 4359+75 RT
4357+00 | 4359+00 RT
SOUTHBOUND
4356+00 | 4360+00 RT
SUB-BASE OF SAND
ITEM 202
STATION | STATION
NORTHBOUND
4344+00 | 4349+25
4357+75 | 4359+60
SOUTHBOUND
4344+00 | 4359+00
MUCK EXCAVATION
ITEM 117
STATION | STATION
NORTHBOUND
4357+00 | 4360+00
SOUTHBOUND
4357+00 | 4360+00
DRILLING AND BLASTING
OF SOLID ROCK SUBGRADE
ITEM 115
STATION | STATION
NORTHBOUND
4344+00 | 4357+00
PROPERTY LINE FENCE
WITH STEEL POSTS
ITEM 583-II MOD.
STATION | STATION
NORTHBOUND
4344+00 | 4360+00
SOUTHBOUND
4344+00 | 4360+00
*STAGE 2 CONSTRUCTION
PLAN SCALE
0 50 100
CONTRACT NO. 3
STAGE I CONSTRUCTION
2
STATE OF VERMONT
DEPARTMENT OF HIGHWAYS
INTERSTATE PROJECT in the towns of
NORWICH-THETFORD
PLAN
STA 4344+00 TO 4360+00
WEBSTER-MARTIN, INC.
CONSULTING ENGINEERS
SO. BURLINGTON, VT.
SURVEYED BY W-M, INC.
DRAWN BY BCM
CHECKED BY AWM
IN CHARGE RAE
SCALE AS SHOWN
DATE 5/65
PROJECT NO. I 91-2 (7)(47)
SHEET 28 OF 234
84