PROPERTY LINE FENCE TO BE CONSTRUCTED
PRIOR TO COMMENCEMENT OF OTHER WORK
IN THIS AREA
NB 4360+00-4372+53 RT.
NB 4372+53-4376+00 RT.

TOPSOIL STOCKPILE AREAS
SB 4369+00-4373+00 LT (900 Cy)
NB 4365+00-4367+00 RT (250 Cy)
NB 4371+50-4373+50 RT (1000 Cy)

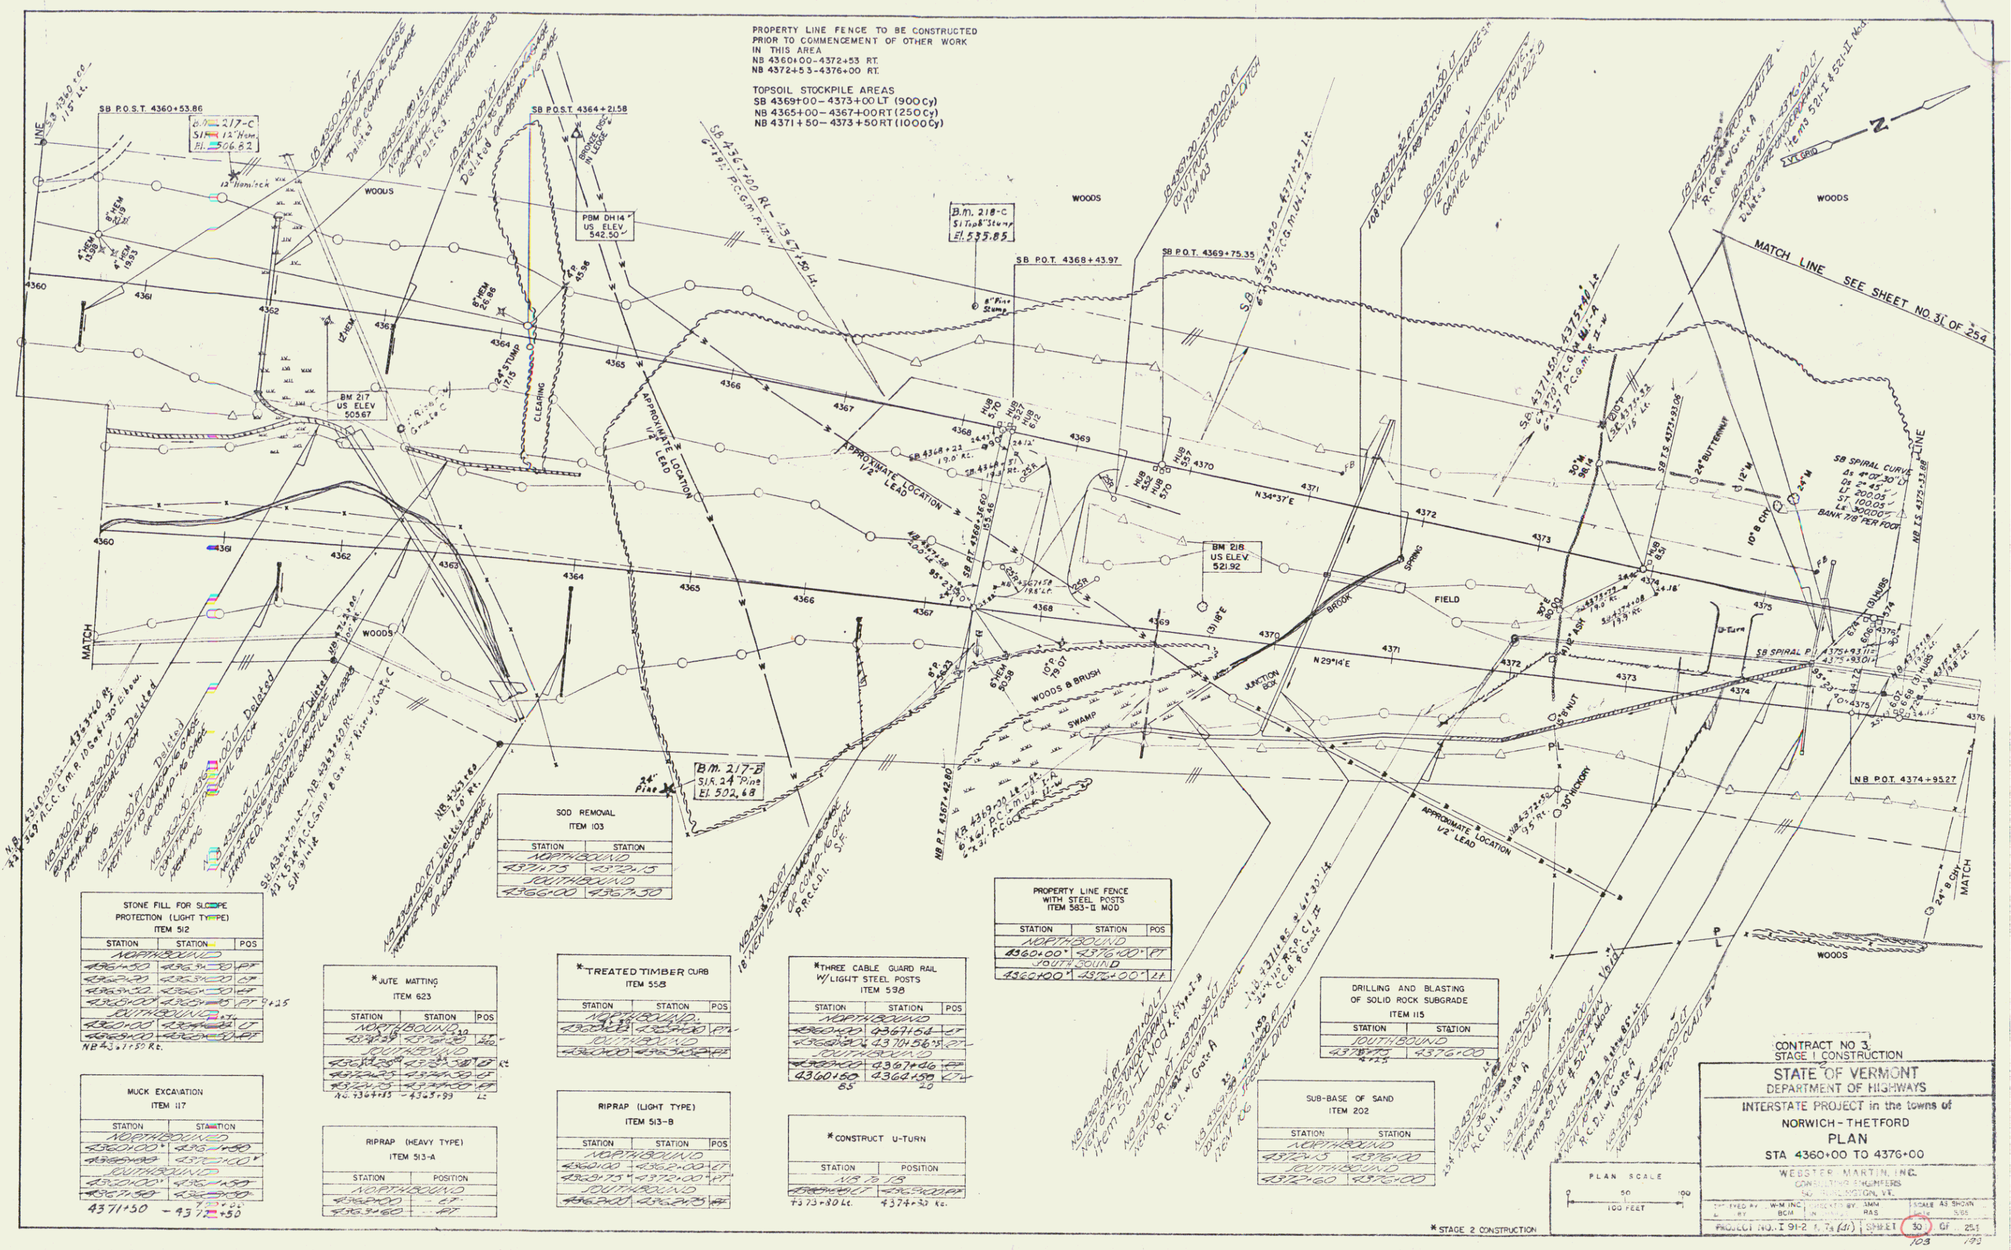

SOD REMOVAL ITEM 103	
STATION	STATION
NORTHBOUND	
4371+75	4372+15
SOUTHBOUND	
4366+00	4367+50

STONE FILL FOR SLOPE PROTECTION (LIGHT TYPE) ITEM 512		
STATION	STATION	POS
NORTHBOUND		
4361+50	4363+00	RT
4362+00	4363+00	RT
4363+00	4364+00	RT
4363+00	4364+00	RT
SOUTHBOUND		
4360+00	4361+00	LT
4366+00	4367+00	RT

PROPERTY LINE FENCE WITH STEEL POSTS ITEM 583-11 MOD		
STATION	STATION	POS
NORTHBOUND		
4360+00*	4376+00*	RT
SOUTHBOUND		
4360+00*	4376+00*	LT

*JUTE MATTING ITEM 623		
STATION	STATION	POS
NORTHBOUND		
4363+25	4372+25	RT
SOUTHBOUND		
4363+25	4372+25	RT

*TREATED TIMBER CURB ITEM 558		
STATION	STATION	POS
NORTHBOUND		
4360+00	4362+00	RT
SOUTHBOUND		
4360+00	4362+00	RT

*THREE CABLE GUARD RAIL W/LIGHT STEEL POSTS ITEM 598		
STATION	STATION	POS
NORTHBOUND		
4360+00	4367+66	LT
4360+25	4361+56	LT
SOUTHBOUND		
4360+00	4367+66	RT
4360+50	4364+50	RT

DRILLING AND BLASTING OF SOLID ROCK SUBGRADE ITEM 115	
STATION	STATION
SOUTHBOUND	
4371+75	4376+00

MUCK EXCAVATION ITEM 117	
STATION	STATION
NORTHBOUND	
4360+00*	4361+00*
4369+00*	4372+00*
SOUTHBOUND	
4360+00*	4361+50
4361+50	4362+50
4371+50	4372+50

RIPRAP (HEAVY TYPE) ITEM 513-A	
STATION	POSITION
NORTHBOUND	
4360+00	LT
4363+60	RT

RIPRAP (LIGHT TYPE) ITEM 513-B		
STATION	STATION	POS
NORTHBOUND		
4360+00	4362+00	LT
4369+75*	4372+00*	RT
SOUTHBOUND		
4360+00	4362+25	RT

*CONSTRUCT U-TURN	
STATION	POSITION
NB 73+18	
BASELINE	4374+00 RT
+73+80 Lt.	4374+33 Rt.

SUB-BASE OF SAND ITEM 202	
STATION	STATION
NORTHBOUND	
4372+15	4376+00
SOUTHBOUND	
4372+60	4376+00

*STAGE 2 CONSTRUCTION

PLAN SCALE
50 100
100 FEET

CONTRACT NO 3
STAGE 1 CONSTRUCTION

STATE OF VERMONT
DEPARTMENT OF HIGHWAYS

INTERSTATE PROJECT in the towns of
NORWICH - THETFORD

PLAN

STA 4360+00 TO 4376+00

WEBSTER - MARTIN, INC.
CONSULTING ENGINEERS
SOUTH BURLINGTON, VT.

DESIGNED BY	DRAWN BY	CHECKED BY	SCALE AS SHOWN
L. BY	W-M INC BCM	RAS	

PROJECT NO. I 91-2 (4) | SHEET 30 OF 254

103 193

85