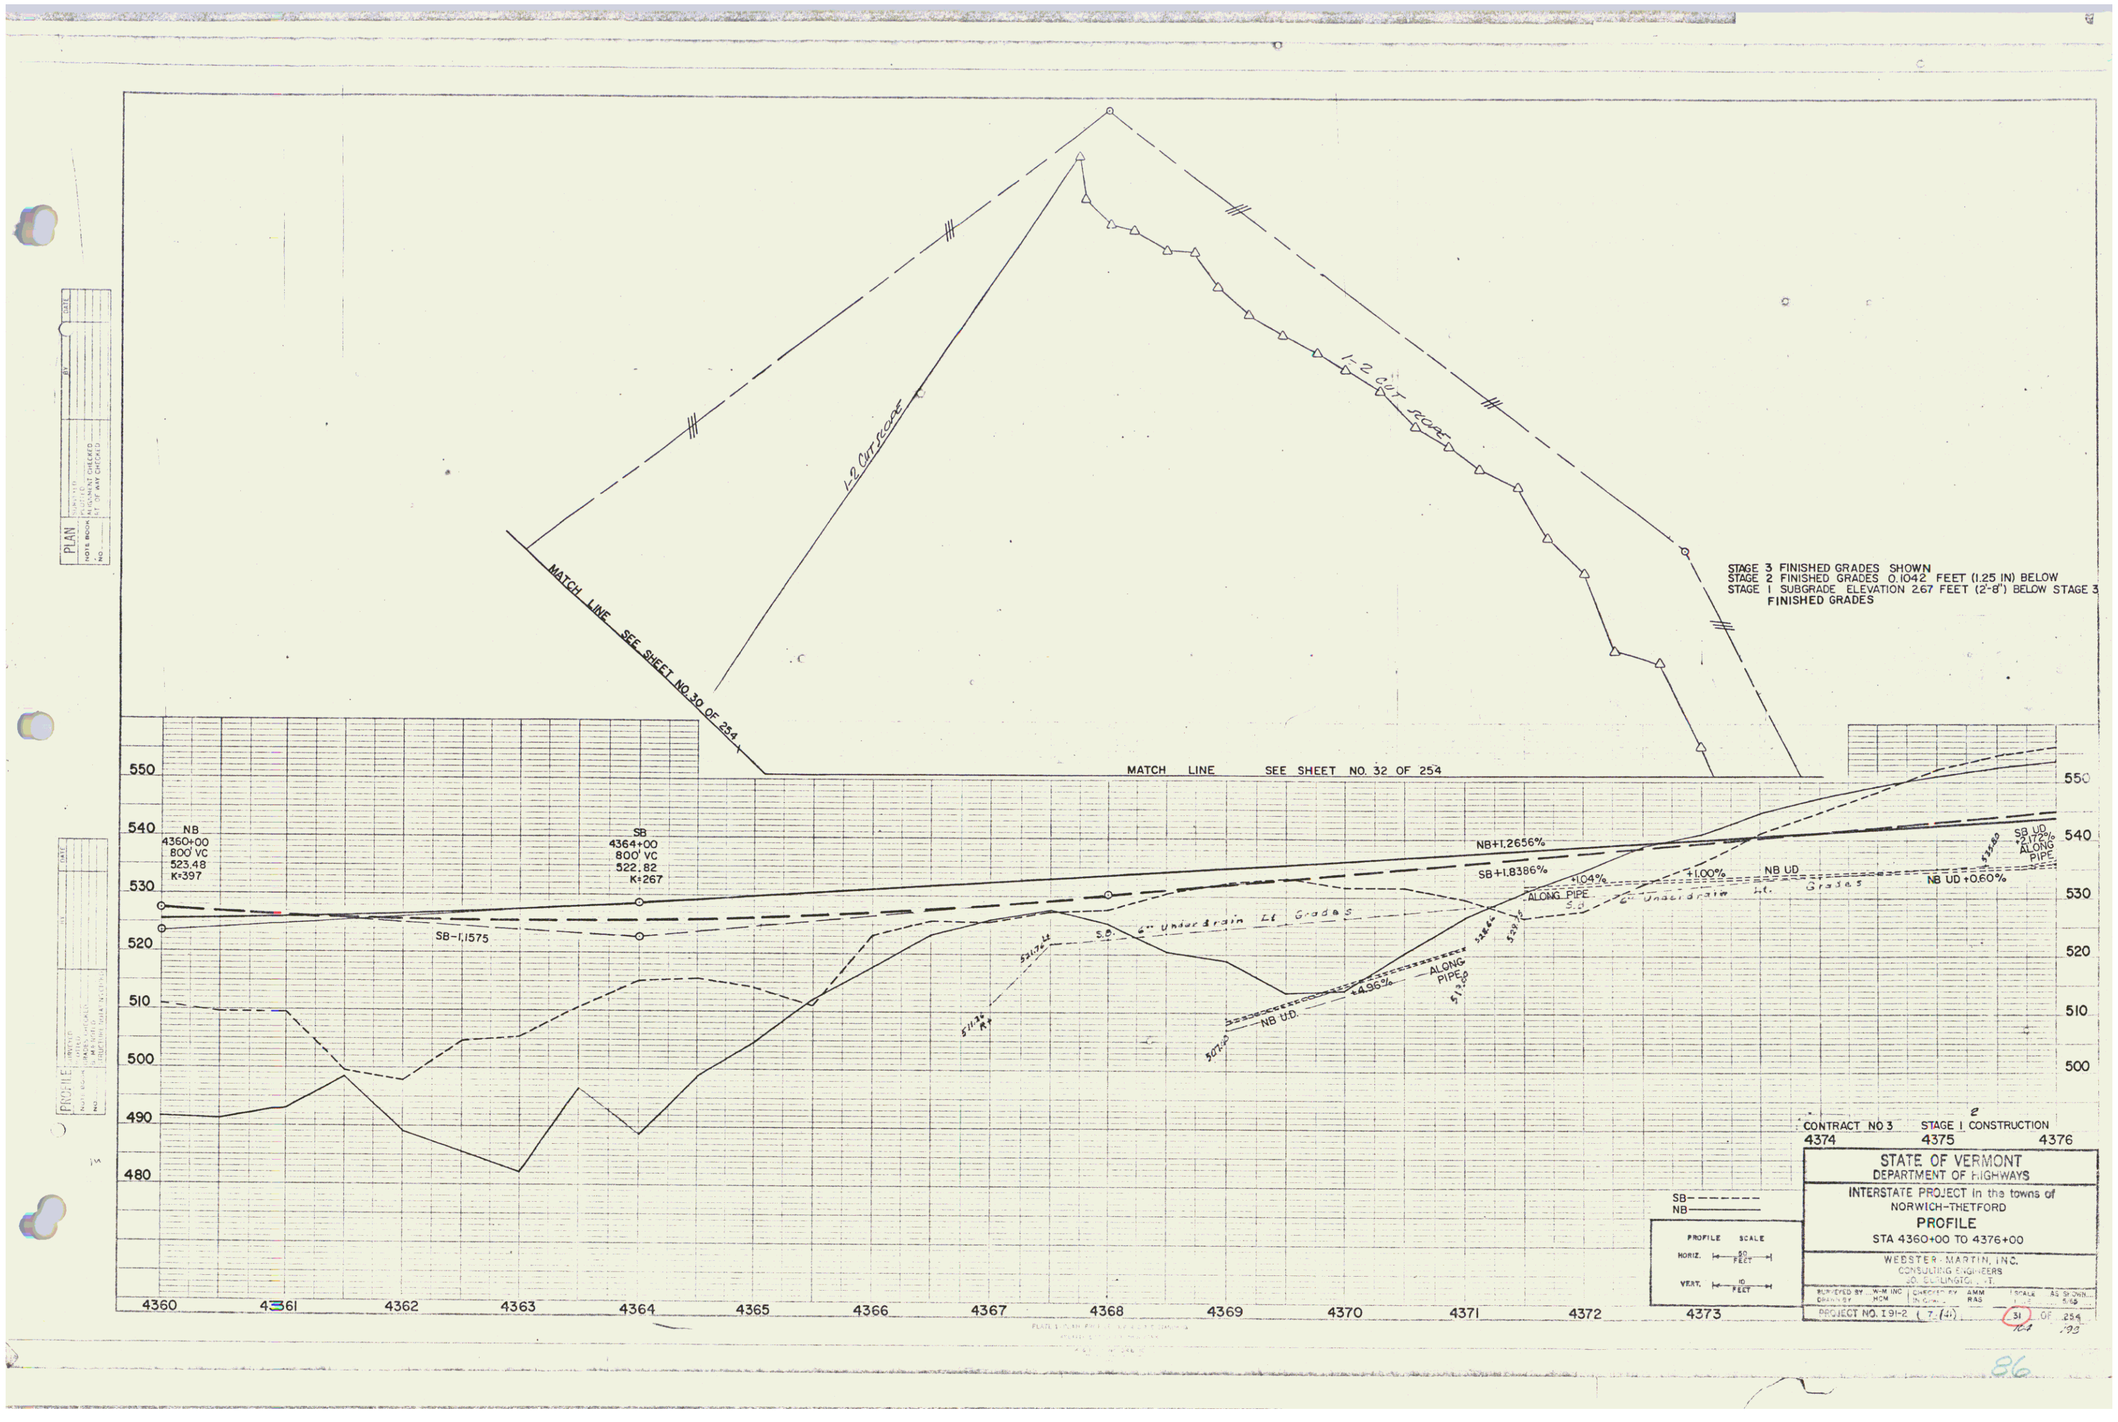

STAGE 3 FINISHED GRADES SHOWN
STAGE 2 FINISHED GRADES 0.1042 FEET (1.25 IN) BELOW
STAGE 1 SUBGRADE ELEVATION 2.67 FEET (2'-8") BELOW STAGE 3 FINISHED GRADES
1-2 CUT SCOPE
MATCH LINE SEE SHEET NO. 30 OF 254
MATCH LINE SEE SHEET NO. 32 OF 254
NB 4360+00 800' VC 523.48 K=397
SB 4364+00 800' VC 522.82 K=267
SB-1.1575
NB+1.2656%
SB+1.8386%
+1.04%
+1.00%
NB UD
NB UD +0.60%
SB UD +2.172% ALONG PIPE
ALONG PIPE
+4.96%
NB U.D.
6" Underdrain Lt. Grades
550
540
530
520
510
500
490
480
4360
4361
4362
4363
4364
4365
4366
4367
4368
4369
4370
4371
4372
4373
4374
4375
4376
SB
NB
PROFILE SCALE
HORIZ. 50 FEET
VERT. 10 FEET
CONTRACT NO 3 STAGE 1 CONSTRUCTION
STATE OF VERMONT
DEPARTMENT OF HIGHWAYS
INTERSTATE PROJECT in the towns of NORWICH-THETFORD
PROFILE
STA 4360+00 TO 4376+00
WEBSTER-MARTIN, INC.
CONSULTING ENGINEERS
SURVEYED BY W-M INC
DRAWN BY HCM
CHECKED BY AMM
IN CHARGE RAS
SCALE AS SHOWN
PROJECT NO. I 91-2 (7-41)
31 OF 254

86