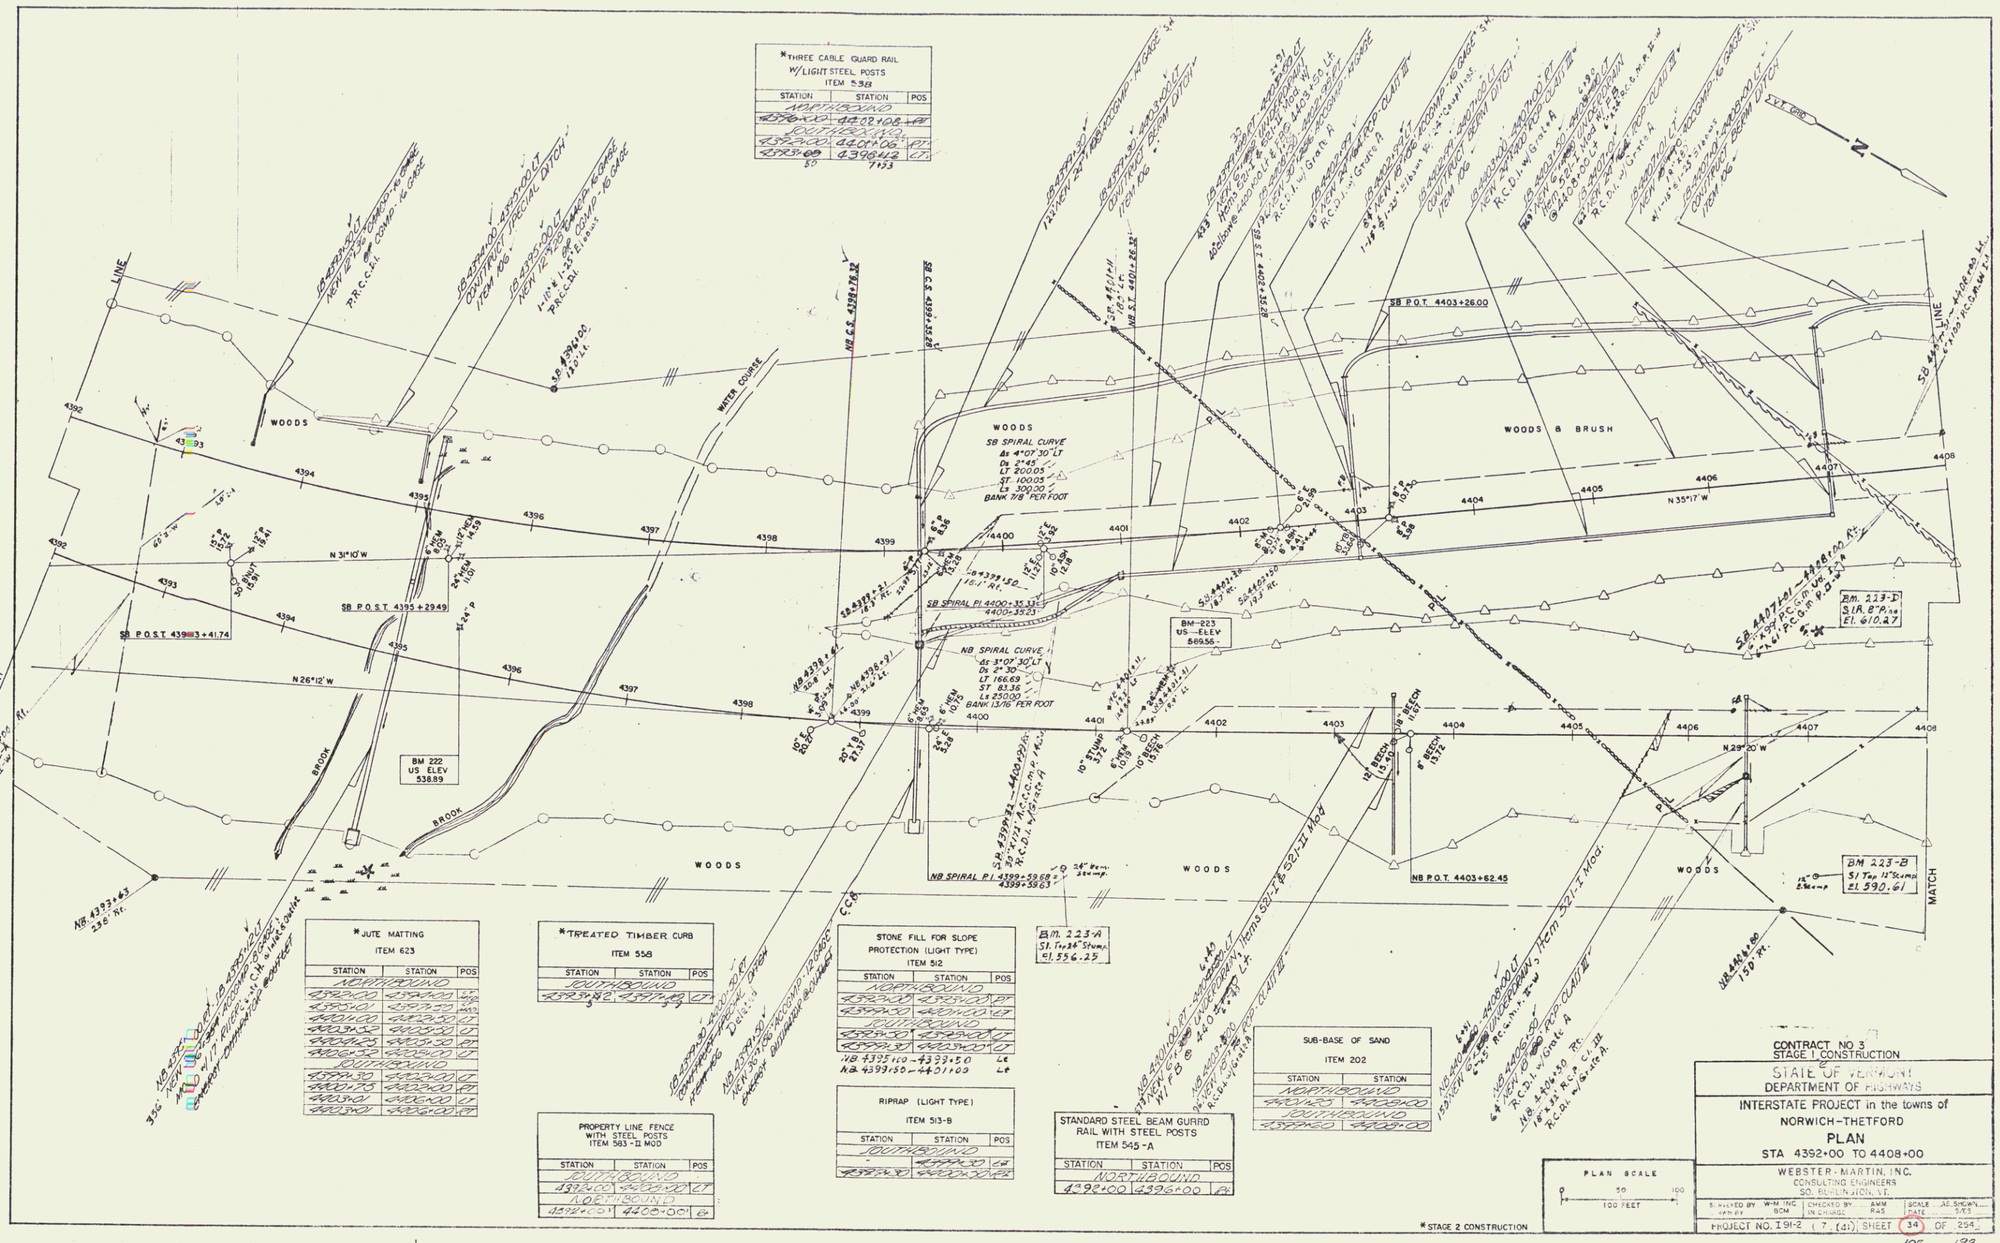
WOODS
WOODS & BRUSH
SB SPIRAL CURVE
NB SPIRAL CURVE
SB P.O.T. 4403+26.00
SB POST 4395+29.49
SB POST 4393+41.74
NB P.O.T. 4403+62.45
BM 222 US ELEV 538.89
BM 223 US ELEV 569.55
BM 223-A
BM 223-B
BROOK
WATER COURSE
MATCH LINE
N 31°10' W
N 26°12' W
N 35°17' W
N 29°20' W
*THREE CABLE GUARD RAIL W/LIGHT STEEL POSTS ITEM 538
*JUTE MATTING ITEM 623
*TREATED TIMBER CURB ITEM 558
STONE FILL FOR SLOPE PROTECTION (LIGHT TYPE) ITEM 512
PROPERTY LINE FENCE WITH STEEL POSTS ITEM 583-II MOD
RIPRAP (LIGHT TYPE) ITEM 513-B
STANDARD STEEL BEAM GURRD RAIL WITH STEEL POSTS ITEM 545-A
SUB-BASE OF SAND ITEM 202
PLAN SCALE
50 100
100 FEET
*STAGE 2 CONSTRUCTION
CONTRACT NO. 3
STAGE 1 CONSTRUCTION
STATE OF VERMONT
DEPARTMENT OF HIGHWAYS
INTERSTATE PROJECT in the towns of
NORWICH-THETFORD
PLAN
STA 4392+00 TO 4408+00
WEBSTER-MARTIN, INC.
CONSULTING ENGINEERS
SO. BURLINGTON, VT.
PROJECT NO. I 91-2
SHEET 34 OF 294