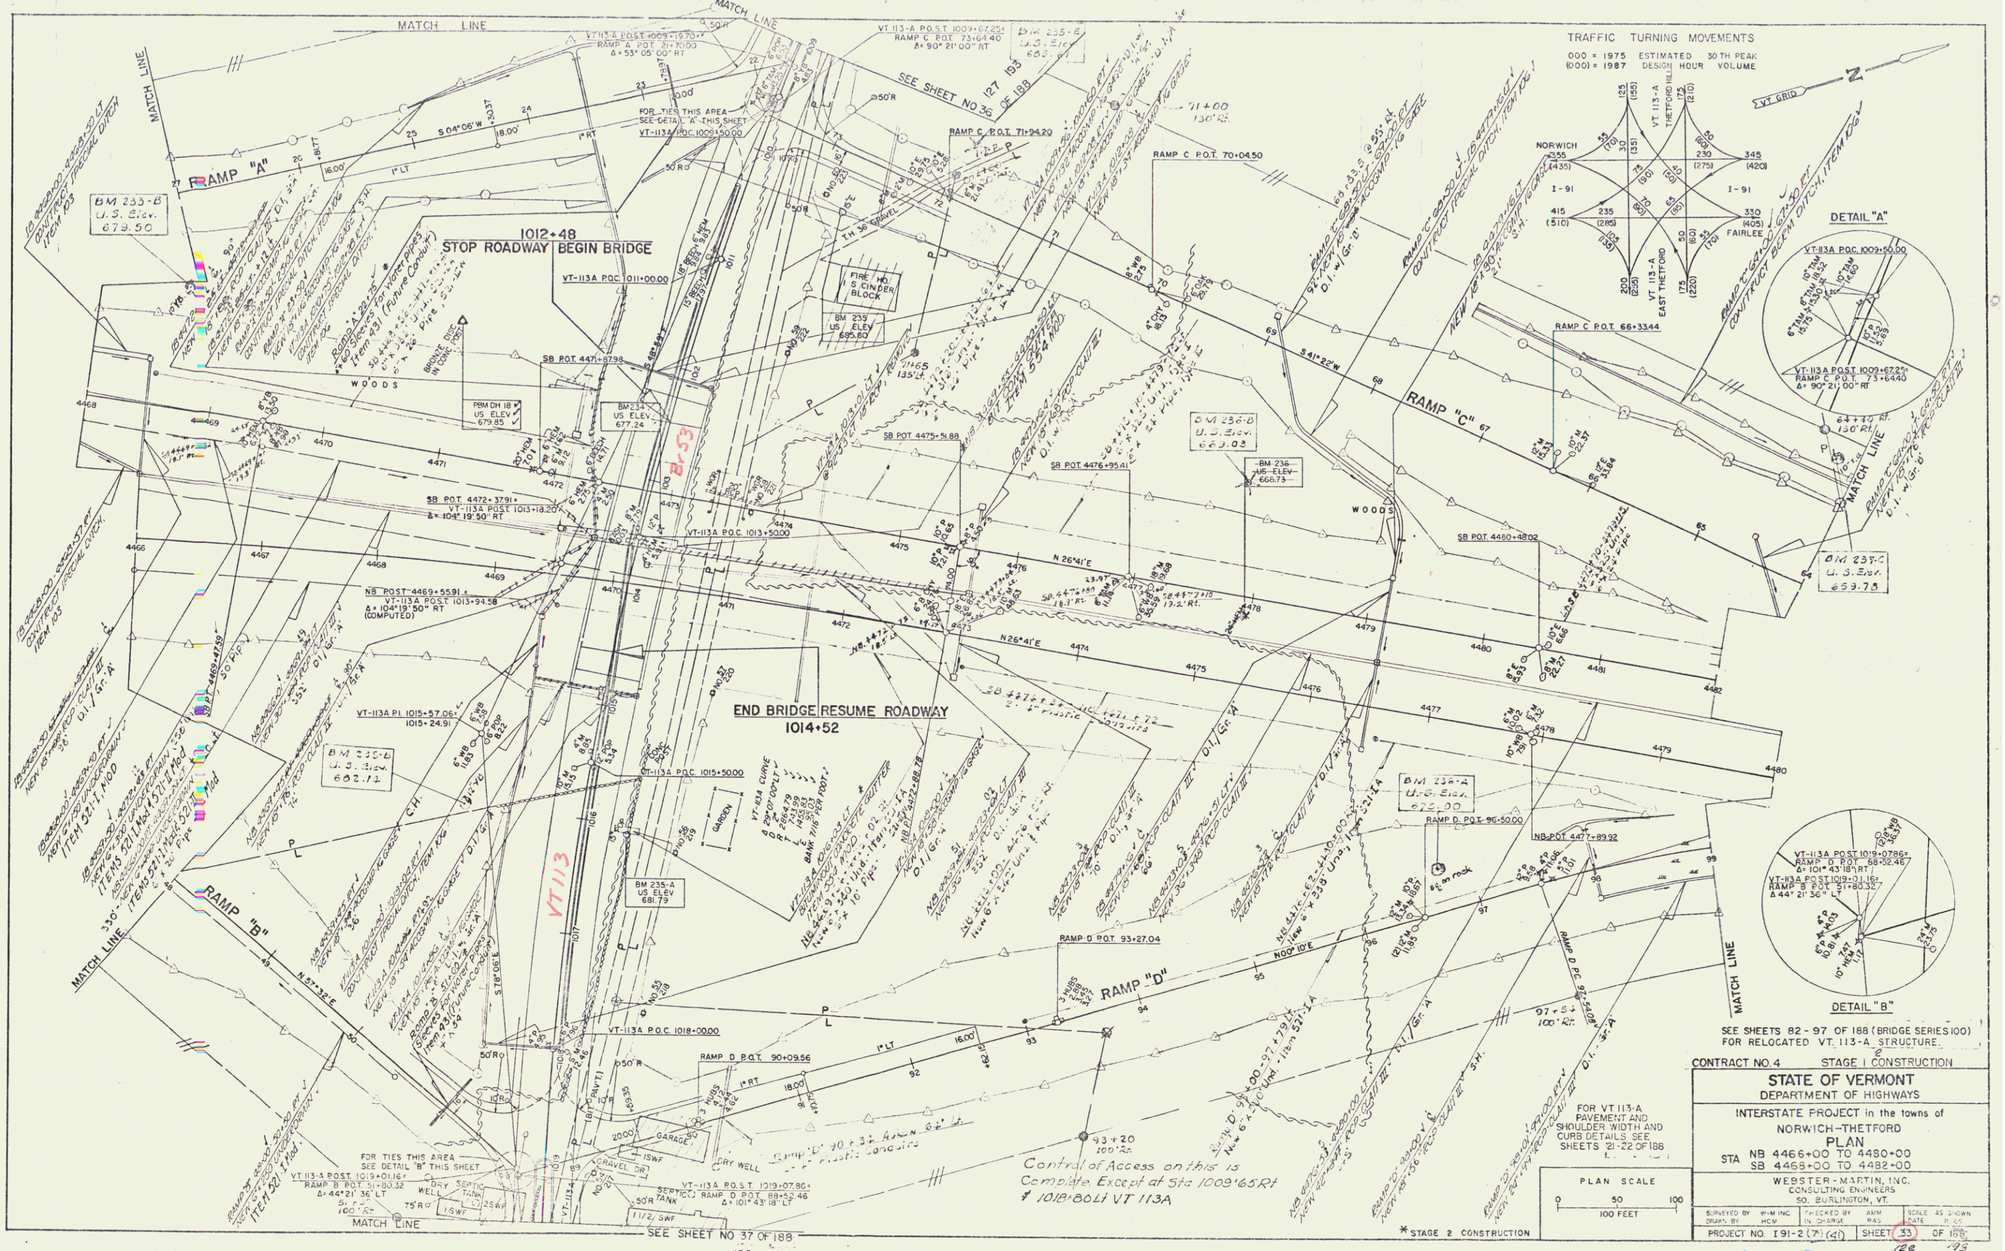
MATCH LINE
SEE SHEET NO 36 OF 188
RAMP "A"
RAMP "B"
RAMP "C"
RAMP "D"
1012+48
STOP ROADWAY BEGIN BRIDGE
END BRIDGE RESUME ROADWAY
1014+52
VT 113
TRAFFIC TURNING MOVEMENTS
000 = 1975 ESTIMATED 30 TH PEAK
(000) = 1987 DESIGN HOUR VOLUME
NORWICH
THETFORD
FAIRLEE
I-91
VT 113-A
EAST THETFORD
DETAIL "A"
DETAIL "B"
Control of Access on this is Complete Except at Sta 1009+65 Rt & 1018+80 Lt VT 113A
SEE SHEETS 82 - 97 OF 188 (BRIDGE SERIES 100) FOR RELOCATED VT. 113-A STRUCTURE.
CONTRACT NO. 4 STAGE I CONSTRUCTION
STATE OF VERMONT
DEPARTMENT OF HIGHWAYS
INTERSTATE PROJECT in the towns of
NORWICH-THETFORD
PLAN
STA NB 4466+00 TO 4480+00
SB 4468+00 TO 4482+00
WEBSTER-MARTIN, INC.
CONSULTING ENGINEERS
SO. BURLINGTON, VT.
PLAN SCALE
0 50 100
100 FEET
FOR VT 113-A PAVEMENT AND SHOULDER WIDTH AND CURB DETAILS SEE SHEETS 21-22 OF 188
* STAGE 2 CONSTRUCTION
SEE SHEET NO 37 OF 188
PROJECT NO. I 91-2 (7) (41)
SHEET 33 OF 188

96