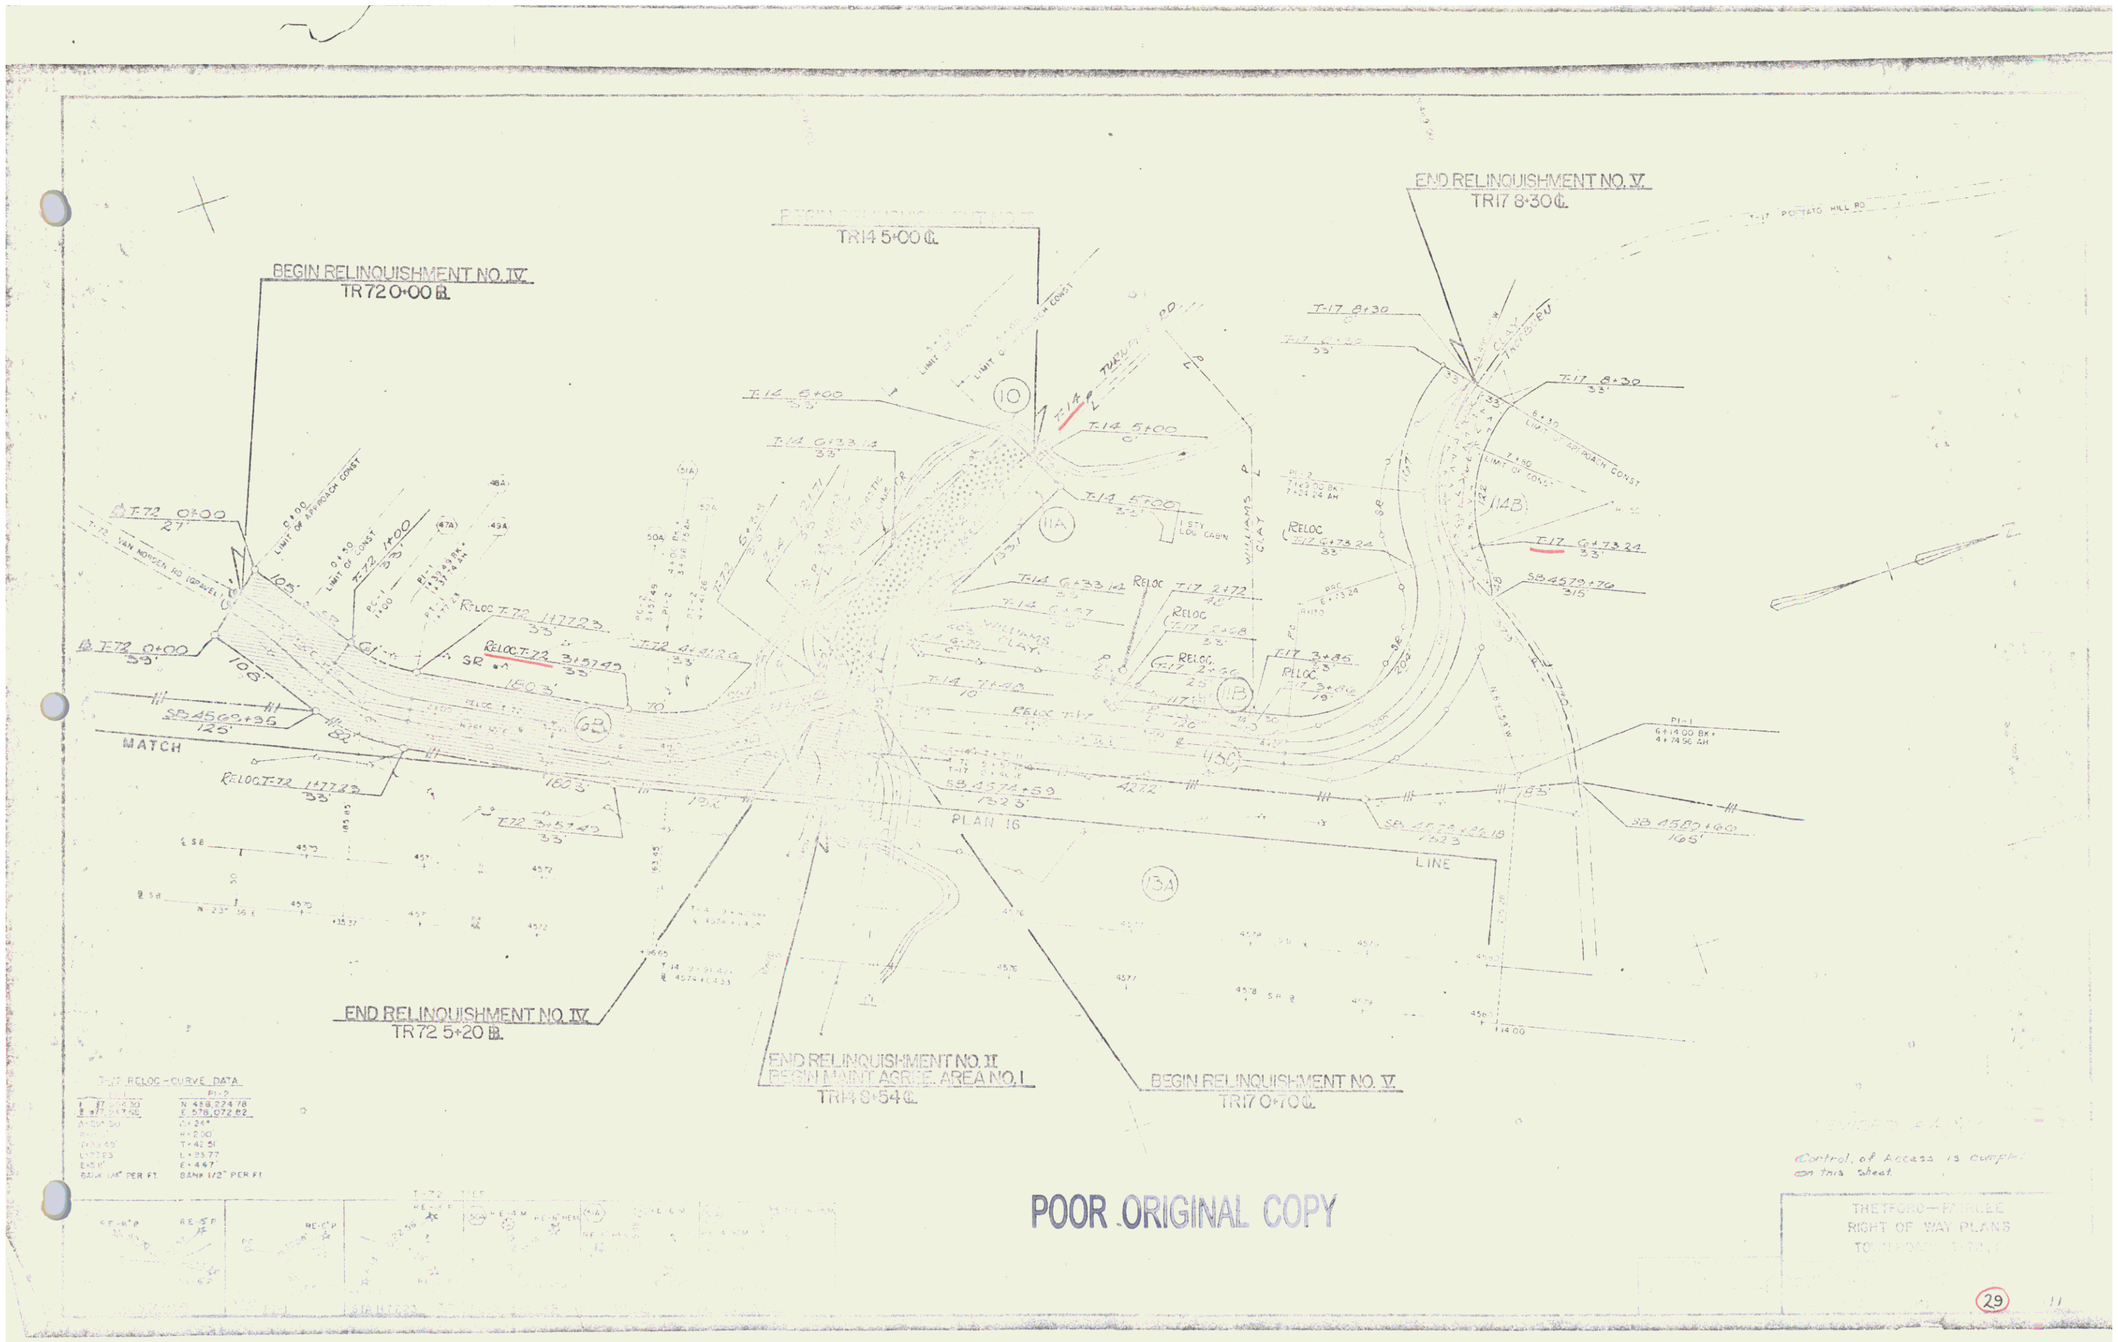

POOR ORIGINAL COPY

22