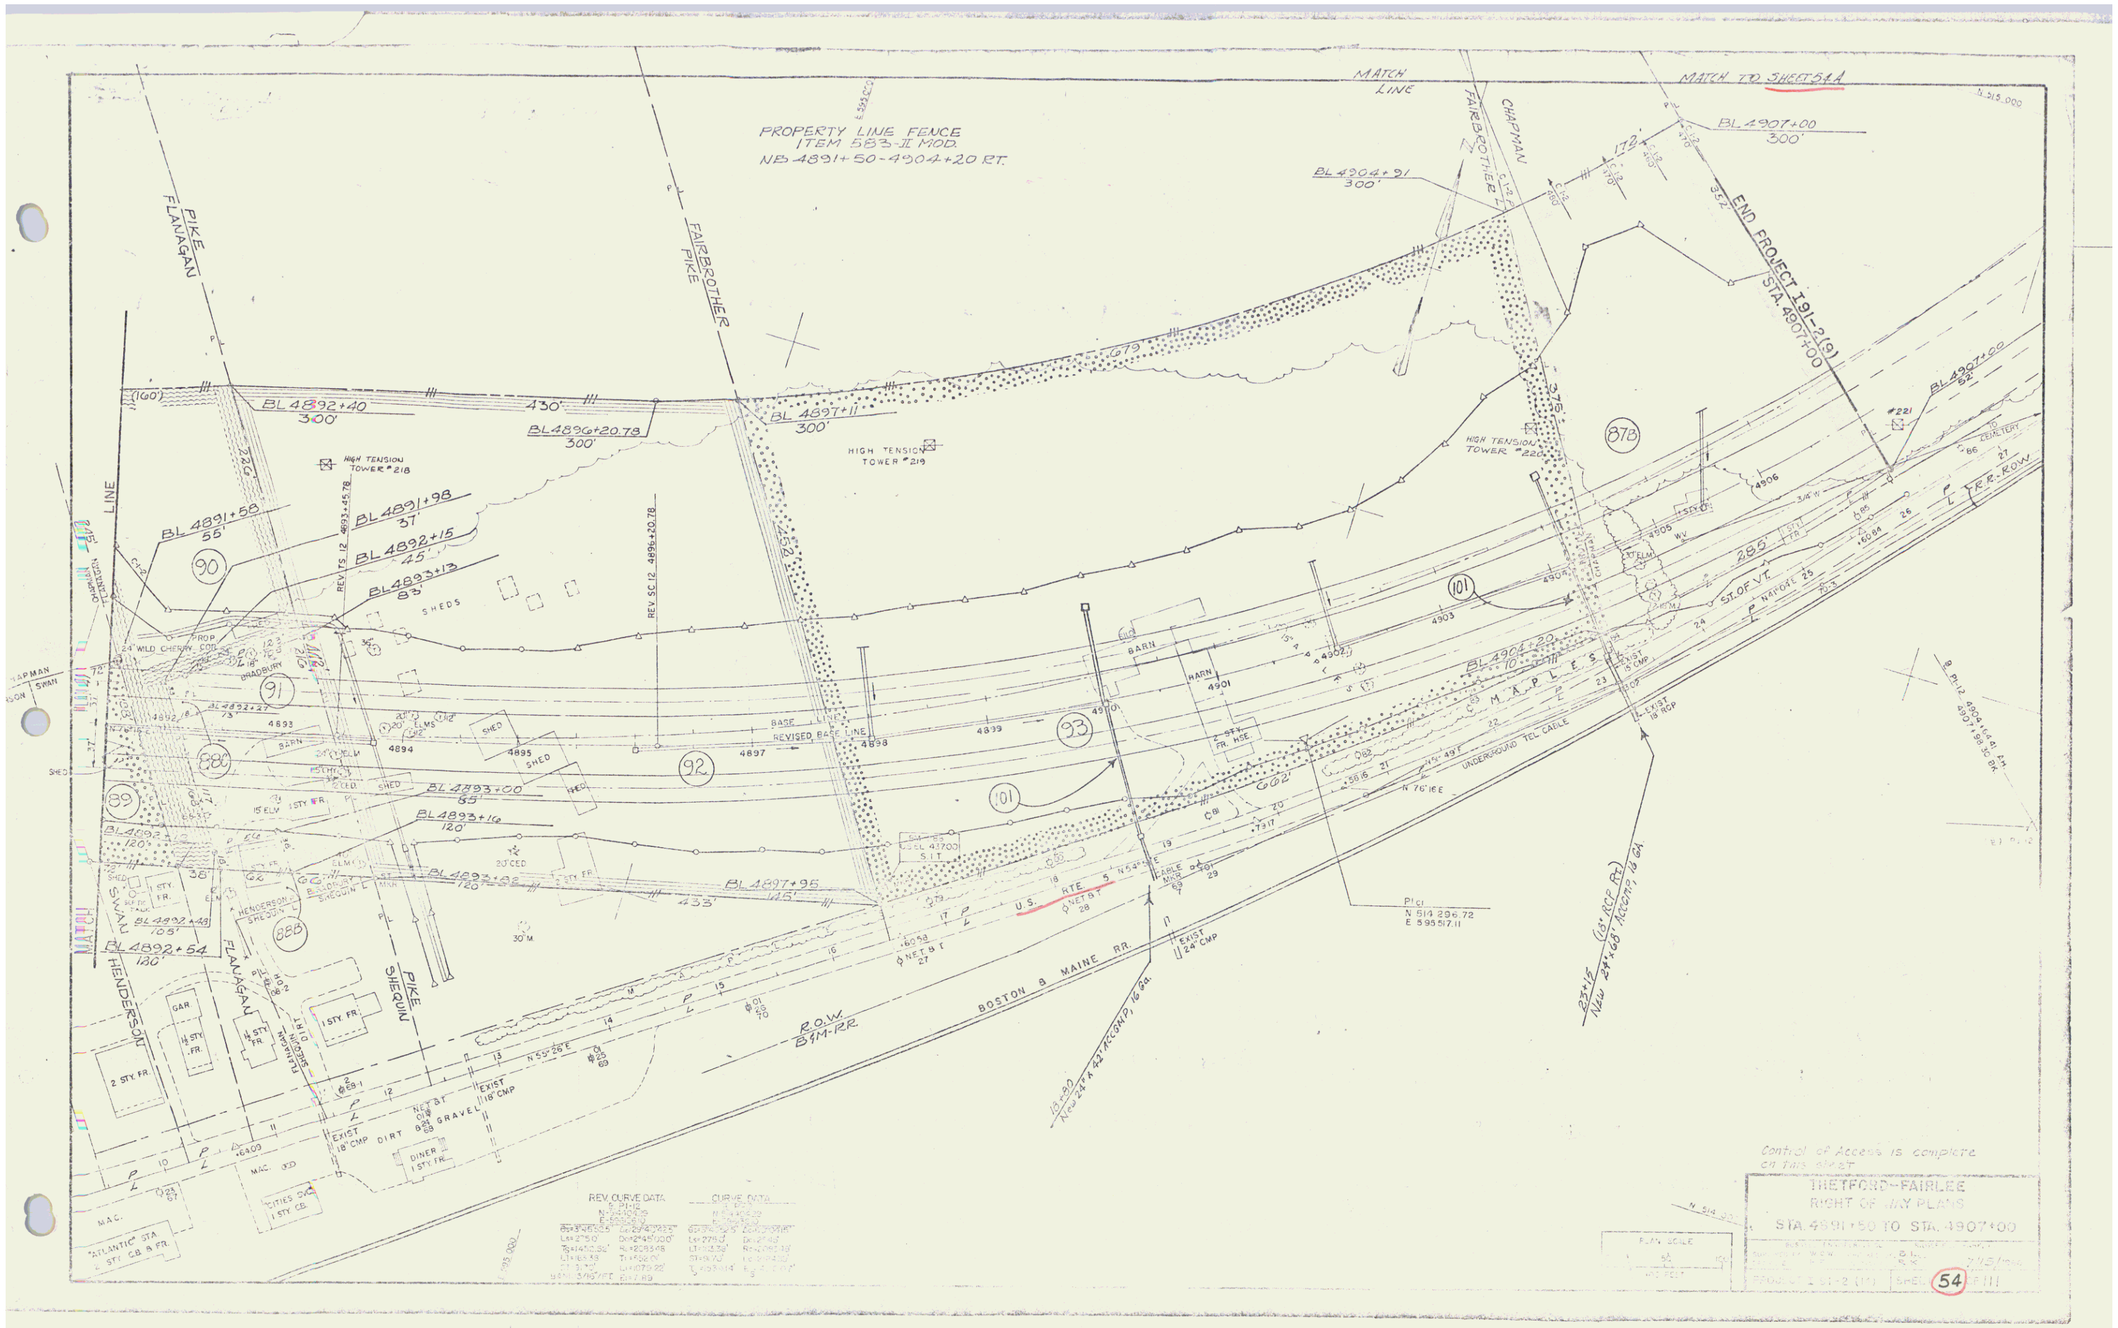
MATCH LINE
MATCH TO SHEET 54A
PROPERTY LINE FENCE
ITEM 5B3-II MOD.
NB 4891+50-4904+20 RT.
FLANAGAN PIKE
FAIRBROTHER PIKE
CHAPMAN
END PROJECT T91-2(9)
STA. 4907+00
BL 4907+00
300'
BL 4904+91
300'
BL 4892+40
300'
BL 4896+20.78
300'
BL 4897+11
300'
BL 4891+58
55'
BL 4891+98
37'
BL 4892+15
45'
BL 4893+13
82'
BL 4893+00
55'
BL 4893+16
120'
BL 4897+95
125'
BL 4892+54
130'
BL 4904+20
HIGH TENSION TOWER #218
HIGH TENSION TOWER #219
HIGH TENSION TOWER #220
REV. TS 12 4893+45.78
REV. SC 12 4896+20.78
BASE LINE
REVISED BASE LINE
SHEDS
BARN
MAPLES
UNDERGROUND TEL CABLE
U.S. RTE 5
BOSTON & MAINE RR.
R.O.W. B&M-RR
SWAN
HENDERSON
FLANAGAN
SHEQUIN PIKE
PI (1)
N 514 296.72
E 595517.11
Control of Access is complete on this sheet.
THETFORD-FAIRLEE
RIGHT OF WAY PLANS
STA. 4891+50 TO STA. 4907+00
SHEET 54 OF 111