* TREATED TIMBER CURB ITEM 558
SB 4640+00 — 4645+85 - RT.

ADDITIONAL 12" SUBBASE OF SAND ITEM 202	
NB	4640+00 — 4644+50
SB	4649+50 — 4655+00
NB	4649+50 — 4655+00

THREE CABLE GUARD RAIL WITH LIGHT STEEL POSTS ITEM 538	
SB	4640+00 — 4655+00 RT
NB	4640+00 — 4651+84.43 RT

PROPERTY LINE FENCE ITEM 583-II MOD.
NB 4640+00 — 4655+00 RT
SB 4640+00 — 4655+00 LT
NB 4640+00 — 4655+00 RT

BIT. CONC. SURFACE FOR GUTTER & TRAFFIC ISLAND ITEM 554 MOD.
SB 4642 + 10' RT.

CONSTRUCT PROPERTY LINE FENCE, ITEM 583 II-MOD. PRIOR TO COMMENCEMENT OF OTHER WORK IN THIS AREA.

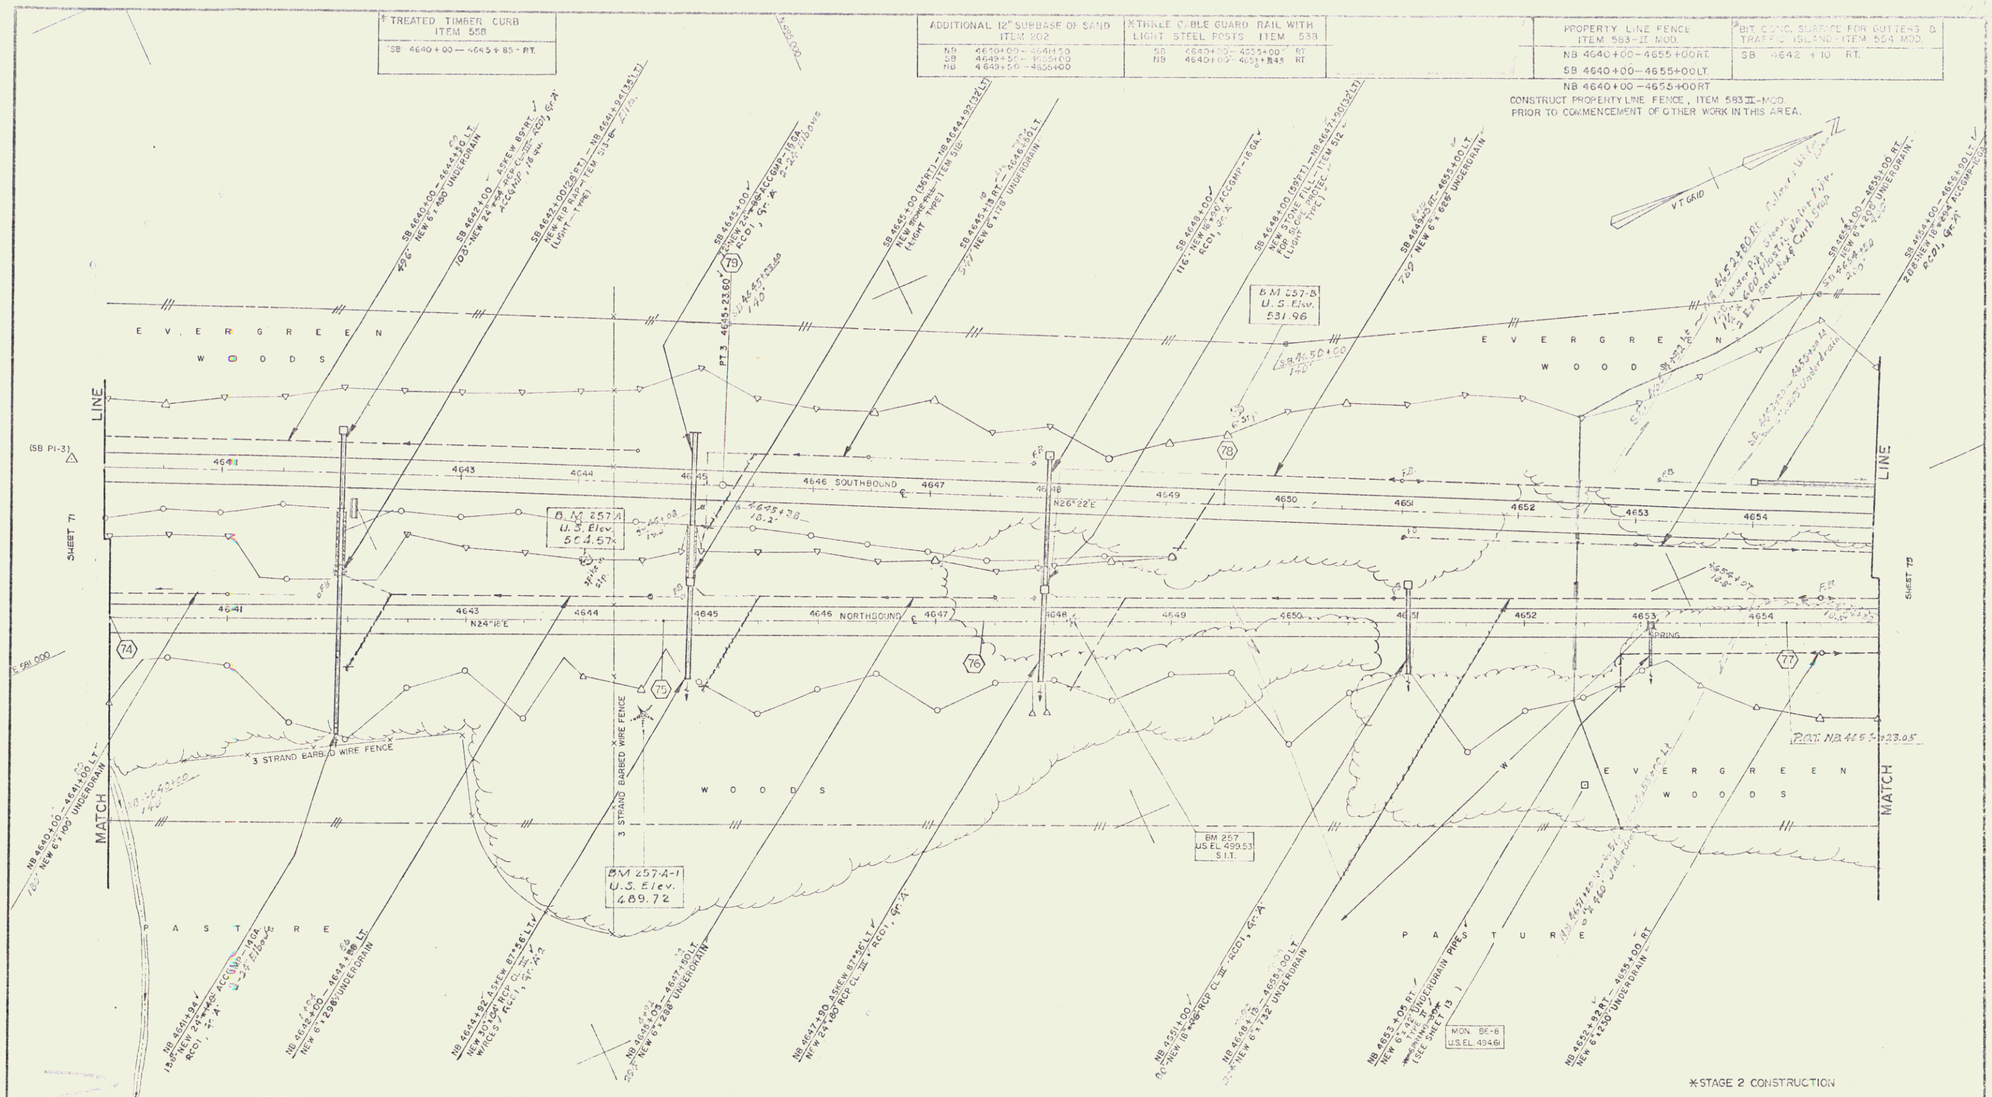

NB TIES				SB TIE	
74	75	76	77	78	79
RE-6" ELM; RE-18" TWIN HEM; RE-12" HEM; STK. ℄	RE-12" HEM; RE-12" HEM; RE-10" HEM; STK. ℄	RE-10" HEM; RE-18" HEM; RE-6"P; STK. ℄	RE-30" HEM; RE-12"P; RE-10"P; STK. ℄	20" HEM; 28" HEM; 30" HEM; 4649 ℄	12" HEM; 8" HEM; 8" HEM; 4649 ℄
STA. 4640+03.52	STA. 4644+69.73	STA. 4647+40.00	STA. 4654+23.05	STA. 4649+50.00	PT 3 4645+23.60

*STAGE 2 CONSTRUCTION

CONTROL OF ACCESS IS COMPLETE ON THIS SHEET.

PLAN SCALE
0 50 100
100 FEET

THETFORD – FAIRLEE
CONTRACT STAGE 2 CONSTRUCTION
STA 4640+00 TO STA 4655+00
BOAVELL ENGINEERING CO. HOPEFIELD PARK, N.J.
SURVEYED BY K.D.V. CHECKED BY D.L. DATE NOV. 1969
DRAWN BY J.N.F. IN CHARGE D.L.
PROJECT I 91-2 (9) SHEET 73 OF 89

(29) – 43 of 150

77