NB 4685+00–4692+46RT.
NB 4696+50–4700+00RT.
CONSTRUCT PROPERTY LINE FENCE, ITEM 583-II MOD.
PRIOR TO COMMENCEMENT OF OTHER WORK IN THIS AREA.

ADDITIONAL 12" SUBBASE OF SAND ITEM 202	MUCK EXCAVATION- ITEM 117	STD STEEL BEAM GUARD RAIL WITH STEEL POSTS ITEM 540A	THREE CABLE GUARD RAIL WITH LIGHT STEEL POSTS ITEM 538	* TREATED TIMBER CURB ITEM 608	STONE FILL FOR SLOPE PROTEC. (HEAVY TYPE)–ITEM 511	RIPRAP – ITEM 513-A (HEAVY TYPE)	PROPERTY LINE FENCE ITEM 583-II MOD.
NB 4685+00–4697+00 SB 4686+50–4697+00	SB 4685+00–4688+75	NB 4692+55–4694+65 LT NB 4692+75–4693+25 RT SB 4692+71–4694+21 LT SB 4692+23–4694+22 RT	NB 4697+00–4700+00 LT NB 4697+00–4700+00 RT SB 4699+00–4700+00 RT	NB 4697+92–4700+00 RT	SB 4697+93 RT NB 4697+78 RT (W/VELOCITY RETARDER)	SB 4698+75 LT SB 4699+05 RT NB 4697+75 RT	NB 4685+00–4700+00RT.* SB 4685+00–4700+00LT.

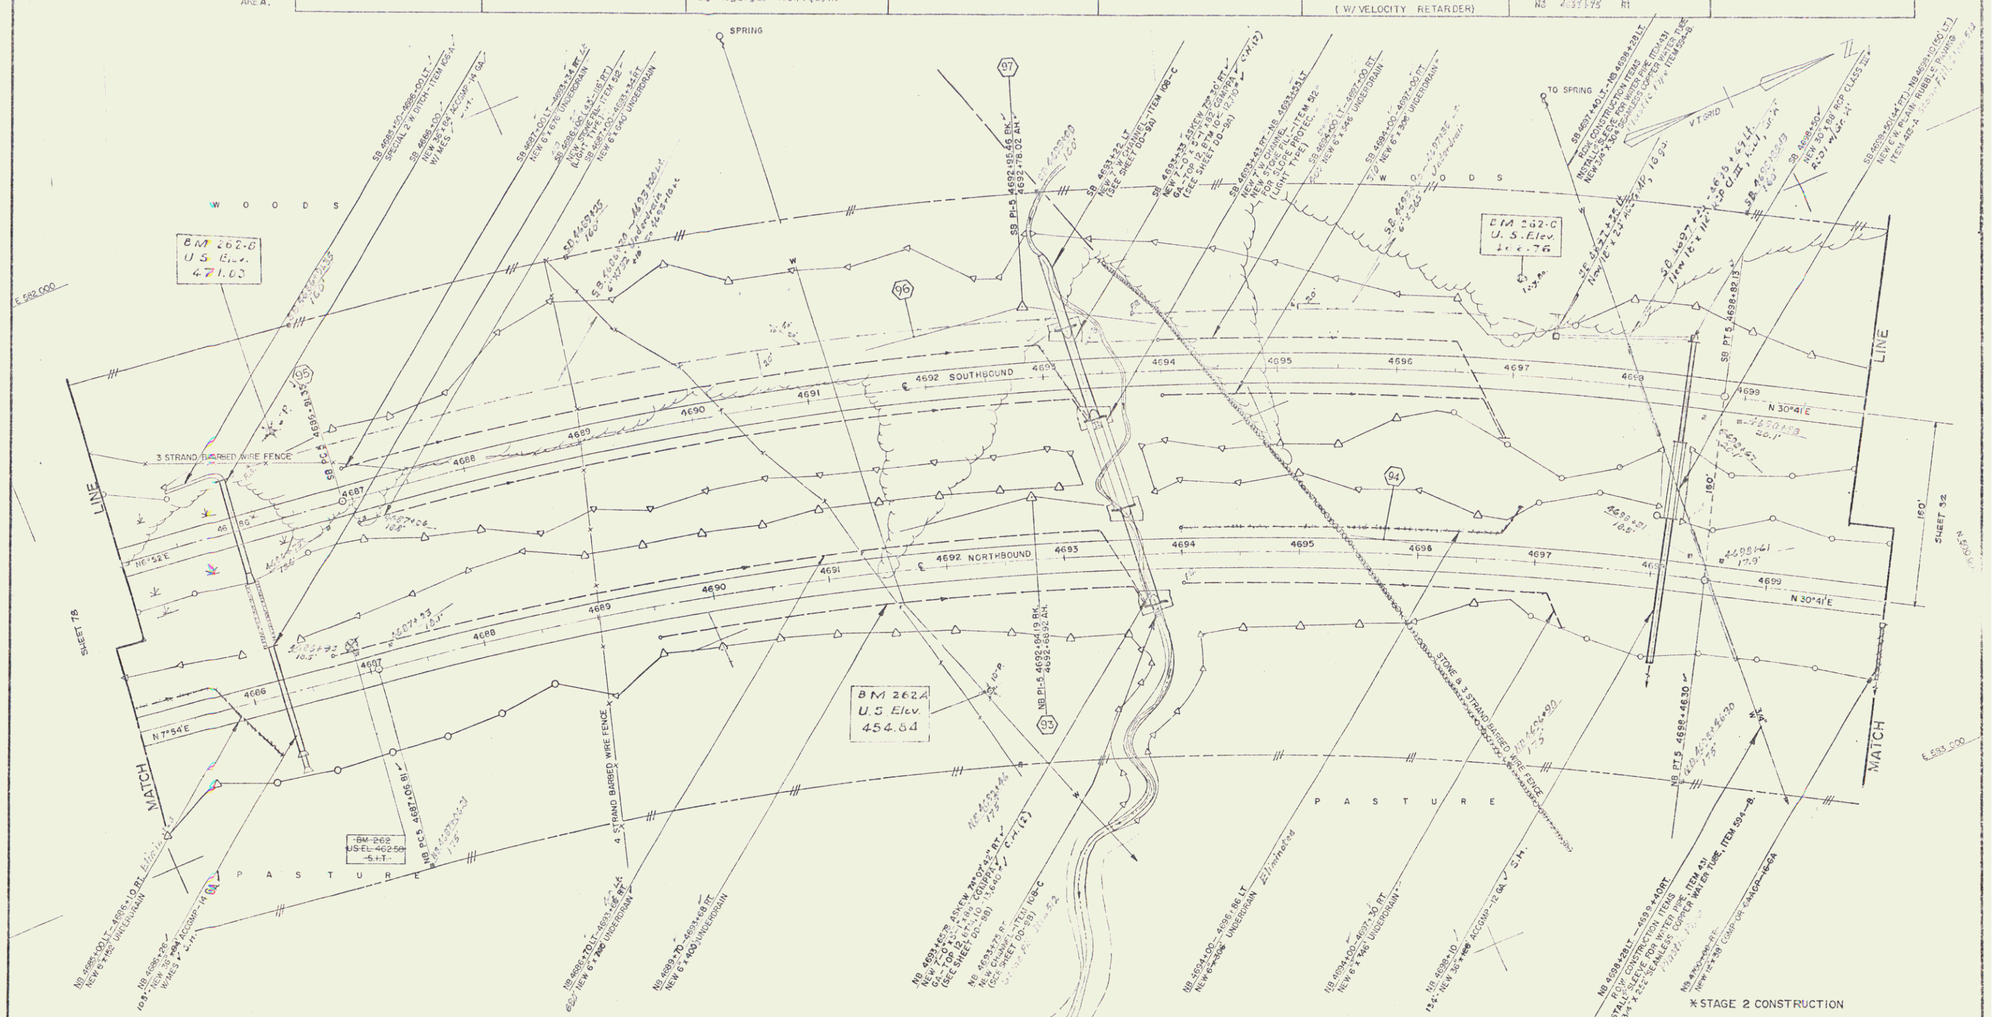

NB TIES

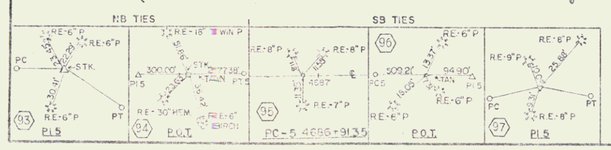

SB TIES

CURVE DATA

NB PI-5	SB PI-5
N 499,293.66	N 499,349.76
E 592,487.92	E 592,313.16
D = 2°00' ✓	D = 2°00' ✓
Δ = 22°47'23" ✓	Δ = 23°48'58" ✓
R = 2864.79' ✓	R = 2864.79 ✓
T = 577.38' ✓	T = 604.11' ✓
L = 1139.48' ✓	L = 1190.78' ✓
E = 57.00' ✓	E = 63.00' ✓
BANK 11/16" PER FT.	BANK 11/16 PER FT.

CONTROL OF ACCESS IS COMPLETE ON THIS SHEET

PLAN SCALE
0 50 100
100 FEET

THETFORD--FAIRLEE
CONTRACT STAGE 2 CONSTRUCTION
STA 4685+00 TO STA. 4700+00

BORWELL ENGINEERING CO. RIDGEFIELD PARK, N.J.
SURVEYED BY A.T.A. CHECKED BY B.
DRAWN BY IN CHARGE DATE NOV. 1974

PROJECT I 91-2 (9) SHEET 80 OF 163

(24) 55 of 160

* STAGE 2 CONSTRUCTION

80