NB 4700+00 – 4704+97
NB 4704+97 – 4715+00
CONSTRUCT PROPERTY LINE FENCE ITEM 583-JI MOD.
PRIOR TO COMMENCEMENT OF OTHER WORK IN THIS AREA.
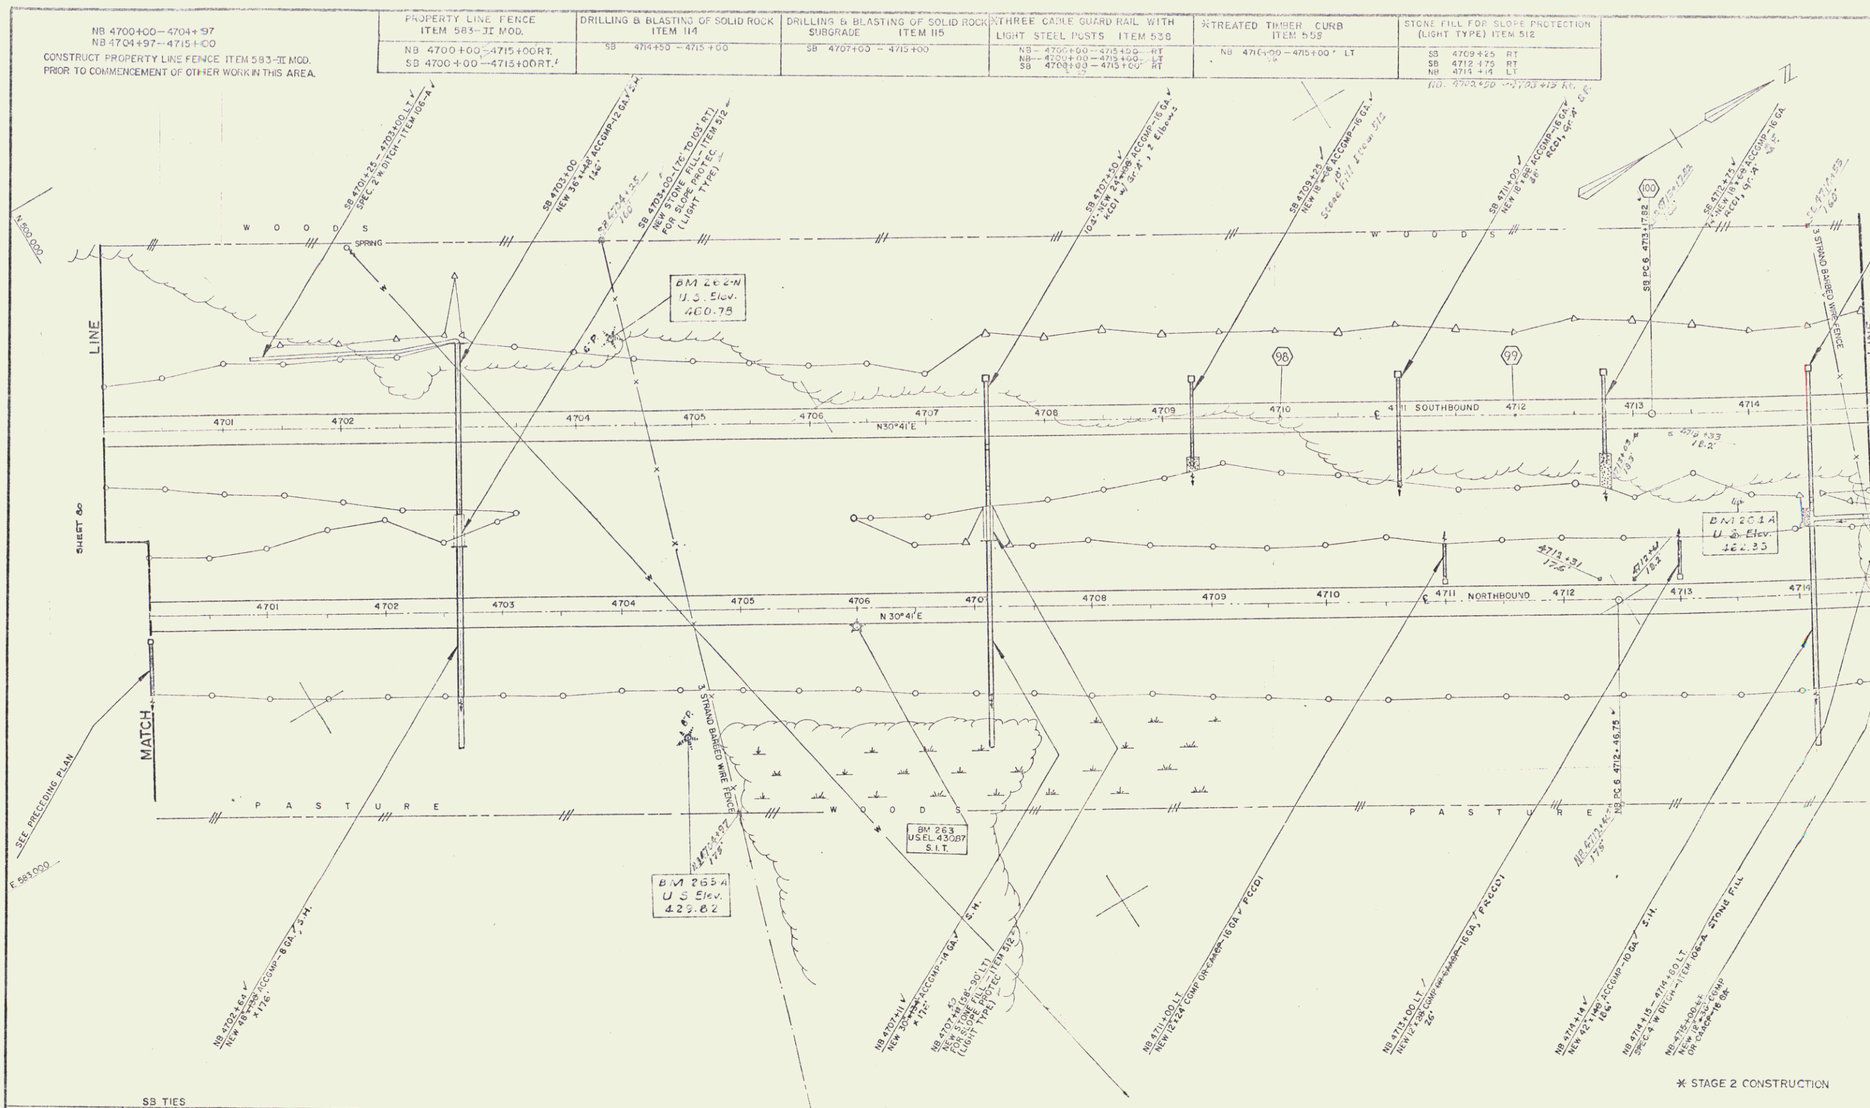
PROPERTY LINE FENCE ITEM 583-JI MOD.	DRILLING & BLASTING OF SOLID ROCK ITEM 114	DRILLING & BLASTING OF SOLID ROCK SUBGRADE ITEM 115	*THREE CABLE GUARD RAIL WITH LIGHT STEEL POSTS ITEM 536	*TREATED TIMBER CURB ITEM 558	STONE FILL FOR SLOPE PROTECTION (LIGHT TYPE) ITEM 512
NB 4700+00 – 4715+00 RT. SB 4700+00 – 4715+00 RT.	SB 4714+50 – 4715+00	SB 4707+00 – 4715+00	NB – 4706+00 – 4715+00 RT NB – 4700+00 – 4715+00 LT SB 4700+00 – 4715+00 RT	NB 4706+00 – 4715+00 LT	SB 4709+25 RT SB 4712+75 RT NB 4713+14 LT NB 4700+50 – 4703+15 RT