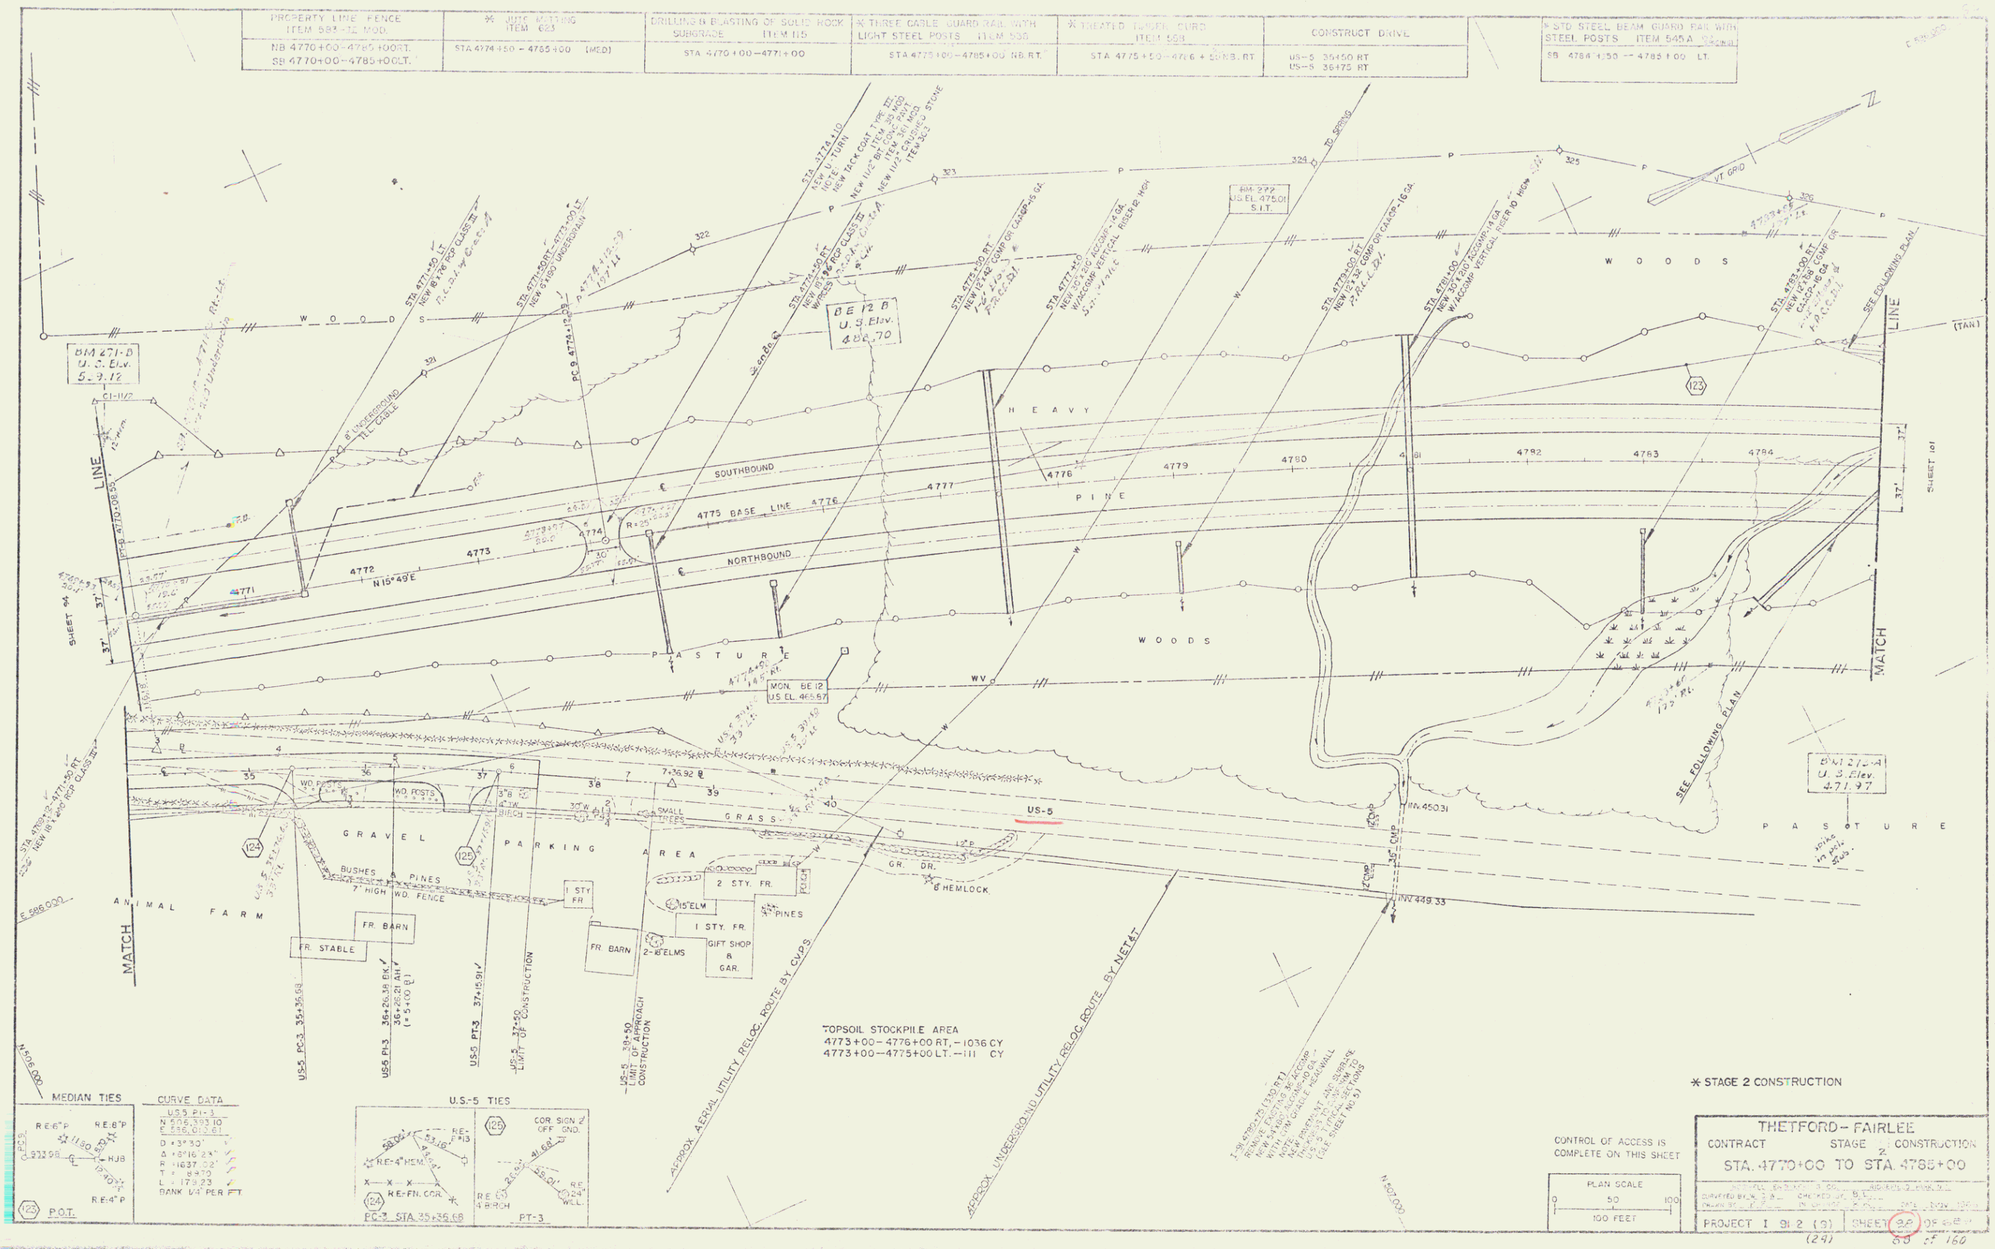PROPERTY LINE FENCE ITEM 664-32 WOO.	* JUTE MATTING ITEM 623	DRILLING & BLASTING OF SOLID ROCK SUBGRADE ITEM 115	* THREE CABLE GUARD RAIL WITH LIGHT STEEL POSTS ITEM 536	* TREATED TIMBER CURB ITEM 559	CONSTRUCT DRIVE	* STD STEEL BEAM GUARD RAIL WITH STEEL POSTS ITEM 545A
NB 4770+00–4785+00RT. SB 4770+00–4785+00LT.	STA 4774+50 – 4785+00 (MED)	STA 4770+00–4771+00	STA 4775+00–4785+00 NB RT.	STA 4775+50–4776+50 NB. RT	US-5 35+50 RT US-5 36+75 RT	SB 4784+50 – 4785+00 LT.