DRILLING & BLASTING OF SOLID ROCK SUBGRADE ITEM 115	ADDITIONAL 12" SUBBASE OF SAND ITEM 202	* JUTE MATTING ITEM 623
STA 4788+00 — 4794+00	STA 4786+50 — 4793+00 SB	STA 4785+00 — 4787+00 (VEQ) STA 4793+00 — 4800+00 (MED)

* THREE CABLE GUARD RAIL WITH ITEM 5	PLANK GUARD RAIL ITEM 540	STD STEEL BEAM GUARD RAIL WITH STEEL POSTS ITEM 545A (N.T.S.)	CONSTRUCT DRIVE (R.O.W. ITEMS)
STA 4785+00 — 4787+00 NB RT	STA 4792+00 LT. STA 4798+00 RT.	SB 4785+00 — 4787+00 LT.	TP-19 115+50-13+00 SEE SHEET 663-A

PROPERTY LINE FENCE ITEM 583-II MOD.
SB 4785+00 — 4800+00 LT. NB 4785+00 — 4800+00 RT.

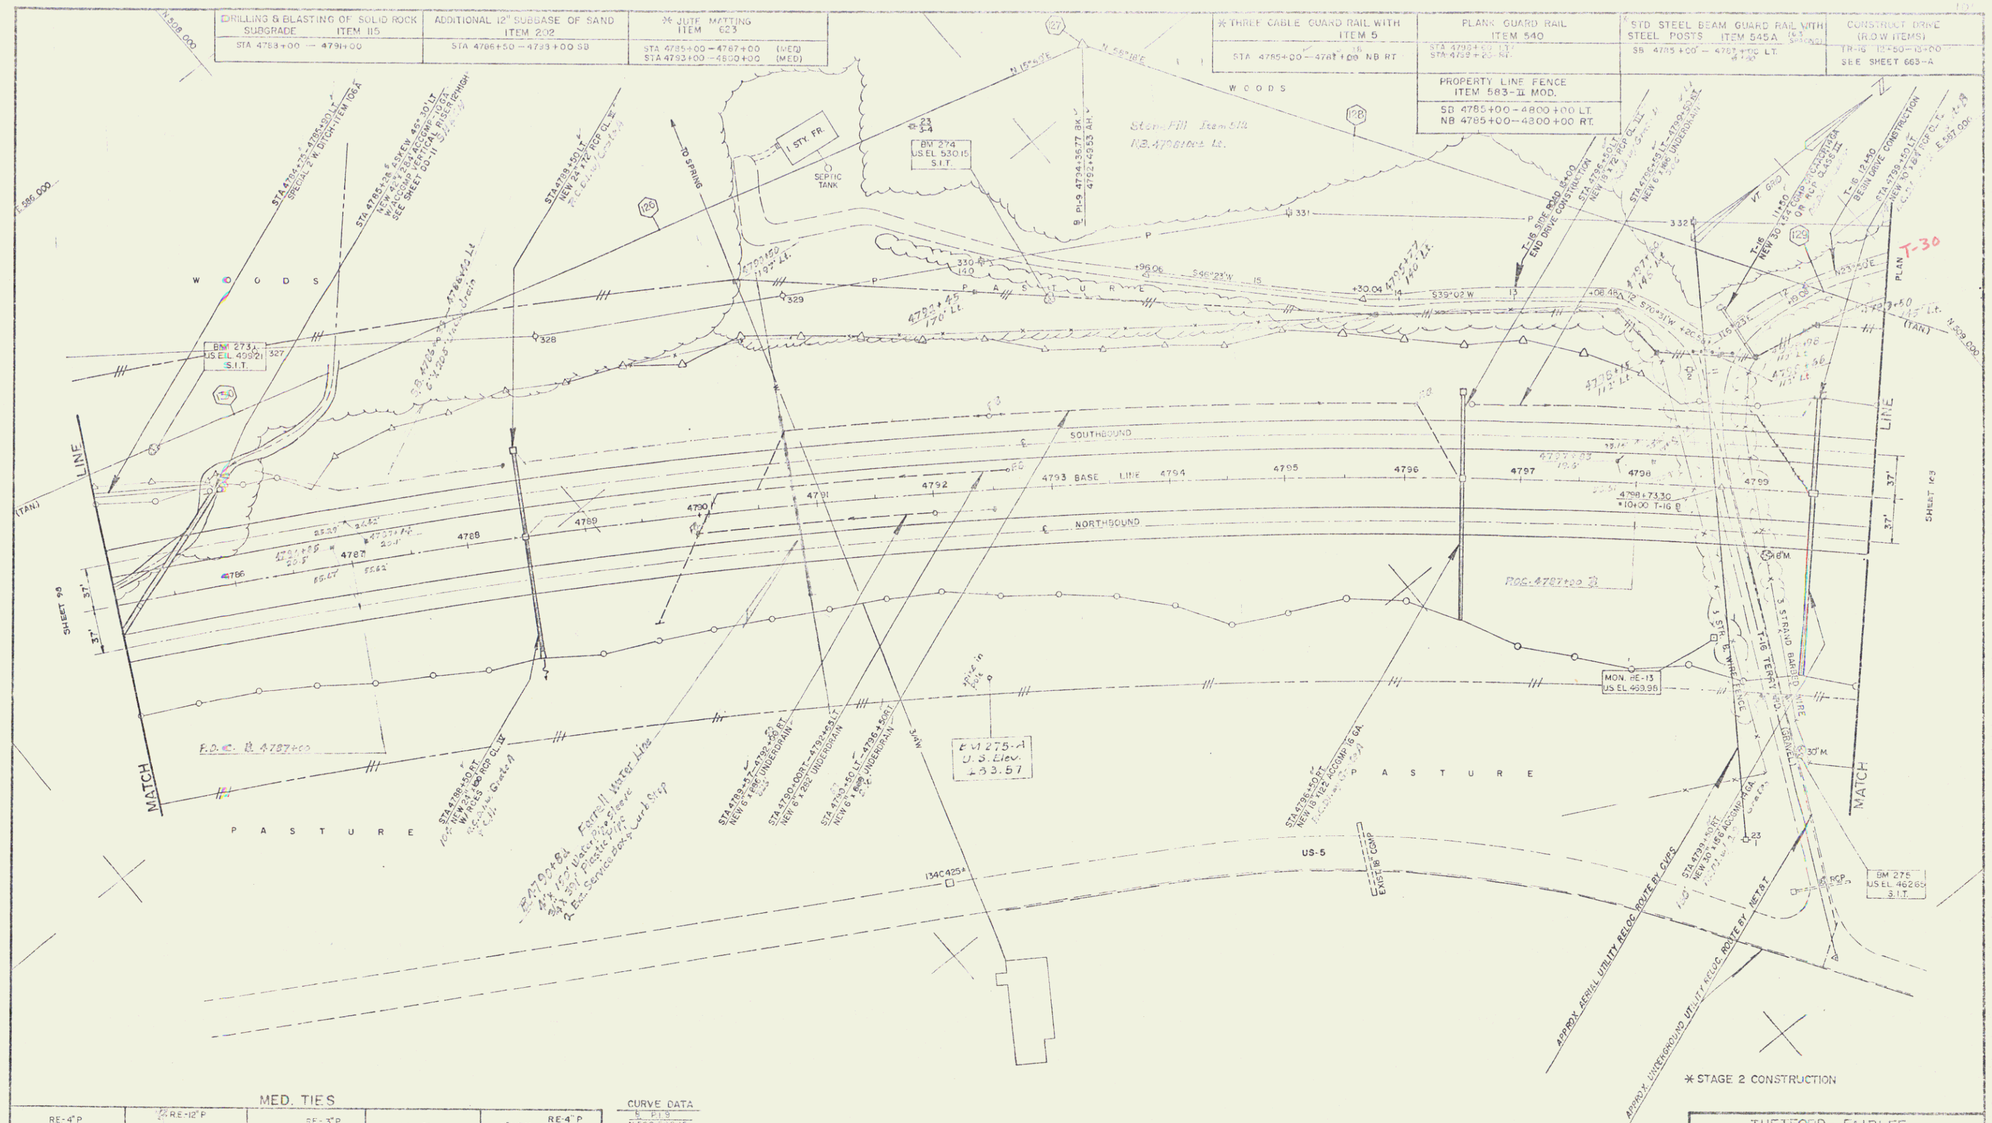

* STAGE 2 CONSTRUCTION

MED. TIES

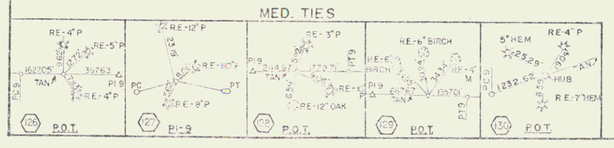

CURVE DATA

℄ PI 9
N 508,525.15
E 586,463.66
D = 1°06'
Δ = 45°29'00"
R = 5200.71'
T = 2024.56'
L = 3662.12'
E = 379.67'
BANK 5/16" PER FT.

CONTROL OF ACCESS IS COMPLETE ON THIS SHEET

PLAN SCALE
0 50 100
100 FEET

THETFORD - FAIRLEE
CONTRACT STAGE 2 CONSTRUCTION
STA. 4785+00 TO STA. 4800+00

PROJECT I 91-2 (9) SHEET 102 OF 659

(247) 70 of 100

87