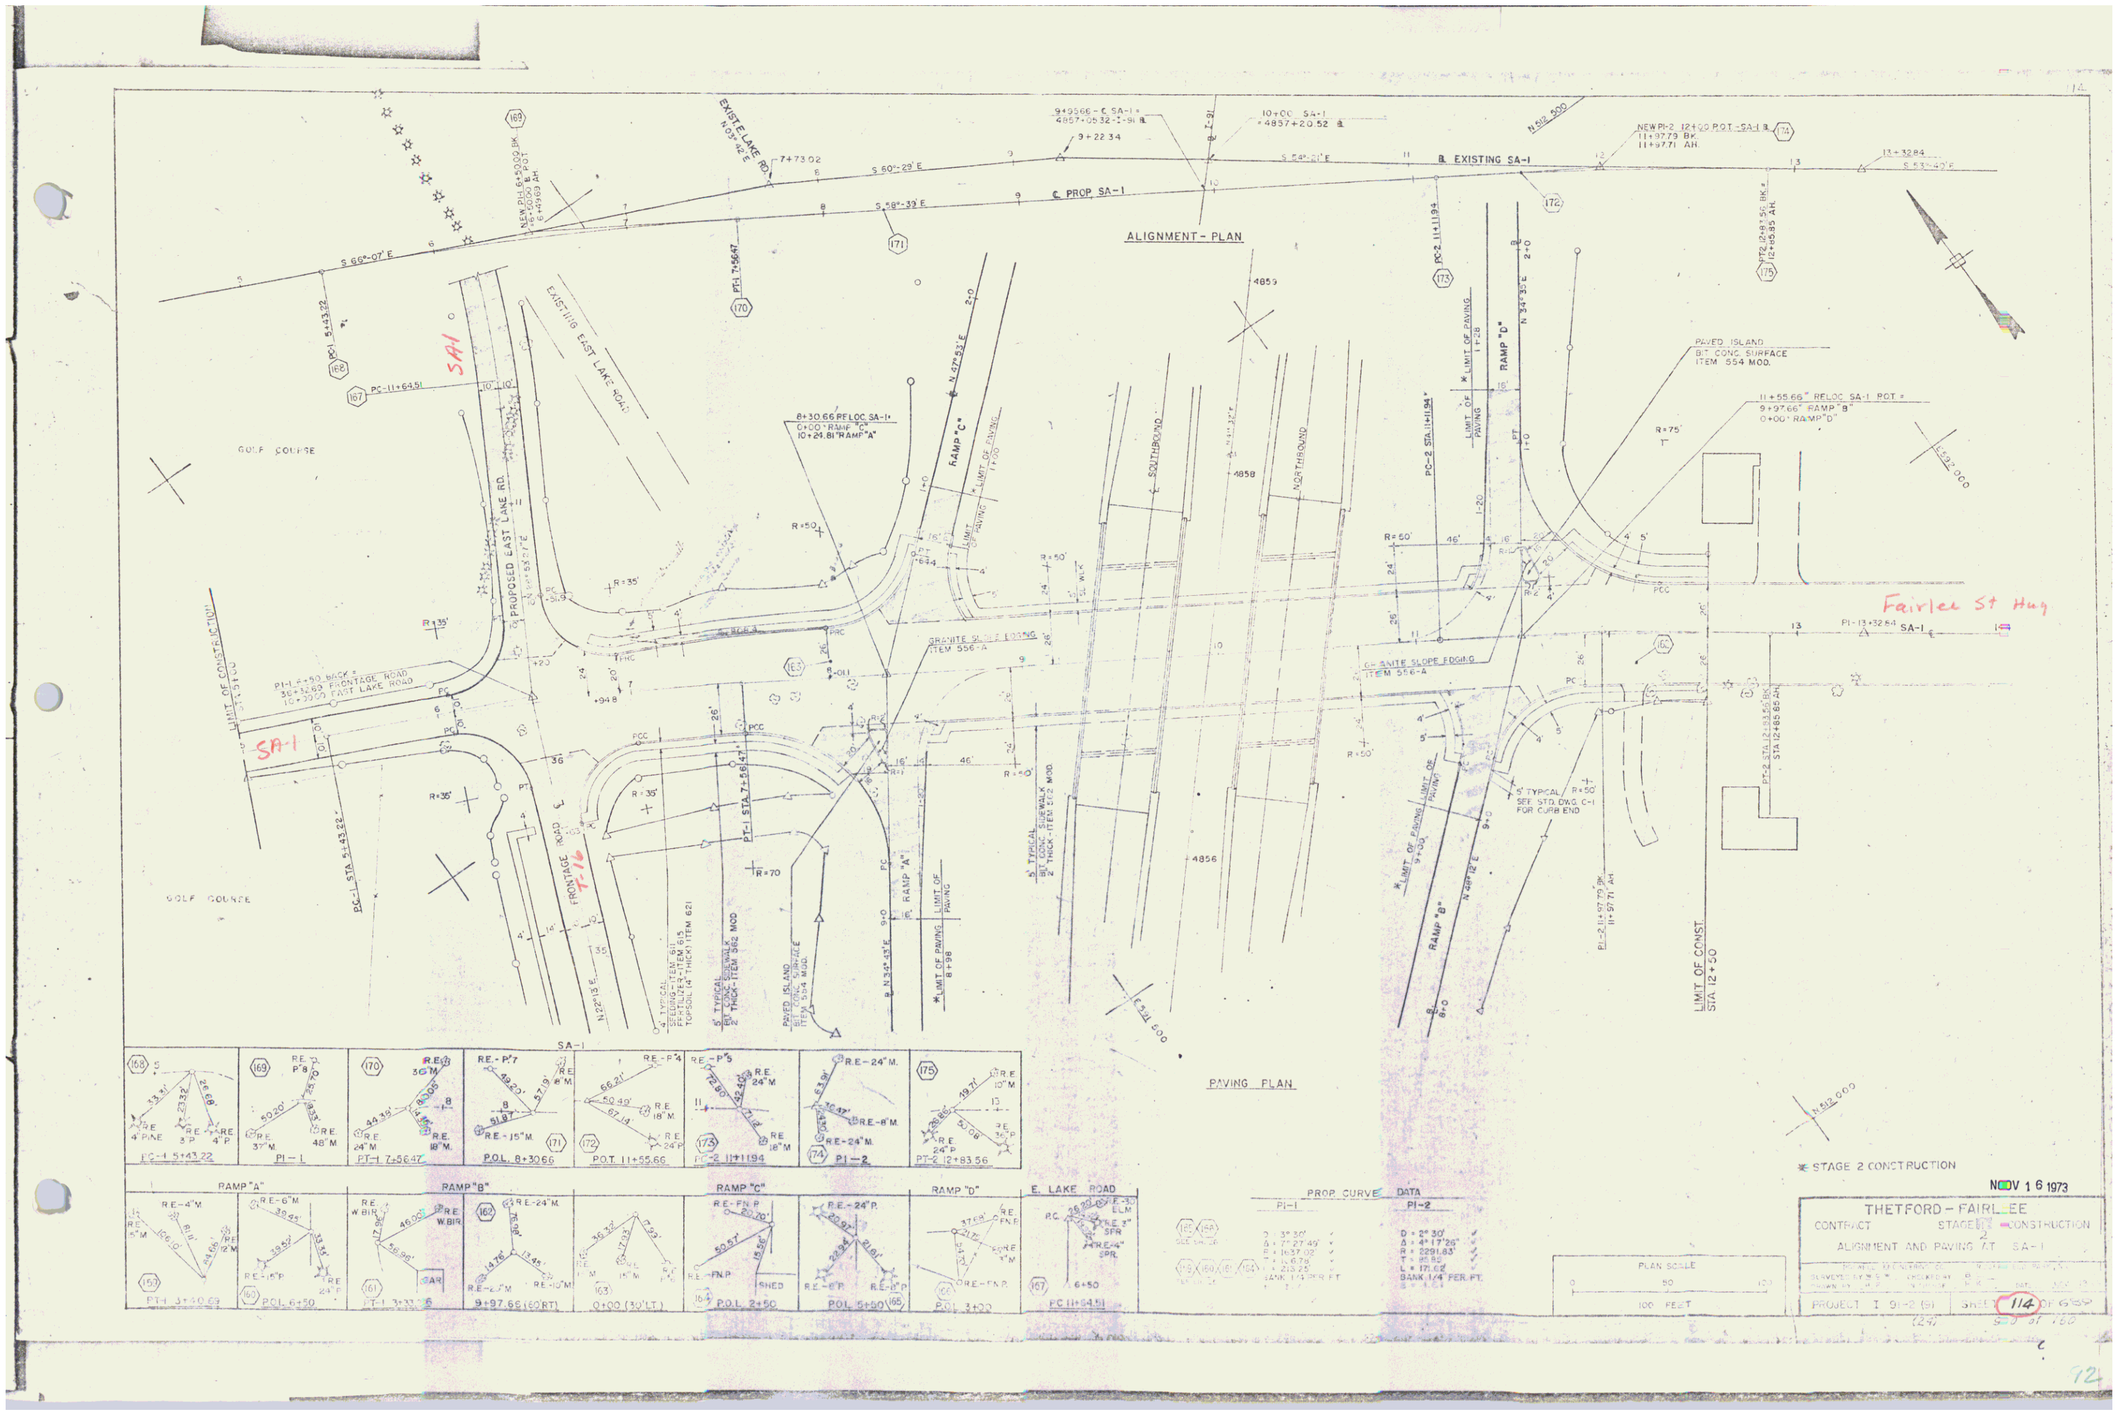
ALIGNMENT - PLAN
PAVING PLAN
℄ EXISTING SA-1
℄ PROP SA-1
EXIST E LAKE RD
EXISTING EAST LAKE ROAD
PROPOSED EAST LAKE RD.
FRONTAGE ROAD
RAMP "A"
RAMP "B"
RAMP "C"
RAMP "D"
SOUTHBOUND
NORTHBOUND
GOLF COURSE
LIMIT OF CONSTRUCTION
LIMIT OF CONST. STA. 12+50
GRANITE SLOPE EDGING ITEM 556-A
PAVED ISLAND BIT. CONC. SURFACE ITEM 554 MOD.
5' TYPICAL SIDEWALK 2" THICK - ITEM 572 MOD
4' TYPICAL SEEDING - ITEM 615 FERTILIZER - ITEM 615 TOPSOIL (4" THICK) ITEM 621
5' TYPICAL SIDEWALK 2" THICK ITEM 572 MOD
5' TYPICAL R=50' SEE STD. DWG. C-1 FOR CURB END
* STAGE 2 CONSTRUCTION
PROP. CURVE DATA
PI-1
PI-2
PLAN SCALE
100 FEET
NOV 16 1973
THETFORD - FAIRLEE
CONTRACT STAGE 2 CONSTRUCTION
ALIGNMENT AND PAVING AT SA-1
PROJECT I 91-2 (9)
SHEET 114 OF 659
Fairlee St Hwy
SA-1