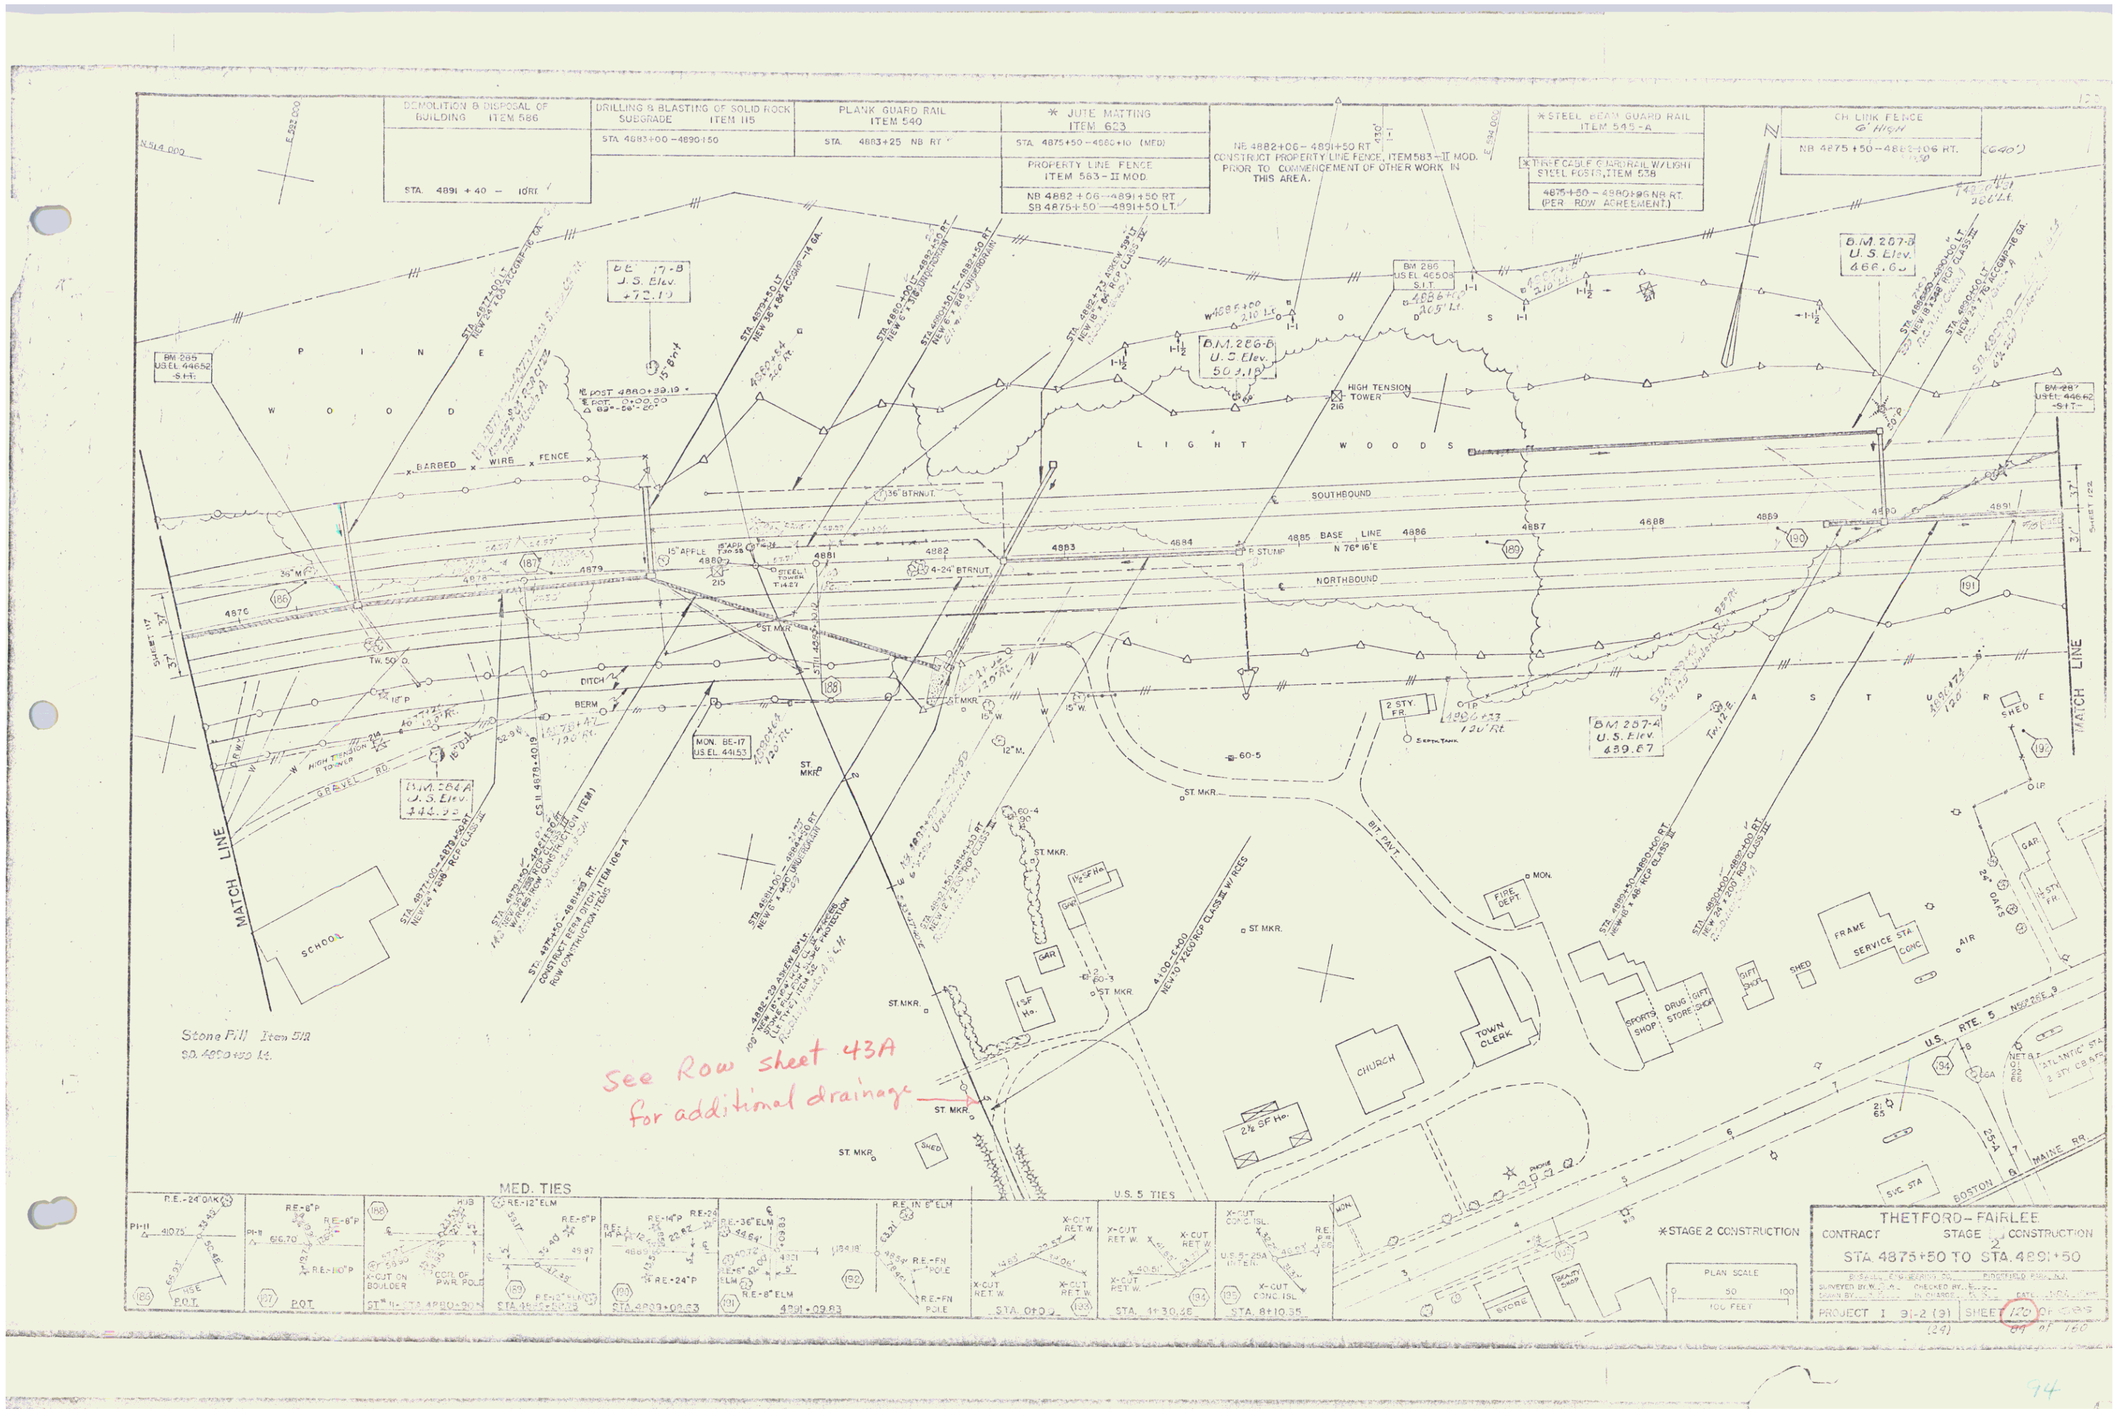
DEMOLITION & DISPOSAL OF BUILDING ITEM 586
STA. 4891 + 40 – 10'RT.
DRILLING & BLASTING OF SOLID ROCK SUBGRADE ITEM 115
STA. 4883+00 – 4890+50
PLANK GUARD RAIL ITEM 540
STA. 4883+25 NB RT
* JUTE MATTING ITEM 623
STA. 4875+50 – 4880+10 (MED)
PROPERTY LINE FENCE ITEM 563 – II MOD.
NB 4882+06 – 4891+50 RT
SB 4875+50 – 4891+50 LT
NB 4882+06 – 4891+50 RT
CONSTRUCT PROPERTY LINE FENCE, ITEM 563 – II MOD. PRIOR TO COMMENCEMENT OF OTHER WORK IN THIS AREA.
*STEEL BEAM GUARD RAIL ITEM 545 – A
*TRI-CABLE GUARDRAIL W/LIGHT STEEL POSTS, ITEM 538
4875+50 – 4890+96 NB RT.
(PER ROW AGREEMENT)
CH. LINK FENCE 6' HIGH
NB 4875+50 – 4882+06 RT.
BM 285 US EL 46.52 S.I.T.
BM 286 US EL 46.508 S.I.T.
BM 287 US EL 46.62 S.I.T.
BM 286-B U.S. Elev. 504.18
BM 287-B U.S. Elev. 466.63
BM 287-A U.S. Elev. 459.67
BM 284-A U.S. Elev. 444.11
BM 284 U.S. Elev. +72.19
MON. BE-17 US EL. 441.53
P I N E
W O O D
L I G H T W O O D S
P A S T U R E
BARBED WIRE FENCE
SOUTHBOUND
NORTHBOUND
BASE LINE N 76° 16' E
HIGH TENSION TOWER
GRAVEL RD.
SCHOOL
CHURCH
TOWN CLERK
FIRE DEPT.
SPORTS SHOP
DRUG & GIFT STORE
GIFT SHOP
FRAME SERVICE STA.
SHED
MATCH LINE
U.S. RTE. 5
BOSTON & MAINE RR.
Stone Fill Item 512
See Row sheet 43A for additional drainage
MED. TIES
U.S. 5 TIES
*STAGE 2 CONSTRUCTION
PLAN SCALE 50 100 100 FEET
THETFORD – FAIRLEE
CONTRACT STAGE 2 CONSTRUCTION
STA. 4875+50 TO STA. 4891+50
PROJECT I 91-2 (9) SHEET 120 OF 144

74