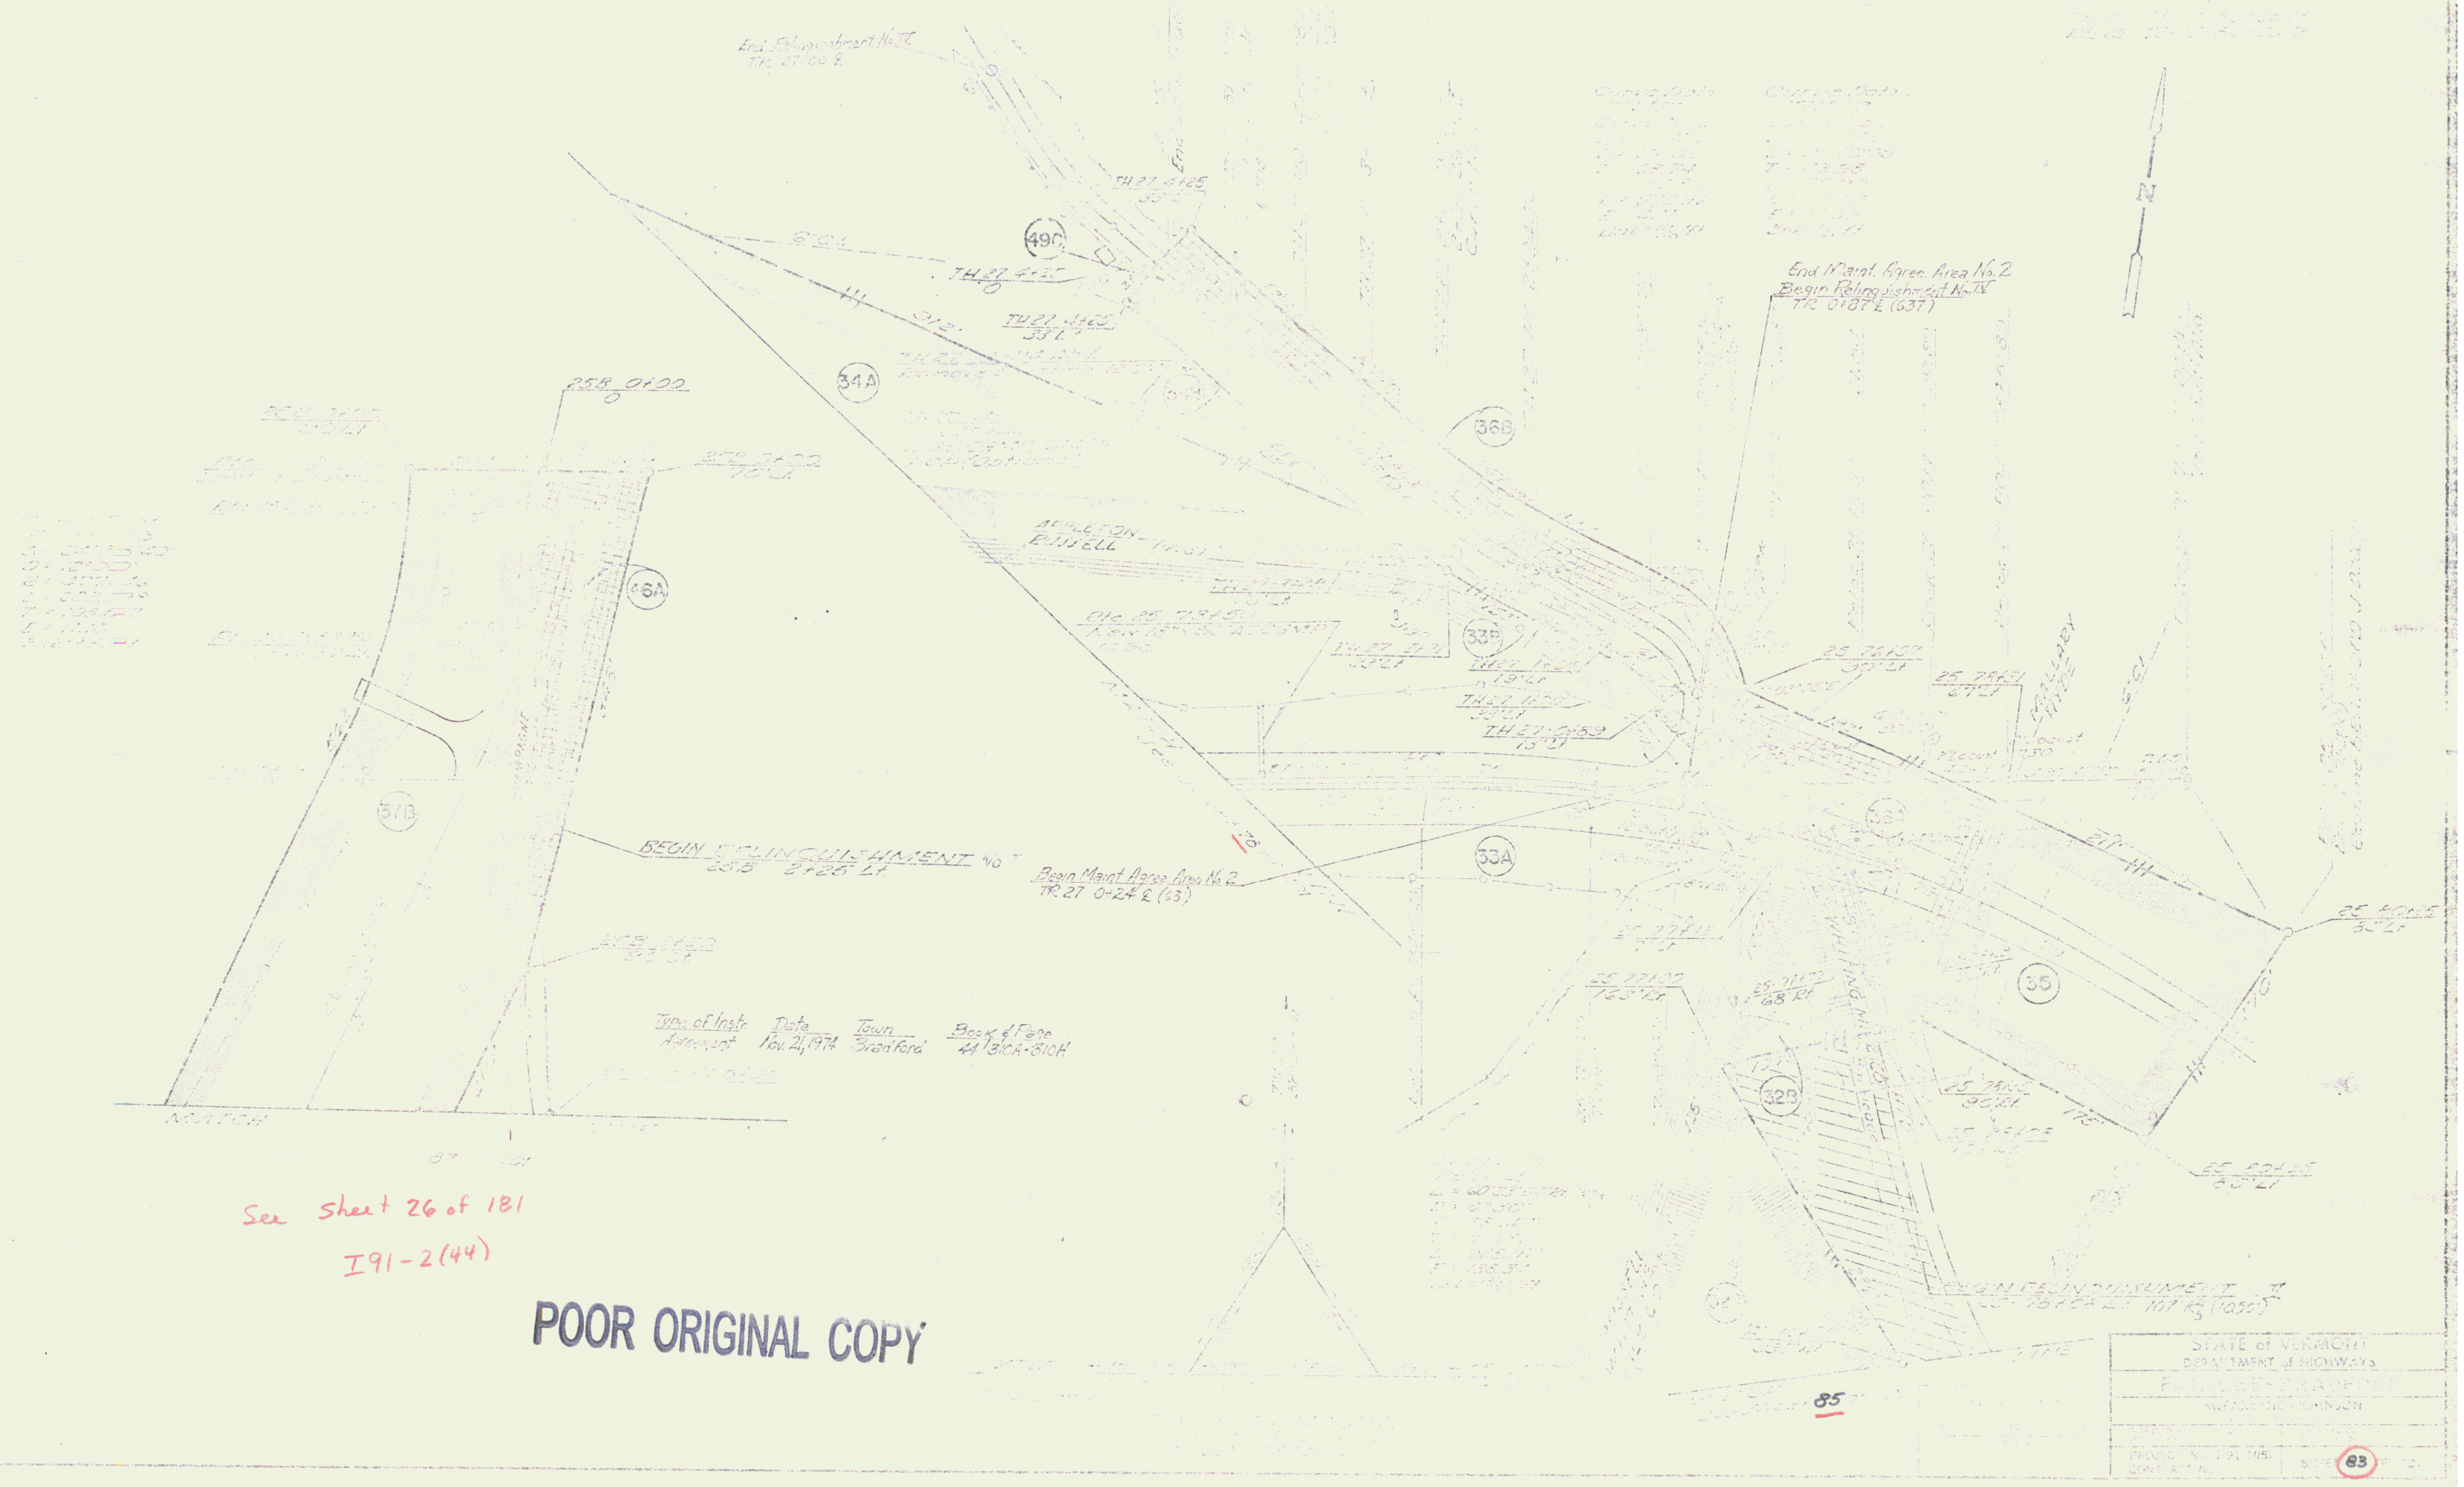

Type of Instr.	Date	Town	Book & Page
Agreement	Nov. 21, 1974	Bradford	44/310A-310H

See Sheet 26 of 181
I91-2(44)

POOR ORIGINAL COPY

85

R.O.W/const

41