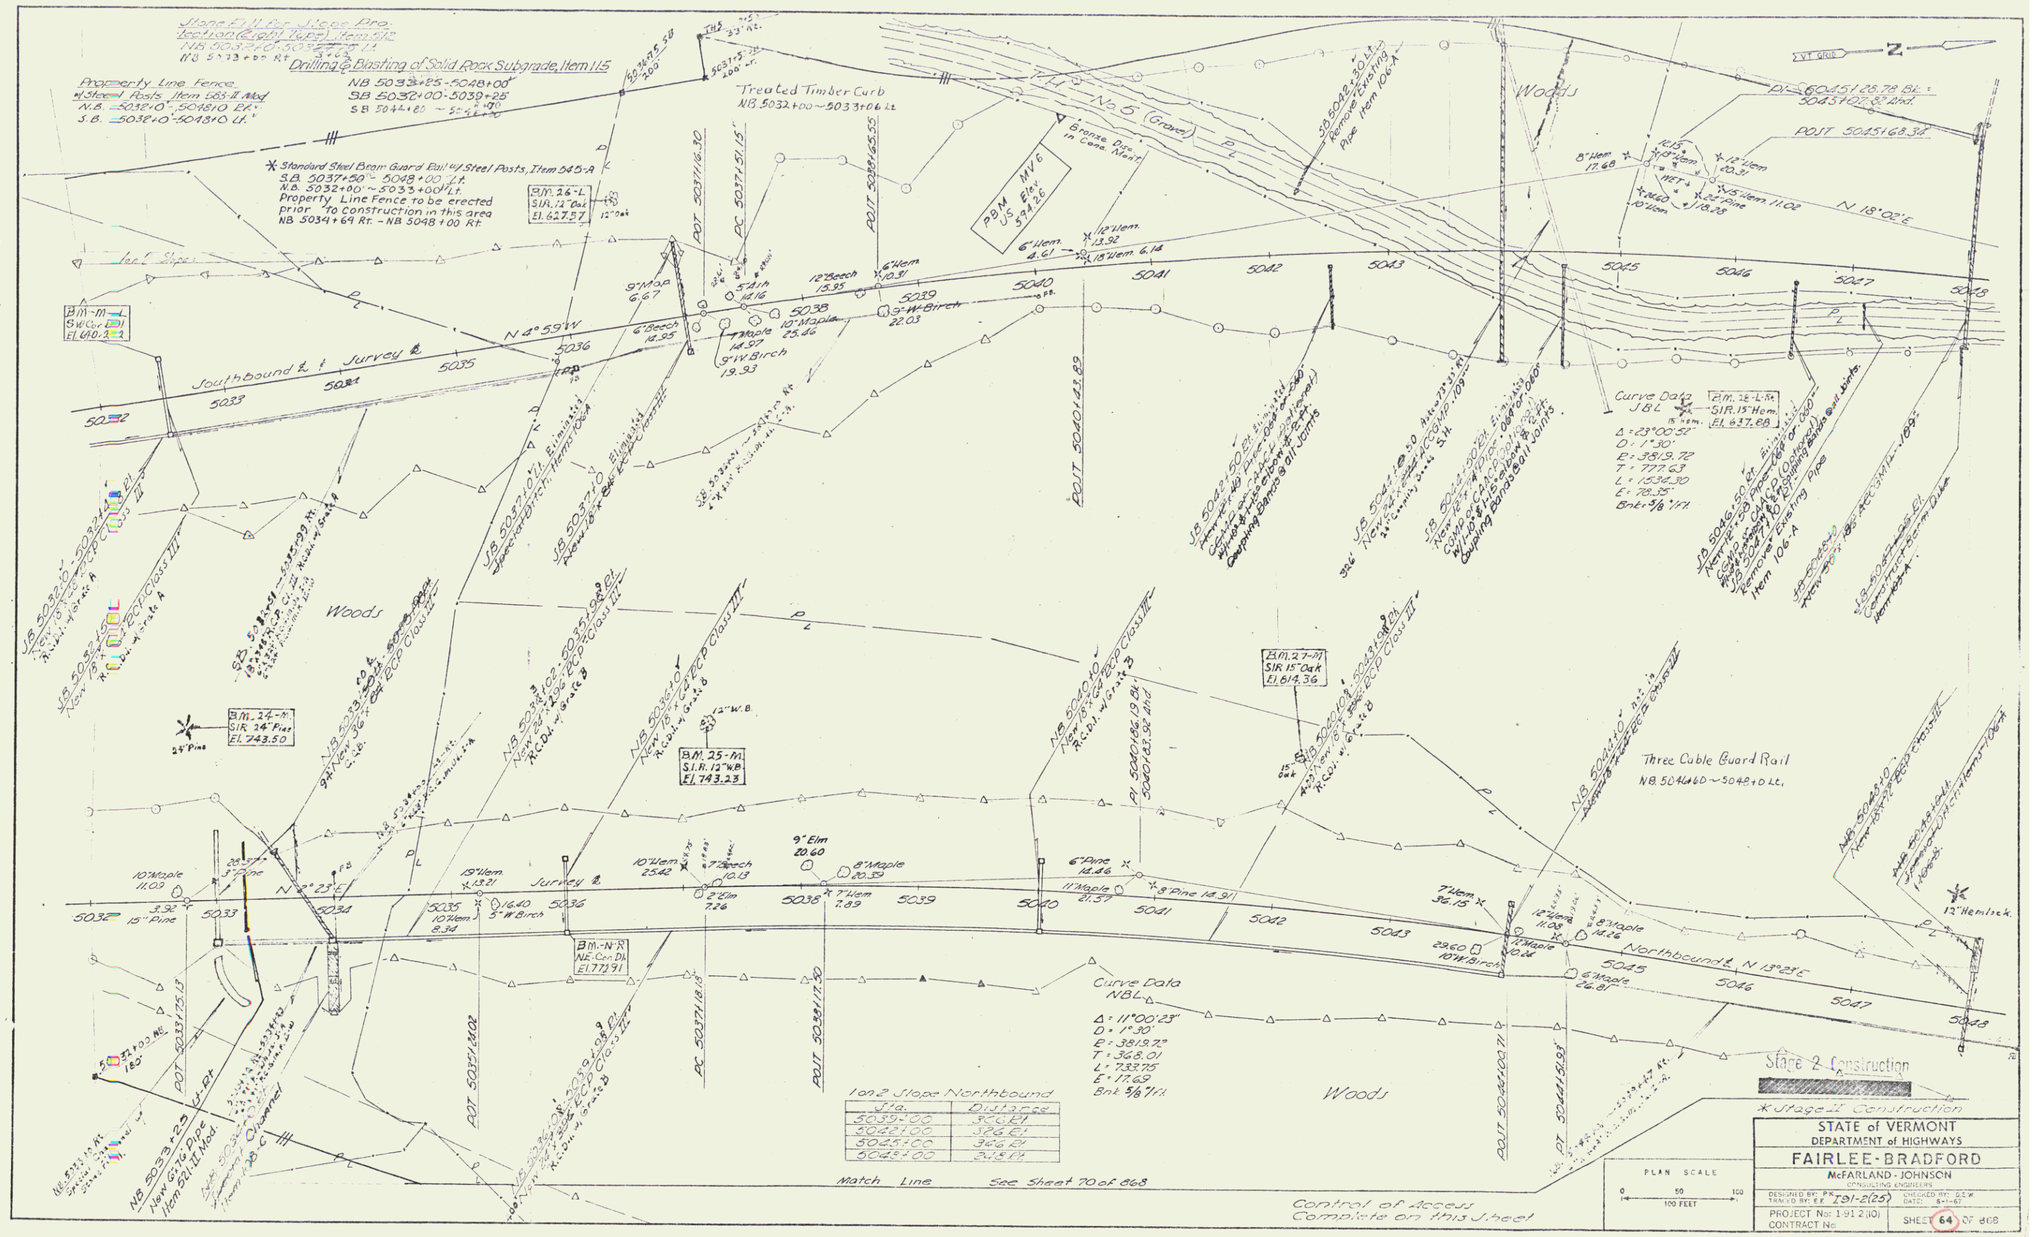
Drilling & Blasting of Solid Rock Subgrade, Item 115
Property Line Fence
Treated Timber Curb
Three Cable Guard Rail
Southbound ℄ Survey ℄
Northbound ℄ N 13°23'E
Woods
Curve Data SBL
Curve Data NBL
Match Line See Sheet 70 of 868
Control of Access Complete on Plan Sheet
Stage 2 Construction
Stage 2 Construction
STATE of VERMONT
DEPARTMENT of HIGHWAYS
FAIRLEE-BRADFORD
McFARLAND-JOHNSON
CONSULTING ENGINEERS
PLAN SCALE
PROJECT No: I-91-2(10)
CONTRACT No:
SHEET 64 OF 868
