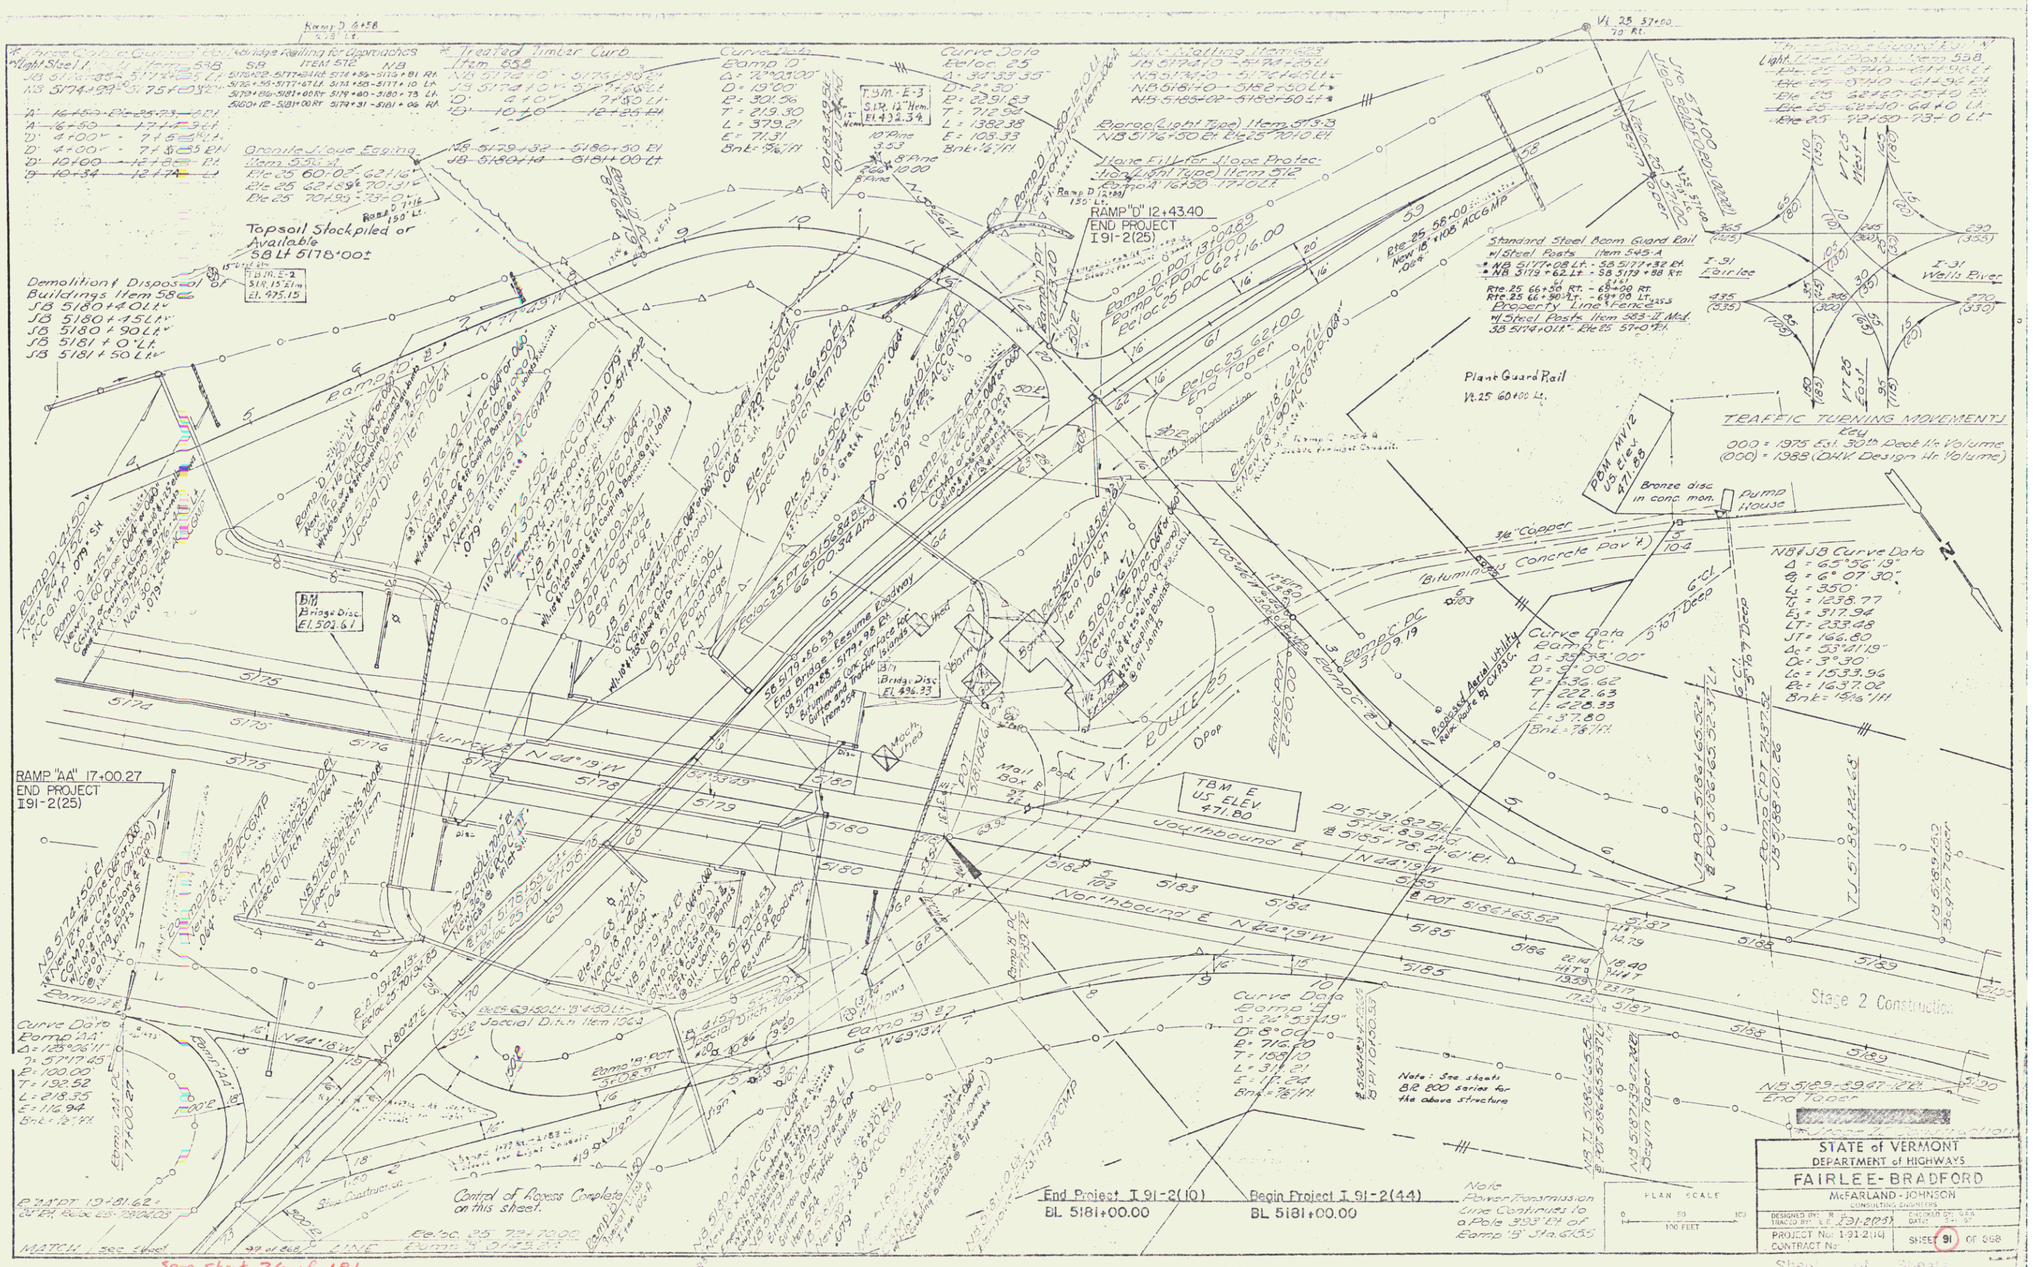

See sheet 26 of 181
I 91-2(44)