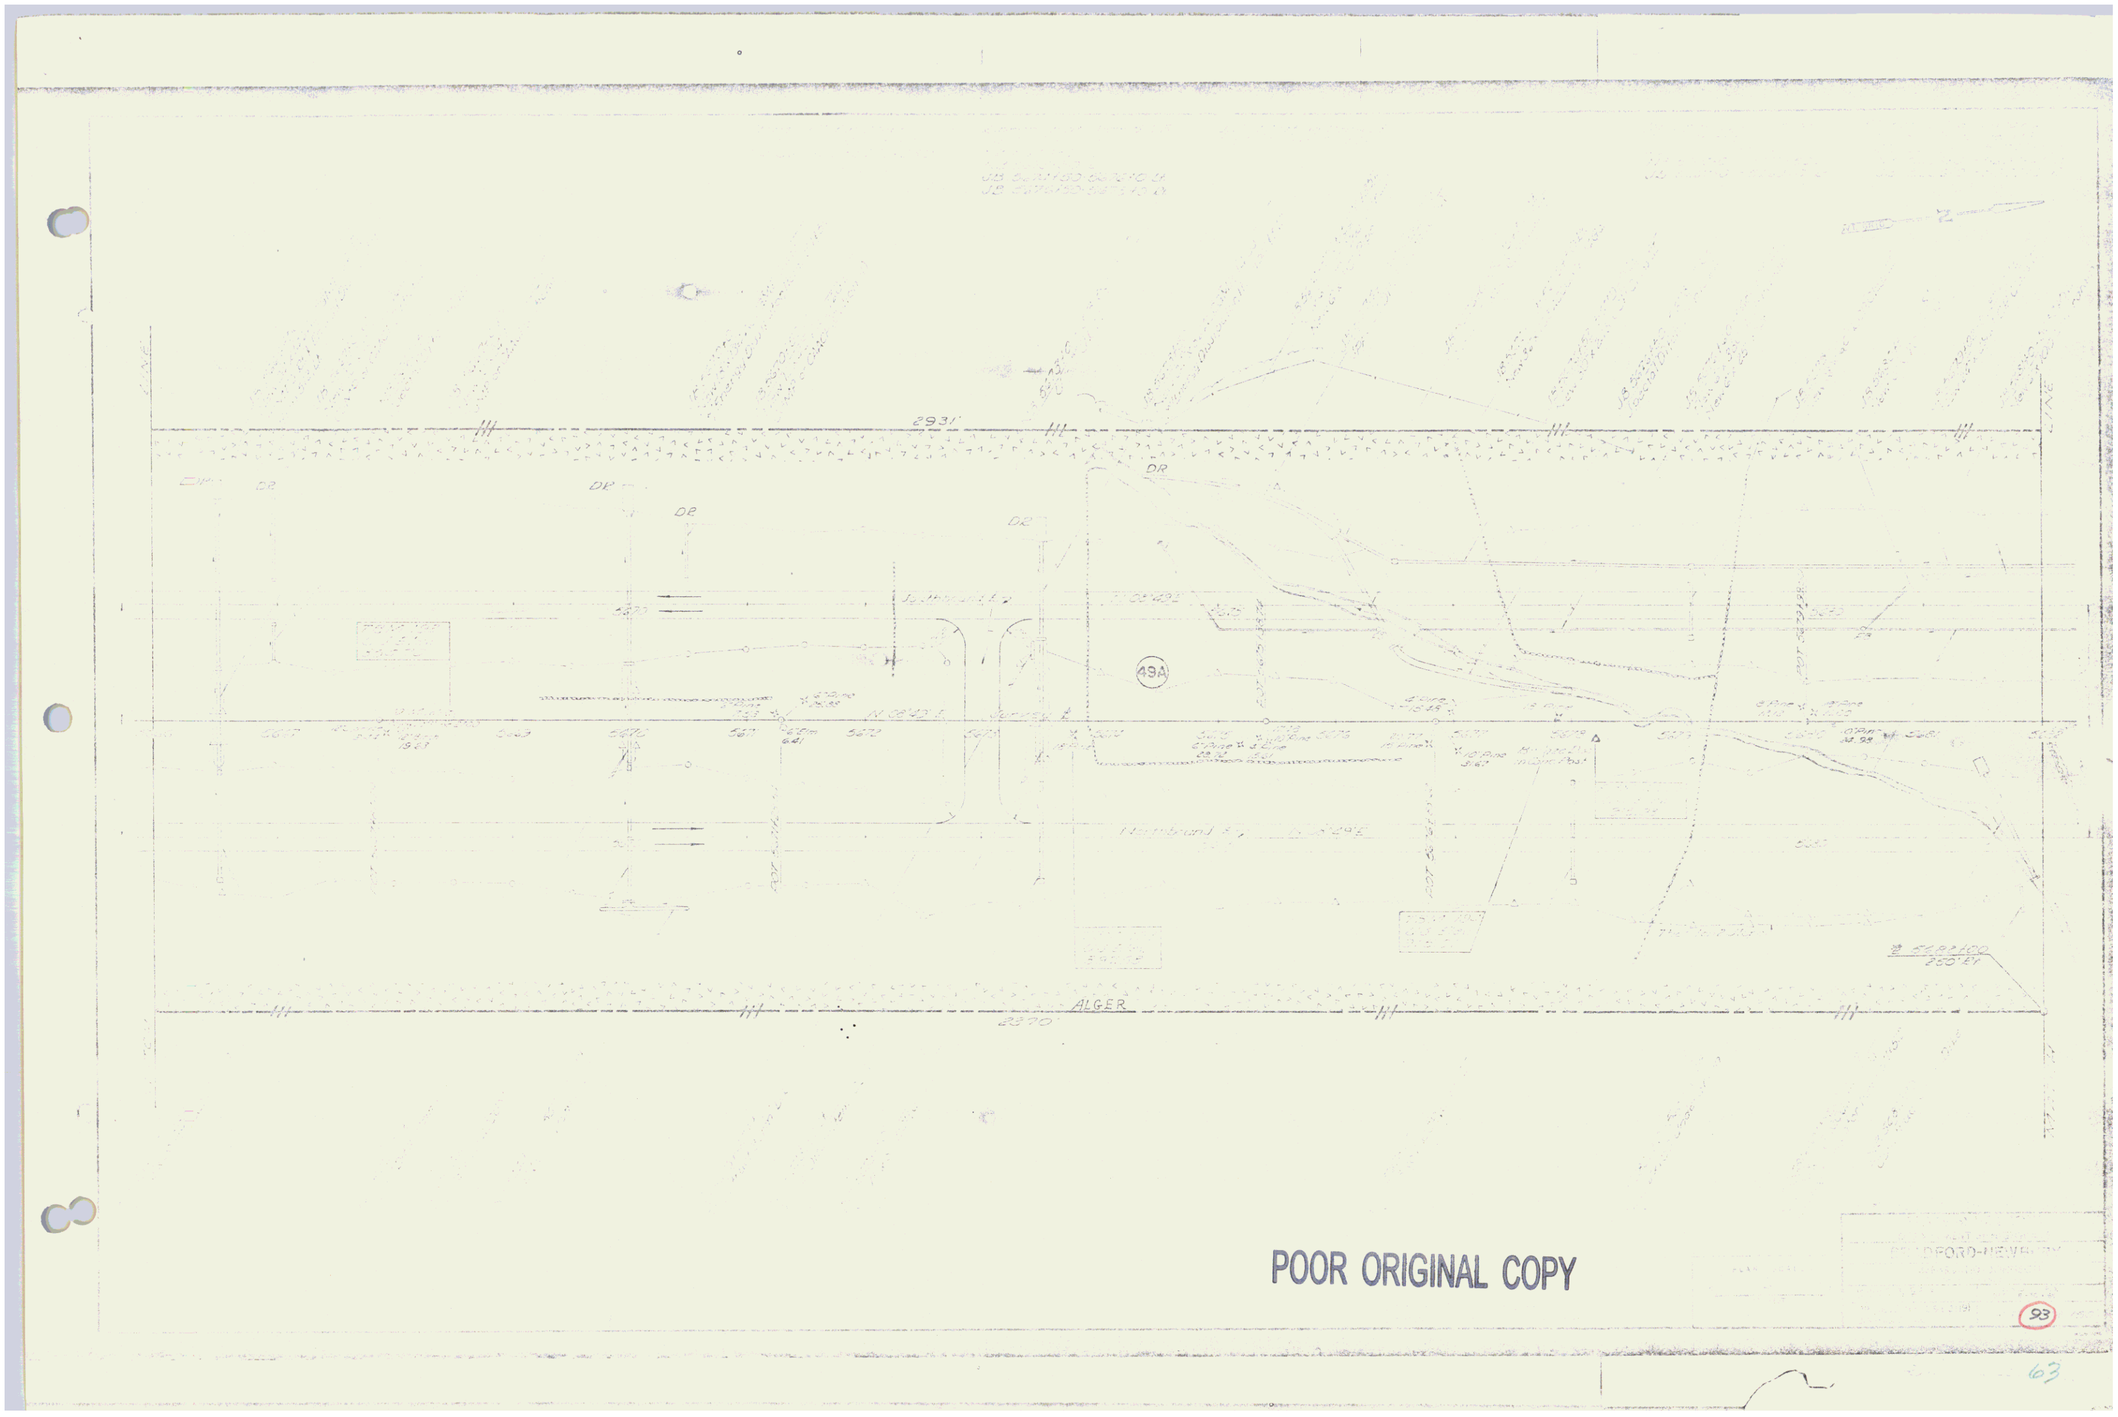

POOR ORIGINAL COPY

93

63