Woven Wire Fence w/Steel Posts
NB 5368+00 - 5384+00 Rt
SB 5368+00 - 5384+00 Lt

Drilling and Blasting of Solid Rock Subgrade
SB 5375+40 - 5377+10
SB 5378+40 - 5384+0
NB 5376+75 - 5384+0

Stone Fill - Type I
NB 5372+70 - 5372+30 Lt
NB 5376+0 - 5378+50 Rt
SB 5371+75 - 5373+75 Rt
NB 5372+85 - 5376+25 Rt
Stone Fill - Type II
NB 5373+0 Rt
NB 5376+0 Rt

Jute Matting
~~NB 5368+10 - 5369+75 Lt~~
~~NB 5368+10 - 5371+25 Rt~~
~~SB 5368+50 - 5370+50 Lt~~
NB 5372+0 - 5372+45 Lt
NB 5372+55 - 5372+50 Lt
~~SB 5375+60 - 5380+45 Rt~~
~~NB 5377+15 - 5378+75 Lt~~
~~NB 5379+0 - 5379+75 Rt~~

* Treated Timber Curb
JB 5371+70 - 5373+45 Lt

* Guard Rail Three Cable
w/ Light Steel Posts
~~JB 5371+00 - 5372+45 Lt~~
~~NB 5370+50 - 5372+45 Lt~~
SB 5371+70 ~ 5373+25 Lt
NB 5371+0 ~ 5373+35 Rt

Curve Data
NB & JB
Δ = 10°25'00"
D = 0°30'
R = 11459.16'
T = 1044.55'
L = 2083.33'
E = 47.51'
Bnk: 0.021 ft/ft

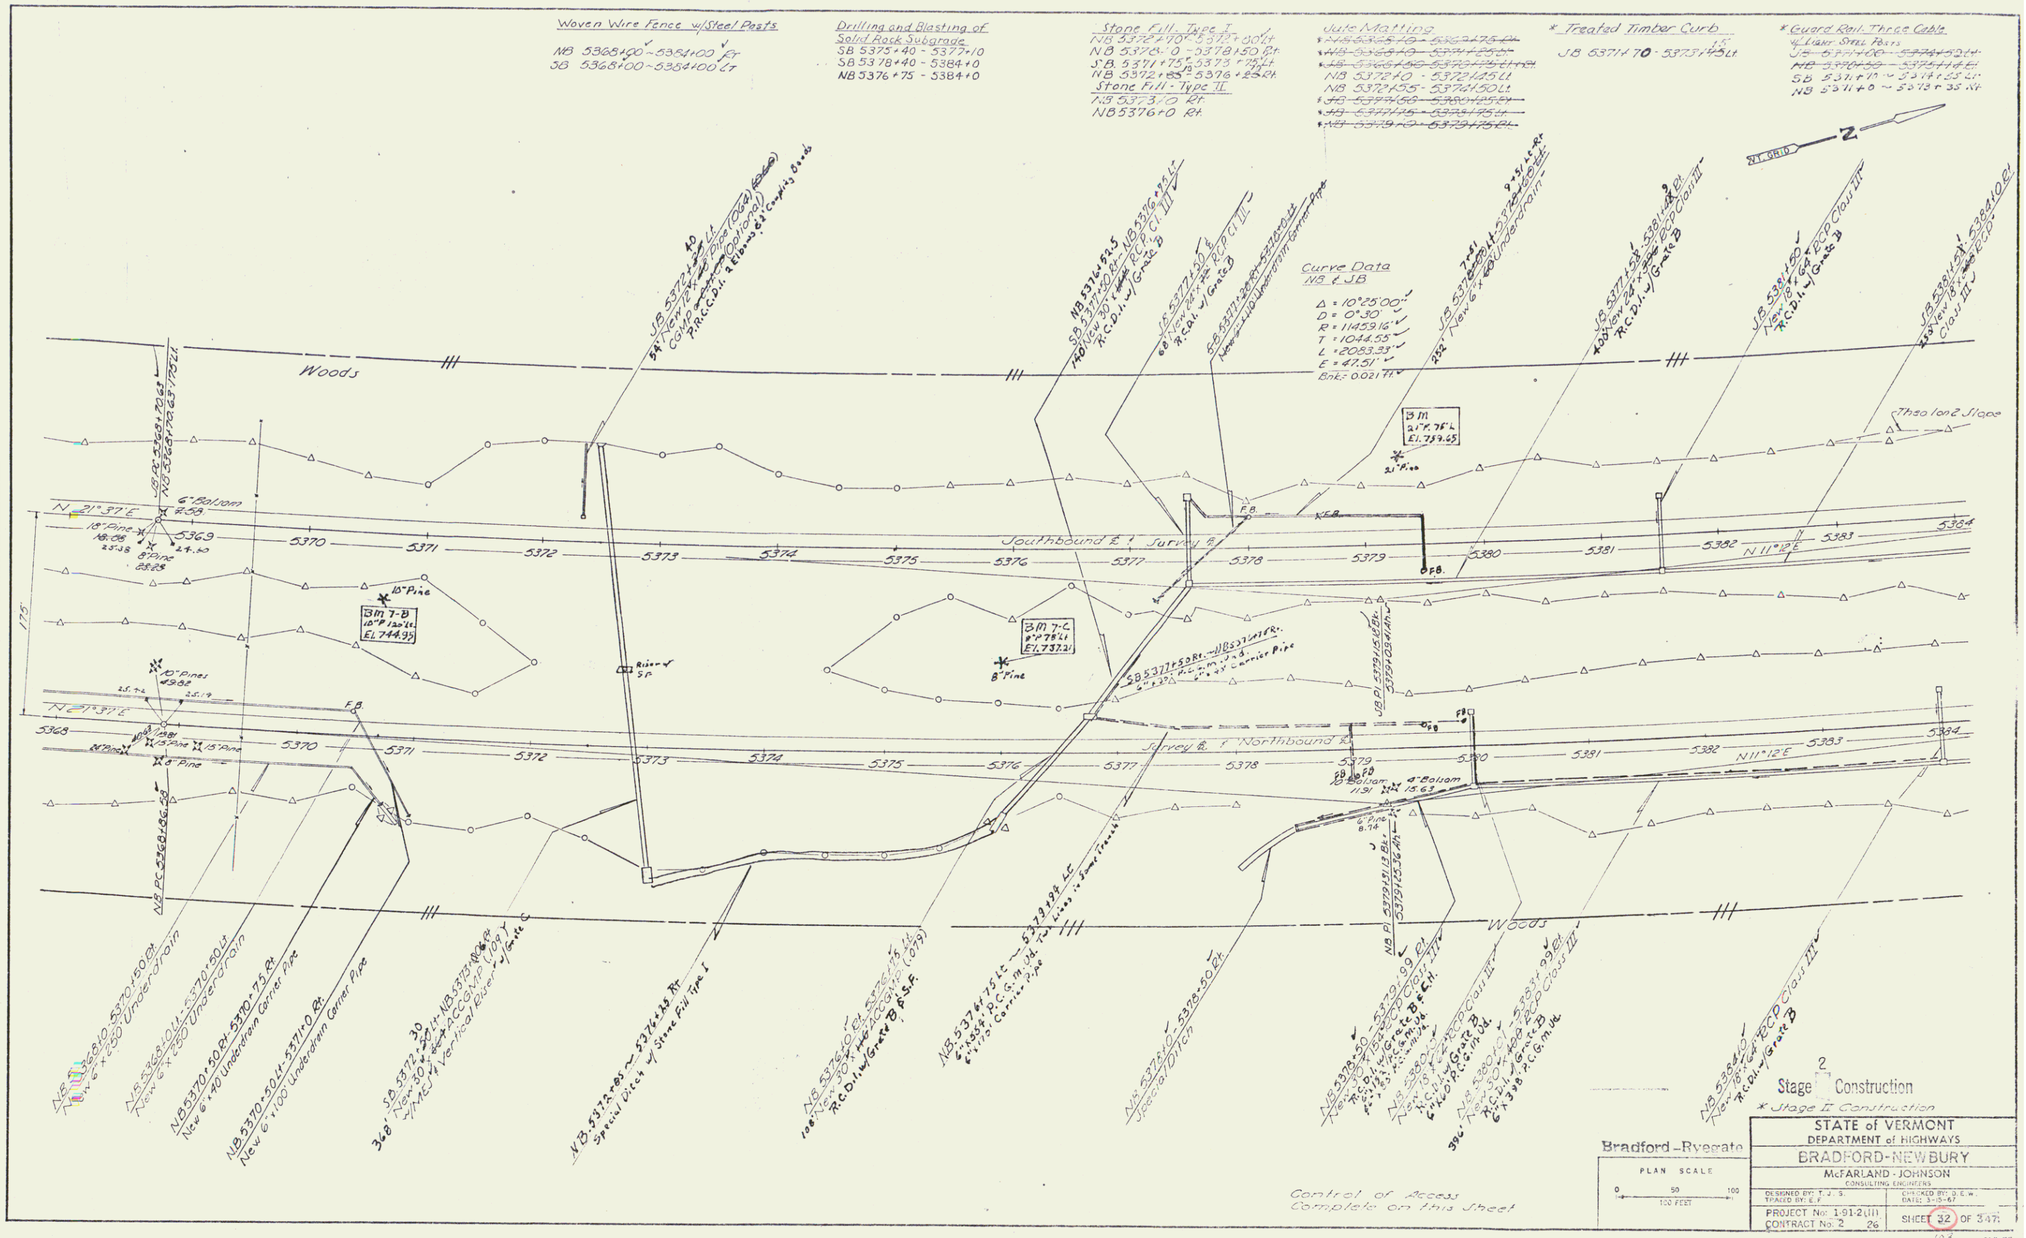

Stage 2 Construction
* Stage I Construction

Bradford-Ryegate

PLAN SCALE
0 50 100
100 FEET

STATE of VERMONT
DEPARTMENT of HIGHWAYS
BRADFORD-NEWBURY
McFARLAND-JOHNSON
CONSULTING ENGINEERS
DESIGNED BY: T. J. S.
TRACED BY: E.F.
CHECKED BY: D.E.W.
DATE: 3-13-67
PROJECT No. I-91-2(11)
CONTRACT No. 2
SHEET 32 OF 347

PLAN
PROFILE SCALE
PROFILE SCALE
NO.
DATE
REVISED
REVISED
REVISED