

Curve Data  
 NB1 JB  
 Δ: 10° 25' 00"  
 D: 0' 30"  
 B: 1145.916'  
 T: 1044.35'  
 L: 208.33'  
 E: 41.5'  
 Bk: 0.021 R.I.F.

Drilling and Blasting of  
 Solid Rock Subgrade  
 NB 5384+0 - 5391+30  
 SB 5384+0 - 5389+0

Sand Barrow  
 NB 5392+00 - 5396+50



Woven Wire Fence w/Steel Posts  
 NB 5384+00 - 5400+00 R  
 SB 5384+00 - 5400+00 L

Auto Mailing  
 NB 5382+04 - 5393+50 L.H. of

QCD to Putnam W. Blodgett  
 dated Jan 27, 1998  
 recorded 2/19/98 in BK 88  
 Pages 88, 881  
 Bradford Land  
 Records

QCD to Putnam W. Blodgett  
 dated Jan 27, 1998  
 recorded June 23, 1998  
 in BK 111 Pg. 54-55  
 Newbury Land  
 Records

25' easement of ingress  
 & egress

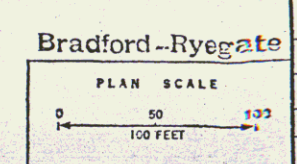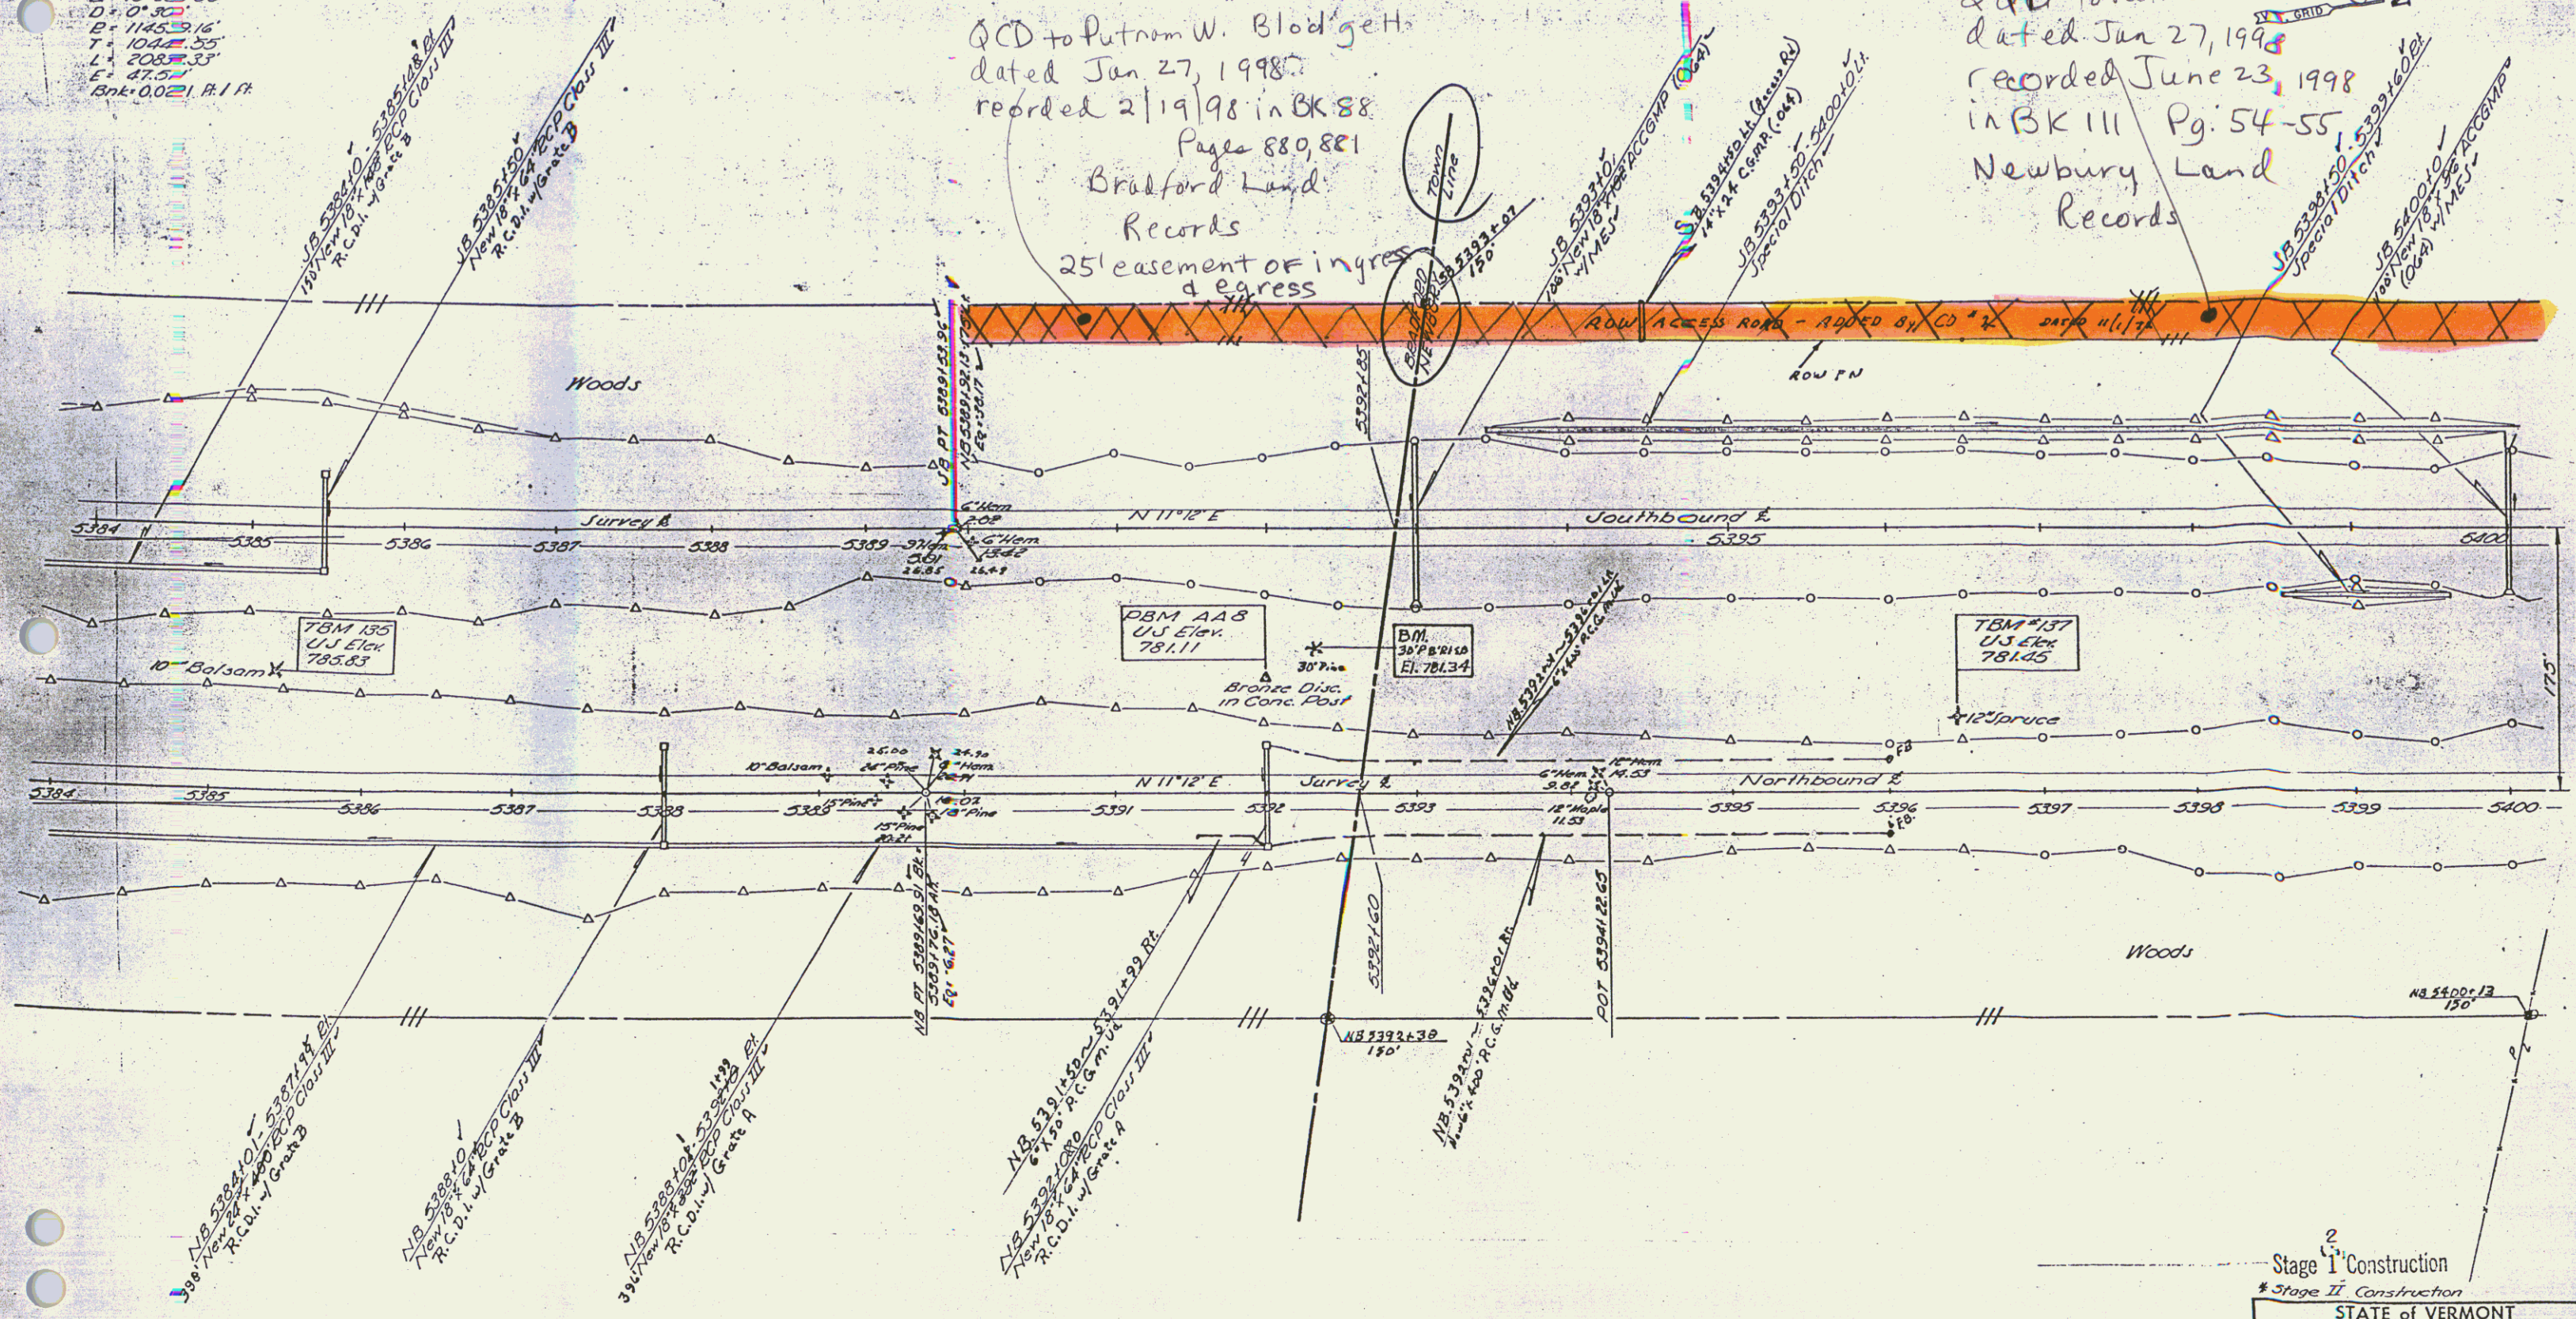

Stage I Construction	
* Stage II Construction	
STATE of VERMONT DEPARTMENT of HIGHWAYS	
BRADFORD-NEWBURY	
McFARLAND-JOHNSON CONSULTING ENGINEERS	
DESIGNED BY: T.A.S.	CHECKED BY: D.E.W.
TRACED BY: E.F.	DATE: 3-15-98
PROJECT No: 1-91-2(11)	SHEET 34 OF 347
CONTRACT No: 2	26

Control of Access  
 Complete on this Sheet

78