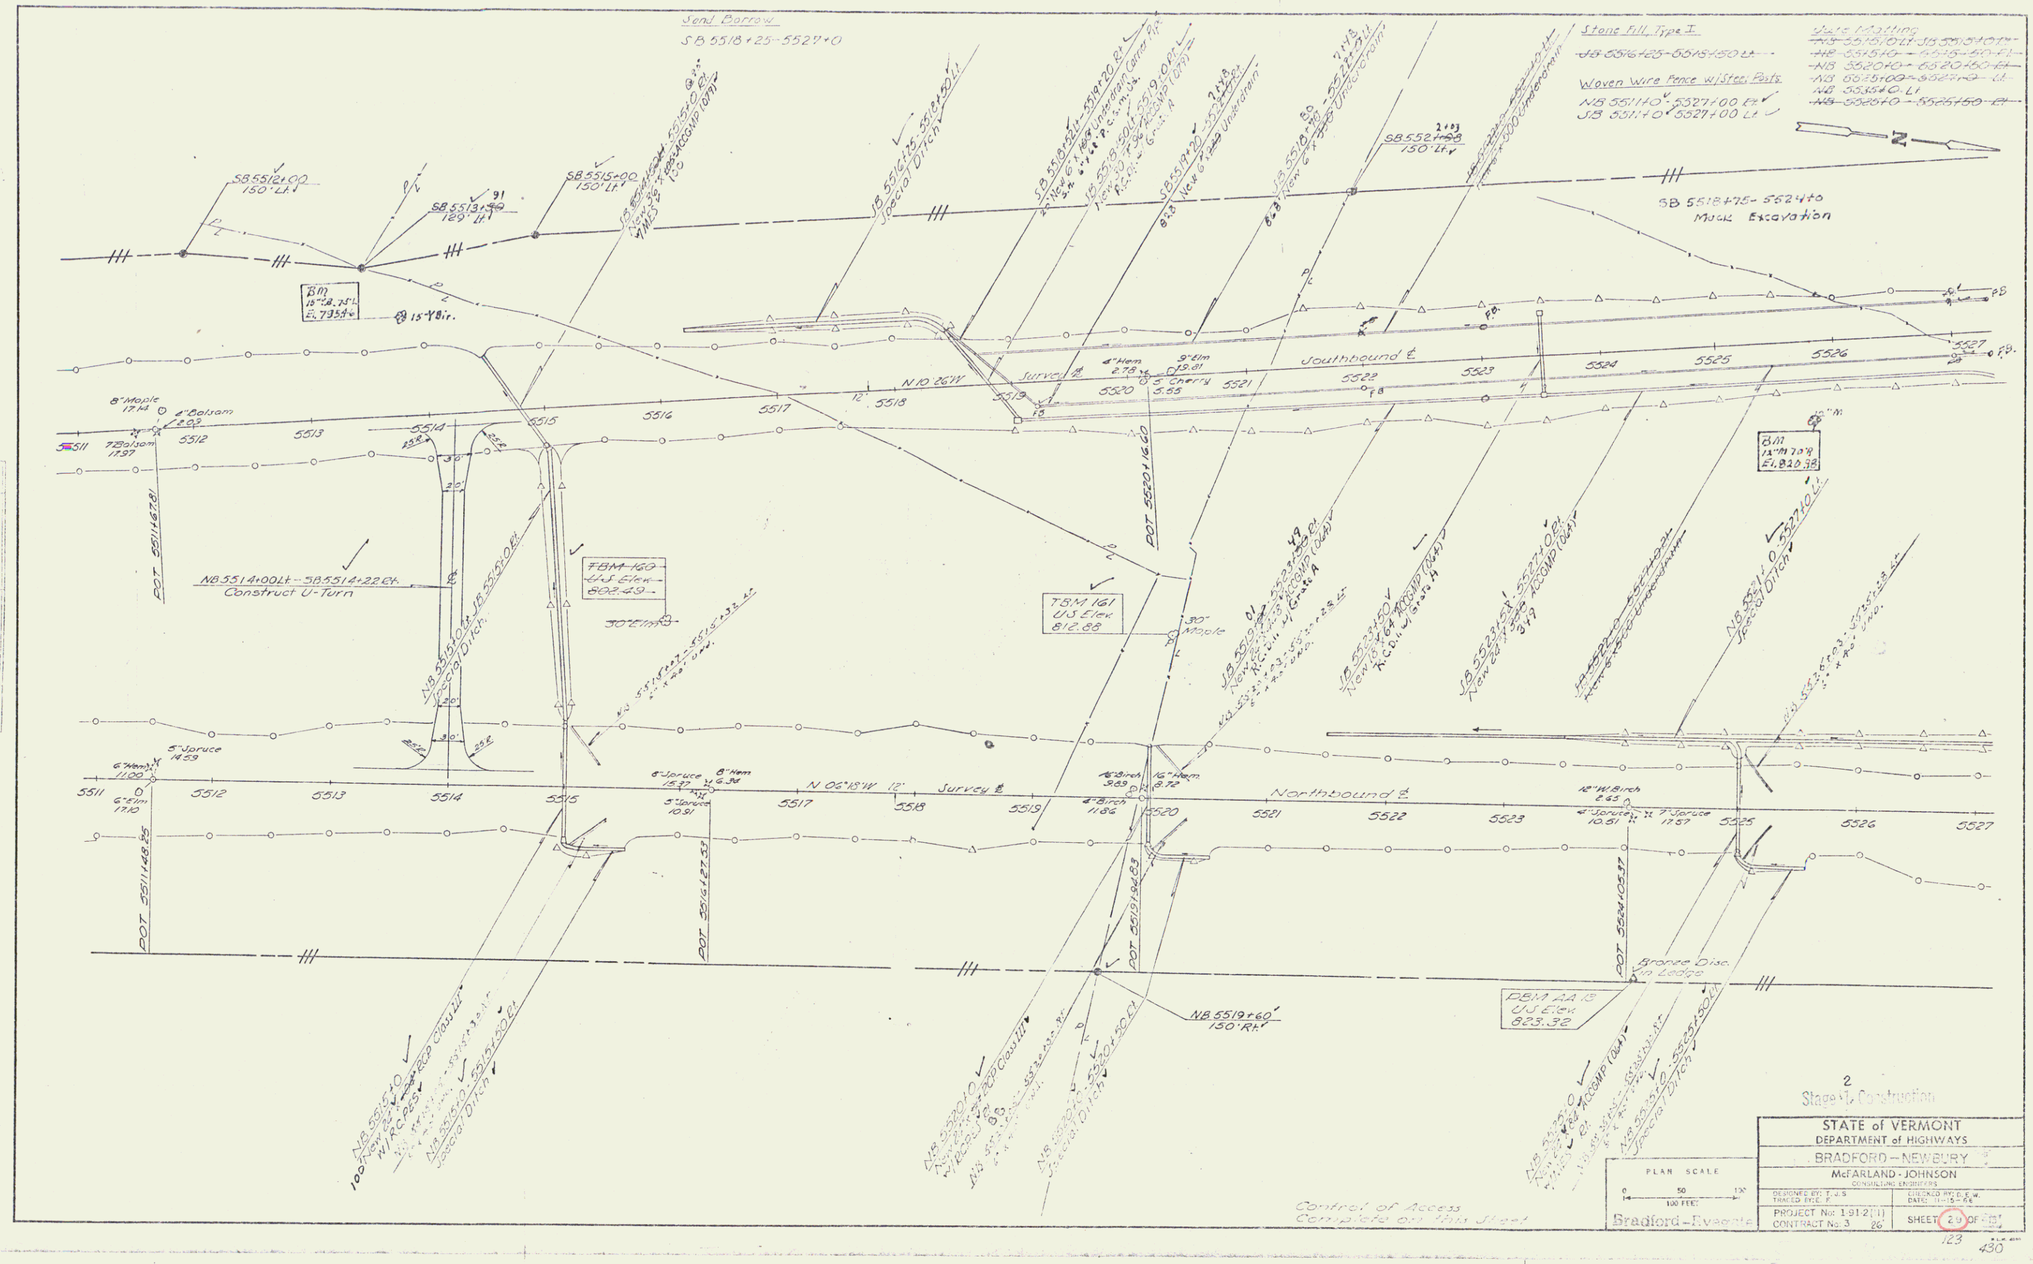
Sand Borrow
SB 5518+25-5527+0
Stone Fill, Type I
SB 5516+25-5518+50 Lt.
Woven Wire Fence w/Steel Posts
NB 5511+0-5527+00 Rt.
SB 5511+0-5527+00 Lt.
Wire Matting
SB 5518+75-5524+50
Muck Excavation
Southbound ℄
Northbound ℄
Survey ℄
N 10°26'W
N 06°18'W
Construct U-Turn
NB 5514+00 Lt.-SB 5514+22 Rt.
TBM-160
U.S. Elev.
802.49
TBM 161
U.S. Elev.
812.88
U.S. Elev.
823.32
NB 5519+60
150' Rt.
Bronze Disc
in Ledge
Control of Access
Stage II Construction
STATE of VERMONT
DEPARTMENT of HIGHWAYS
BRADFORD – NEWBURY
McFARLAND-JOHNSON
CONSULTING ENGINEERS
PLAN SCALE
50
100 FEET
Bradford-Ryegate
PROJECT No: 1-91-2(11)
CONTRACT No: 3
SHEET 29 OF 29
123
430
R.C.W./Const. 113