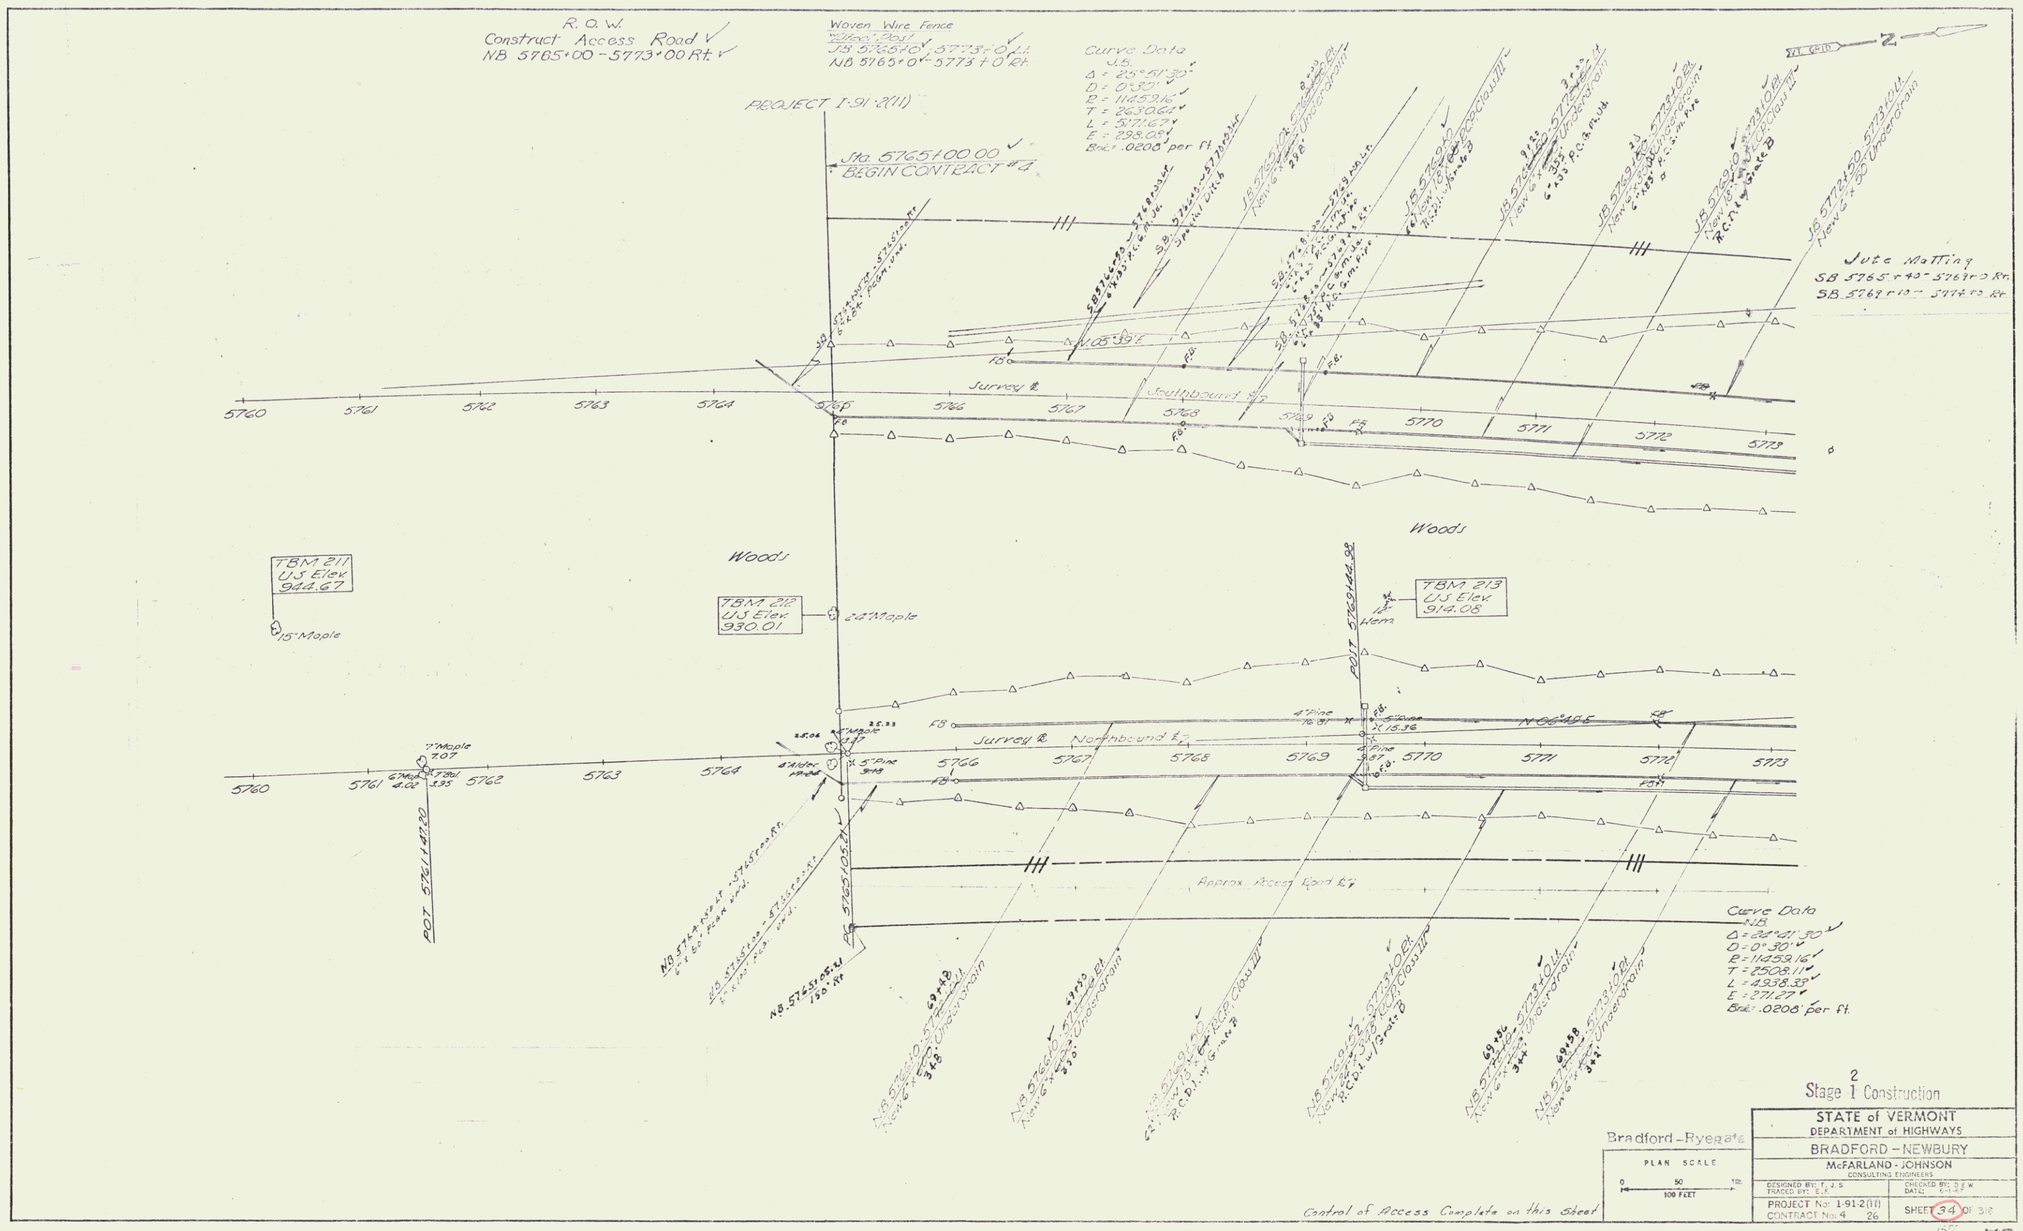
R. O. W.
Construct Access Road
NB 5785+00 - 5773+00 Rt.
Woven Wire Fence
Wire, Posts
SB 5766+10 - 5773+0 Lt.
NB 5765+0 - 5773 + 0 Rt.
Curve Data
S.B.
Δ = 25°51'30"
D = 0°30'
R = 11459.16'
T = 2630.62
L = 5171.67
E = 298.09
Bak = .0200' per ft
PROJECT I-91-2(11)
Sta. 5765+00.00
BEGIN CONTRACT #4
Jute Matting
SB 5765+40 - 5769+0 Rt.
SB 5762+10 - 5774+0 Rt.
Survey ℄
Southbound ℄
Woods
TBM 211
US Elev
944.67
15" Maple
TBM 212
US Elev
930.01
24" Maple
TBM 213
US Elev
914.08
POT 5760+44.98
Survey ℄ Northbound ℄
Approx. Access Road ℄
POT 5761+47.70
Curve Data
N.B.
Δ = 28°21'30"
D = 0°30'
R = 11459.16'
T = 2508.11
L = 4938.32
E = 277.27
Bak = .0200' per ft.
Control of Access Complete on this Sheet
Bradford-Ryegate
PLAN SCALE
0 50 100 FEET
Stage 1 Construction
STATE of VERMONT
DEPARTMENT of HIGHWAYS
BRADFORD - NEWBURY
McFARLAND - JOHNSON
CONSULTING ENGINEERS
PROJECT No: I-91-2(11)
CONTRACT No: 4 26
SHEET 34 OF 51
R.O.W/const