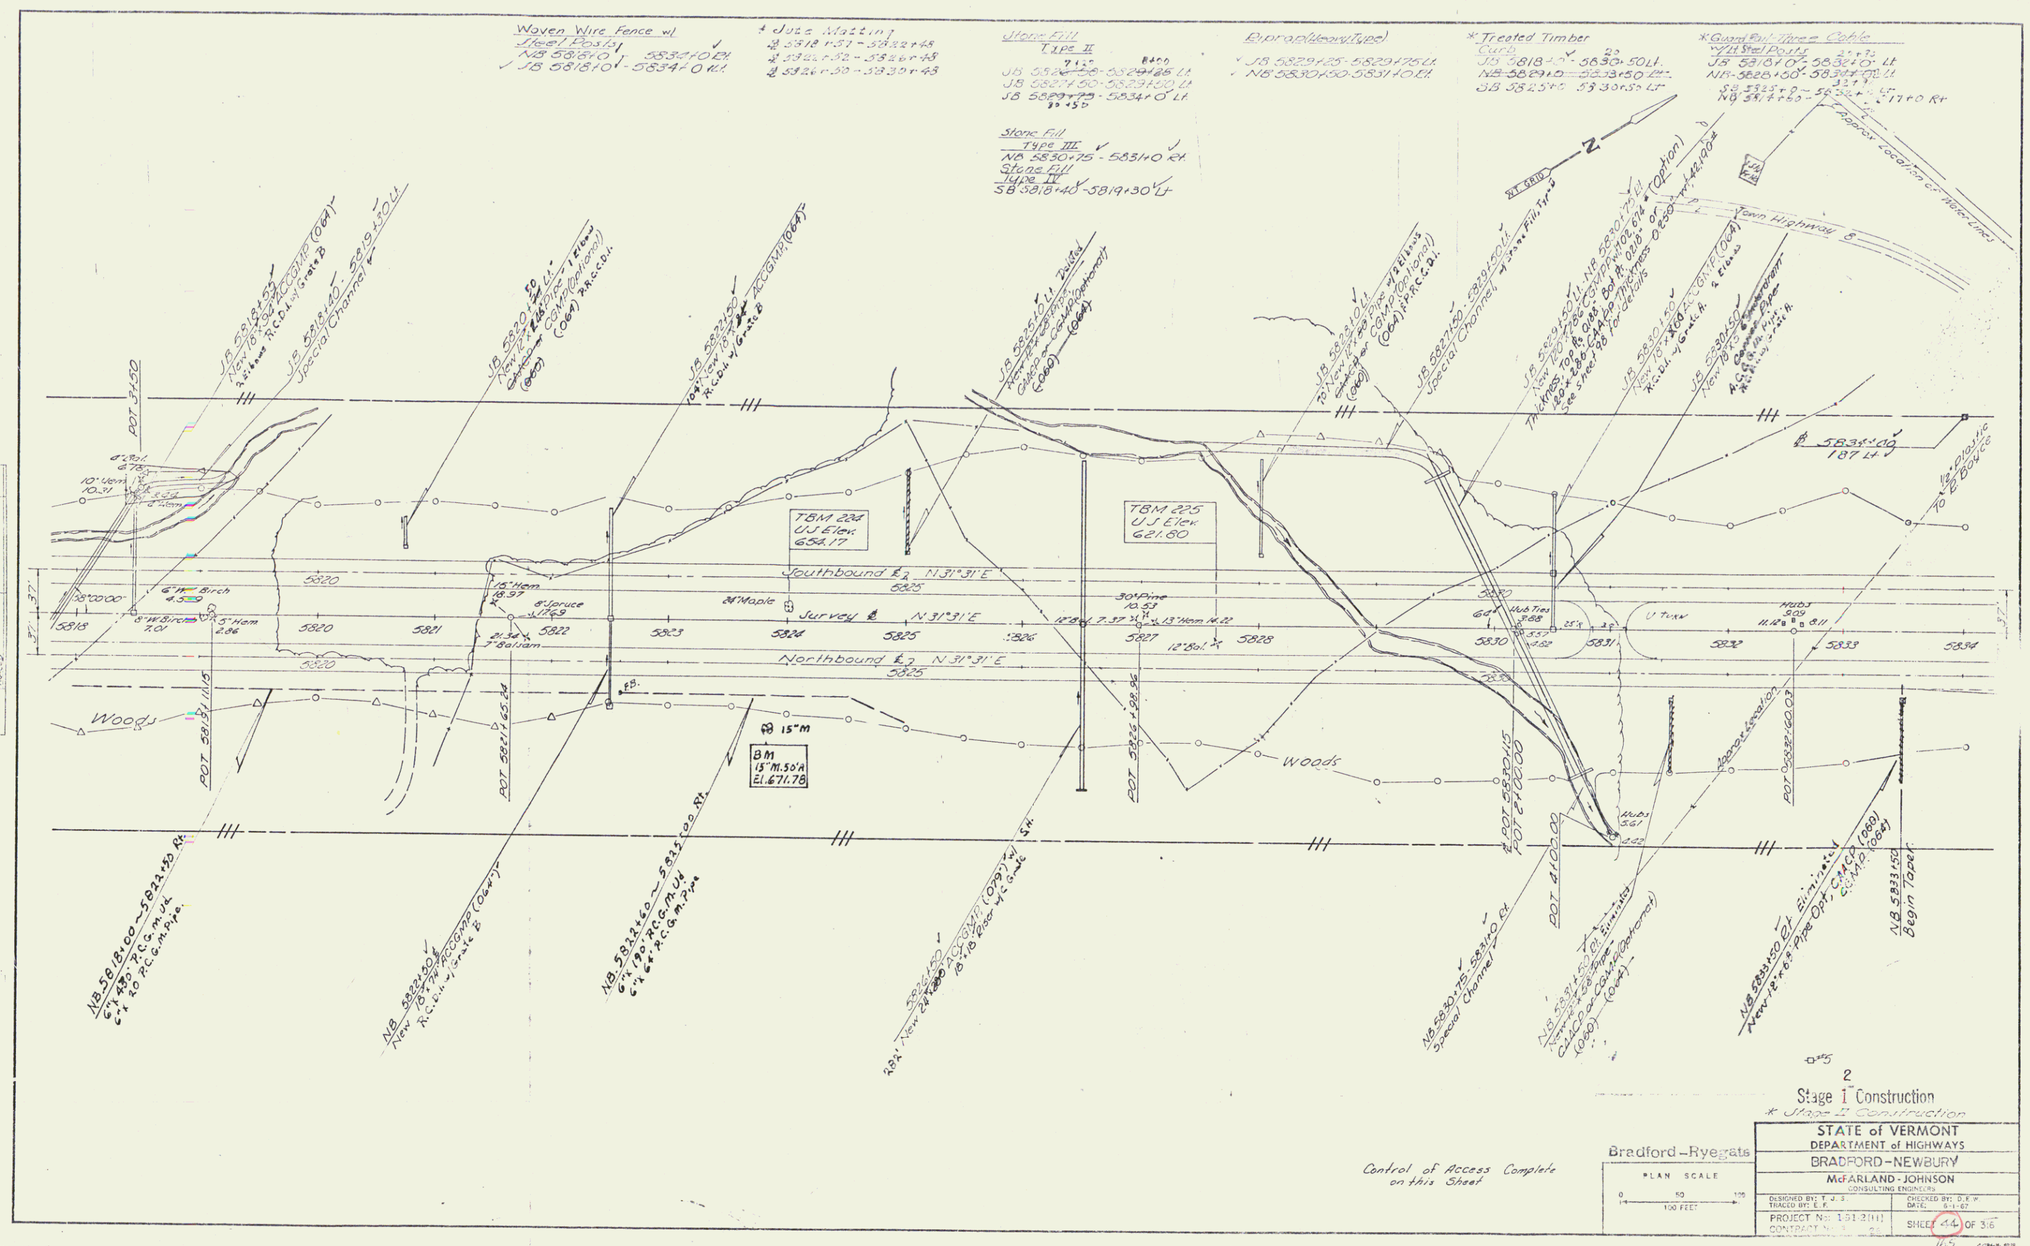

R.O.W./const.

135