For McIndoe Falls Filter Plant & Reservoir See Sheets 89A & B

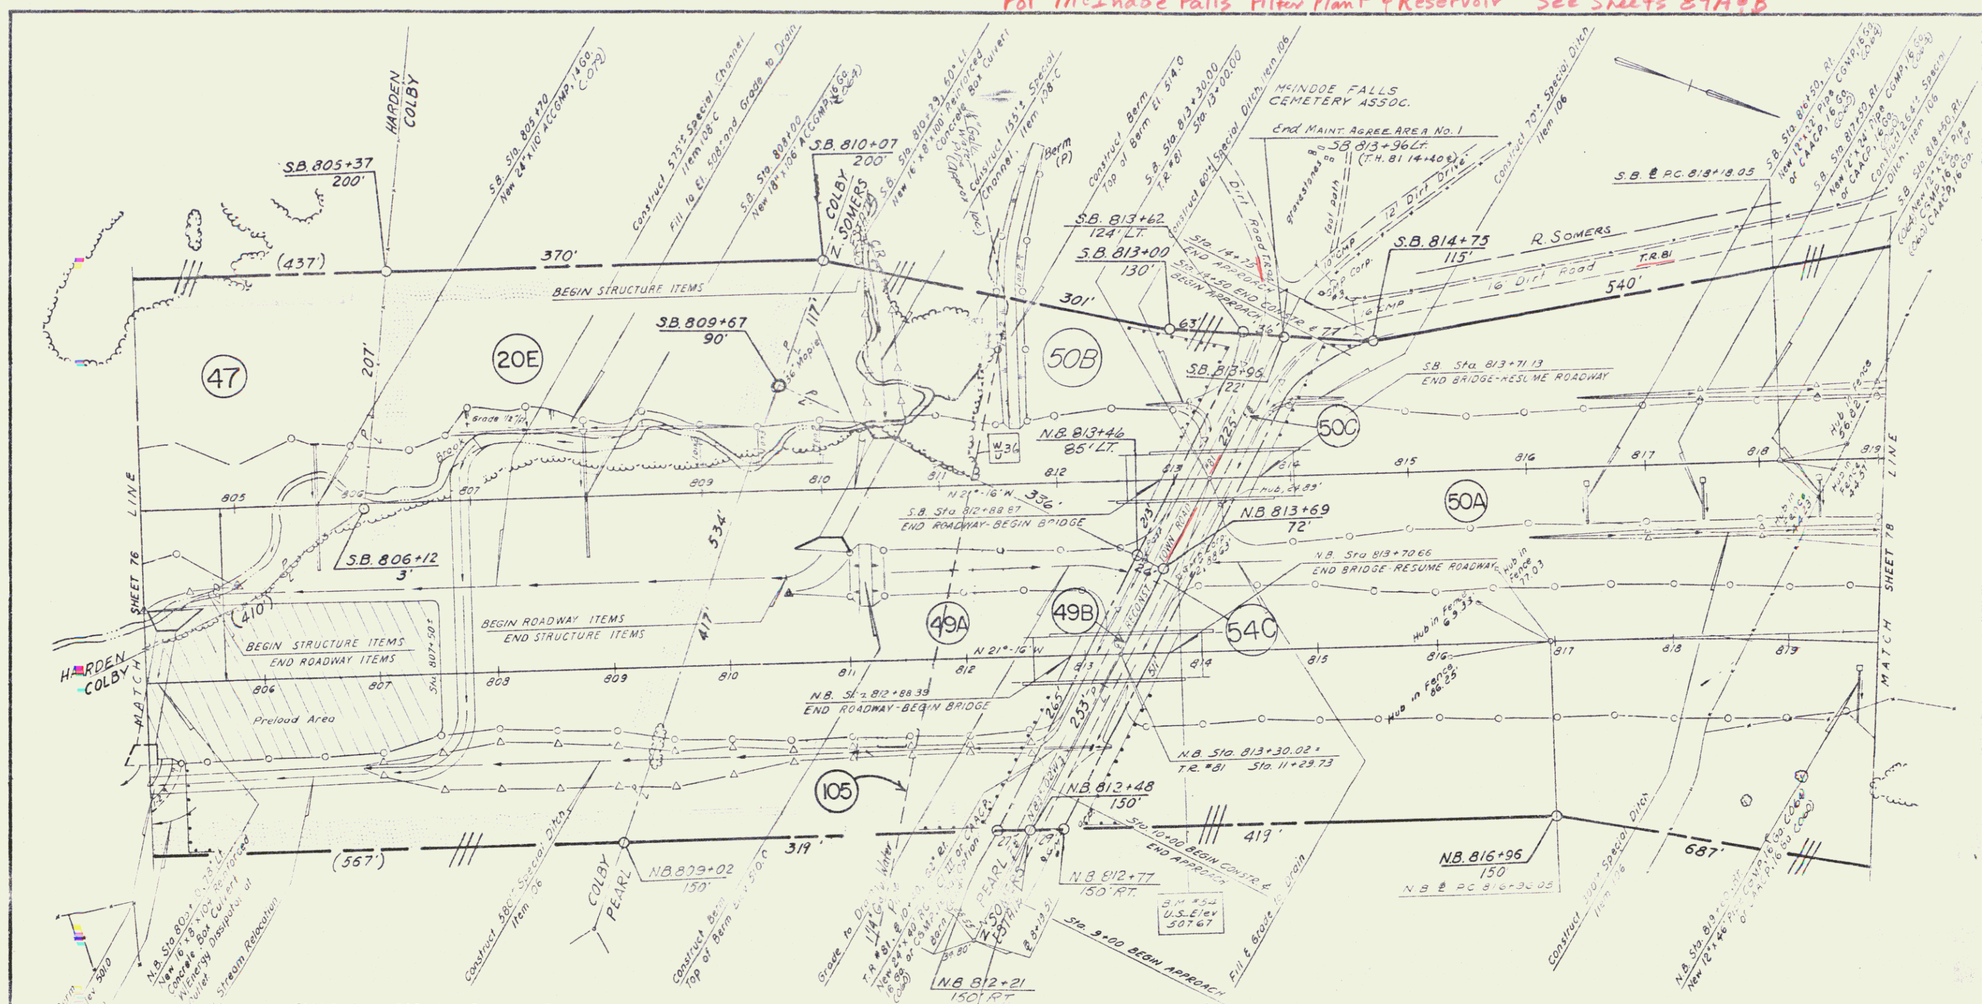

STONE FILL FOR SLOPE PROTECTION
(Light Type) ITEM 512

S.B. Sta. 809+50 - 811+65, Lt.
S.B. Sta. 810+55, 60' - 210' Lt.
S.B. Sta. N.B. 811+65.08' Lt - 811+90.293' Lt.
N.B. Sta. 805+35 - 810+70, Lt
N.B. Sta. 811+15.95' - 811+[illegible] Lt.
N.B. Sta. 810+50' - 811+[illegible] Lt.
N.B. Sta. 805+15 - 807+00, Rt

RIP RAP (Heavy Type) - ITEM 513-A

N.B. Sta. 805+00, Rt
N.B. Sta. 805+20, Lt
S.B. Sta. 810+00, Rt.
S.B. Sta. 810+50, Lt

Note:
See Sheet BR 100 Series for T.R. 81 Structures.

Begin Maint. Agree. Area No. 1
N.B. 812+48 Ext. (480')
(T.H. 81 9+60 ℄)

* JUTE MATTING - ITEM 623

S.B. Sta. 805+00 - 809+30, Lt

Note
* Indicates Stage 2 Construction

BITUMINOUS CONCRETE CURB - ITEM 555

S.B. Sta. 816+50 - 819+05, Rt
S.B. Sta. 813+60 - 813+75, Rt.

* THREE CABLE GUARD RAIL
W/ STEEL POSTS, ITEM 542

S.B. Sta. 804+20 - 813+33, Rt
S.B. Sta. 806+30 - 812+78, Lt
S.B. Sta. 813+86 - 813+05, Rt
S.B. Sta. 814+09 - 819+05, Lt
N.B. Sta. 805+00 - 812+44, Rt
N.B. Sta. 805+00 - 812+72, Lt
N.B. Sta. 813+85 - 815+53, Rt
N.B. Sta. 814+11 - 819+75, Lt
N.B. Sta. 819+26 - 819+75, Rt

PROPERTY LINE FENCE
W/ STEEL POSTS - ITEM 583.17, MOD.

S.B. Sta. 804+20 - 813+05, Lt
S.B. Sta. 813+34 - 819+05, Lt
N.B. Sta. 805+07 - 812+73, Rt
N.B. Sta. 813+61 - 819+75, Rt

Note
Control of Access is complete on this sheet

Stage 1 Construction

PLAN SCALE
0 50 100
100 FEET

RYEGATE - BARNET
I91-2(20)

PLAN STA 805+00 TO 819+75 N.B.
RECONSTRUCTED TOWN ROAD #81

Sheet 77 of 139 | DATE 8/28/67 | GOODKIND & O'DEA CONSULTING ENGINEERS

In Charge of A.J.P.
Made by S.L.Y. & A.E.
Checked by A.J.V.
Traced by W.E.K.E.
Checked by [illegible]