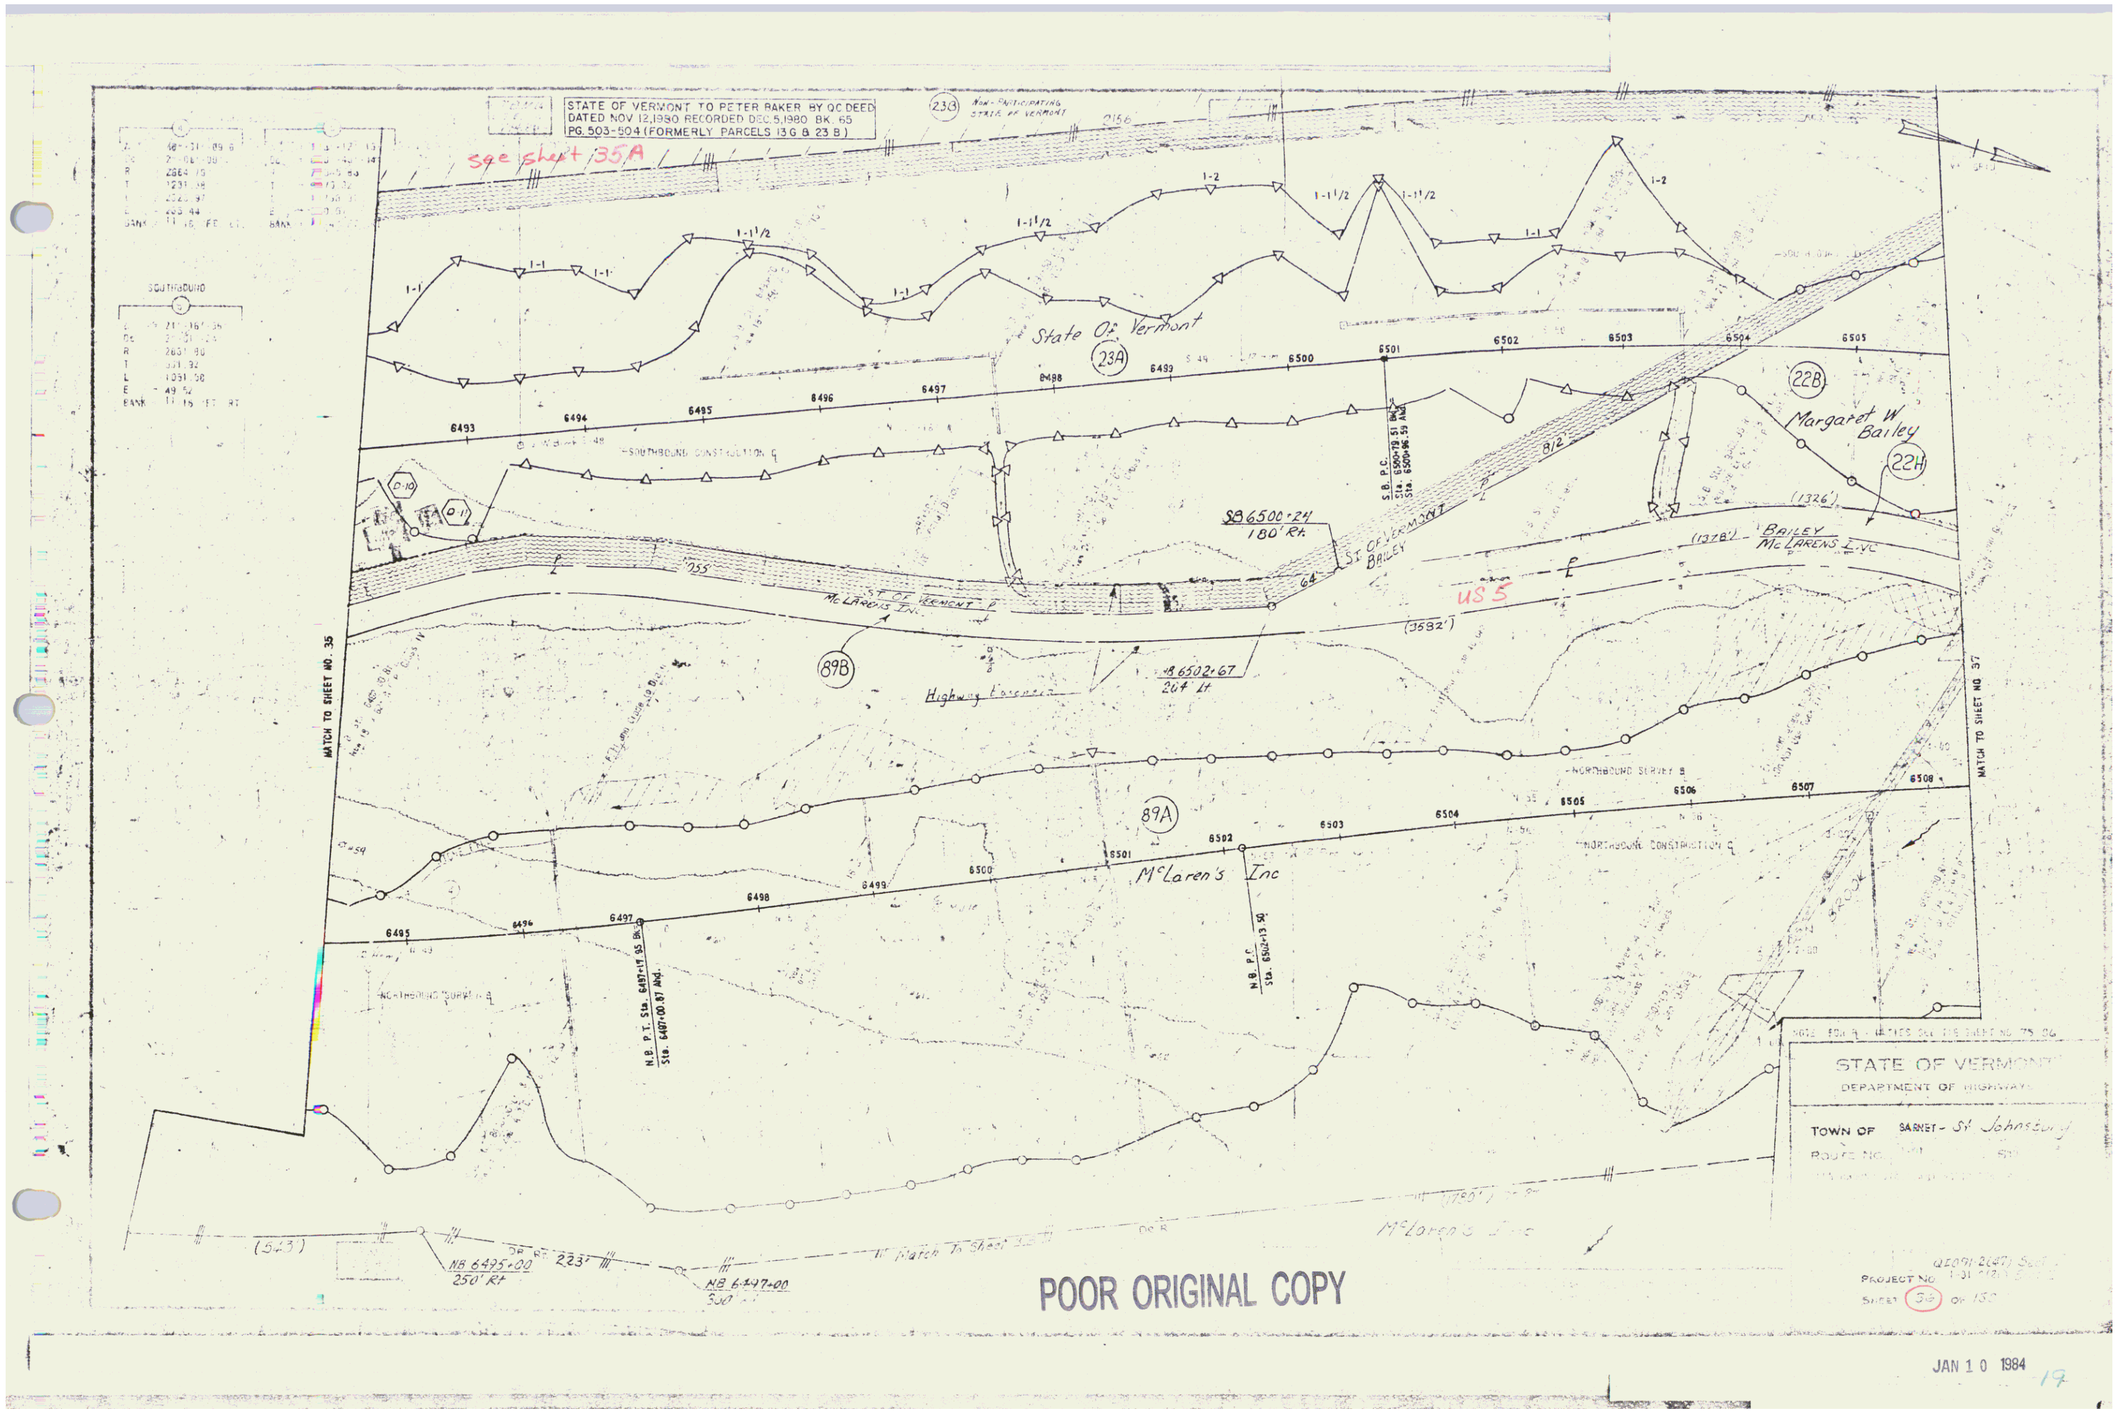

POOR ORIGINAL COPY

JAN 10 1984

17