


ALL DRIVES AS INDICATED ON PLANS ARE SUBJECT TO PERMITS PURSUANT TO TITLE 19, SECTION 43, V.S.A.

*Evelyn M. Lussier*

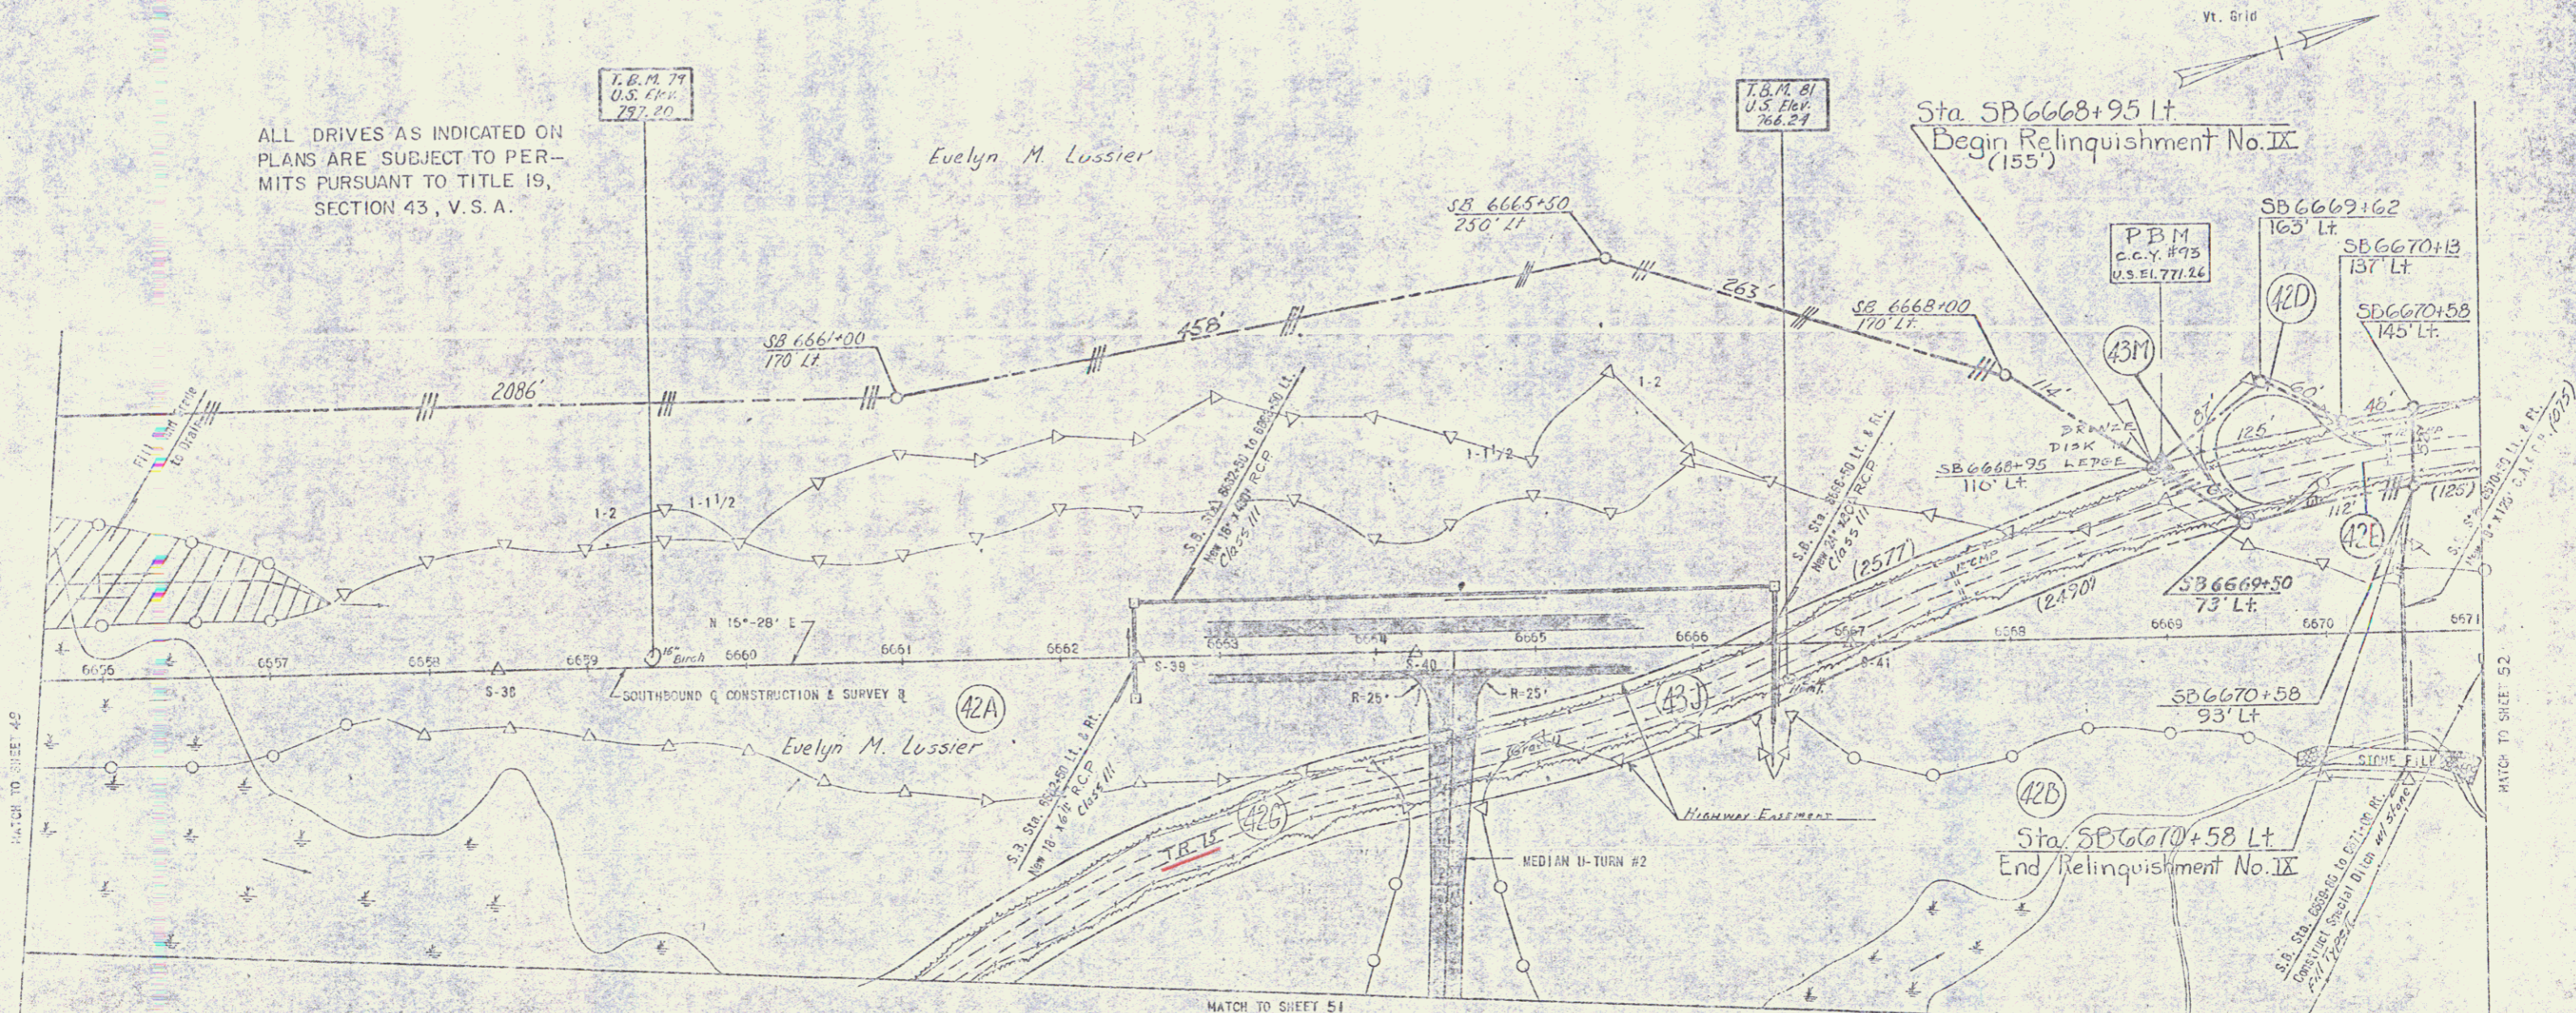

NOTE: FOR Q-Q TIES SEE THE SHEET NO. 74-20

STATE OF VERMONT  
DEPARTMENT OF HIGHWAYS

TOWN OF ... BARNET - *St. Johnsbury*  
ROUTE NO. ... 101 ... STA. ...  
SOUTHBOUND STA. 6665+00 TO 6670+58

CONTRACT # 2  
STAGE CONSTRUCTION 1

Project No. ... 101-2011 *Sec. II*  
SHEET **50** OF 151

PLAN SCALE  
0 50 100  
FOOT

INDICATES STAGE 2 ITEMS

CLARKESON, GLOVER AND YOKEL  
CONSULTING ENGINEERS  
ALBANY NEW YORK