

CONTROL OF ACCESS IS COMPLETE ON THIS SHEET

S.B. STA. 6701+00 TO STA. 6703+50 RT.
S.B. STA. 6706+00 TO STA. 6708+50 RT.
S.B. STA. 6714+50 TO STA. 6716+00 LT.


NB 6698+00-6718+00 LT.
SB 6701+00-6716+00 LT.

S.B. STA. 6706+25 LT.

ITEM 827
S.B. STA. 6725+00 TO STA. 6715+00 RT.


ALL DRIVES AS INDICATED ON
PLANS ARE SUBJECT TO PER-
MITS PURSUANT TO TITLE 19,
SECTION 43, V.S.A.

Henry A. & Mildred T. Denio

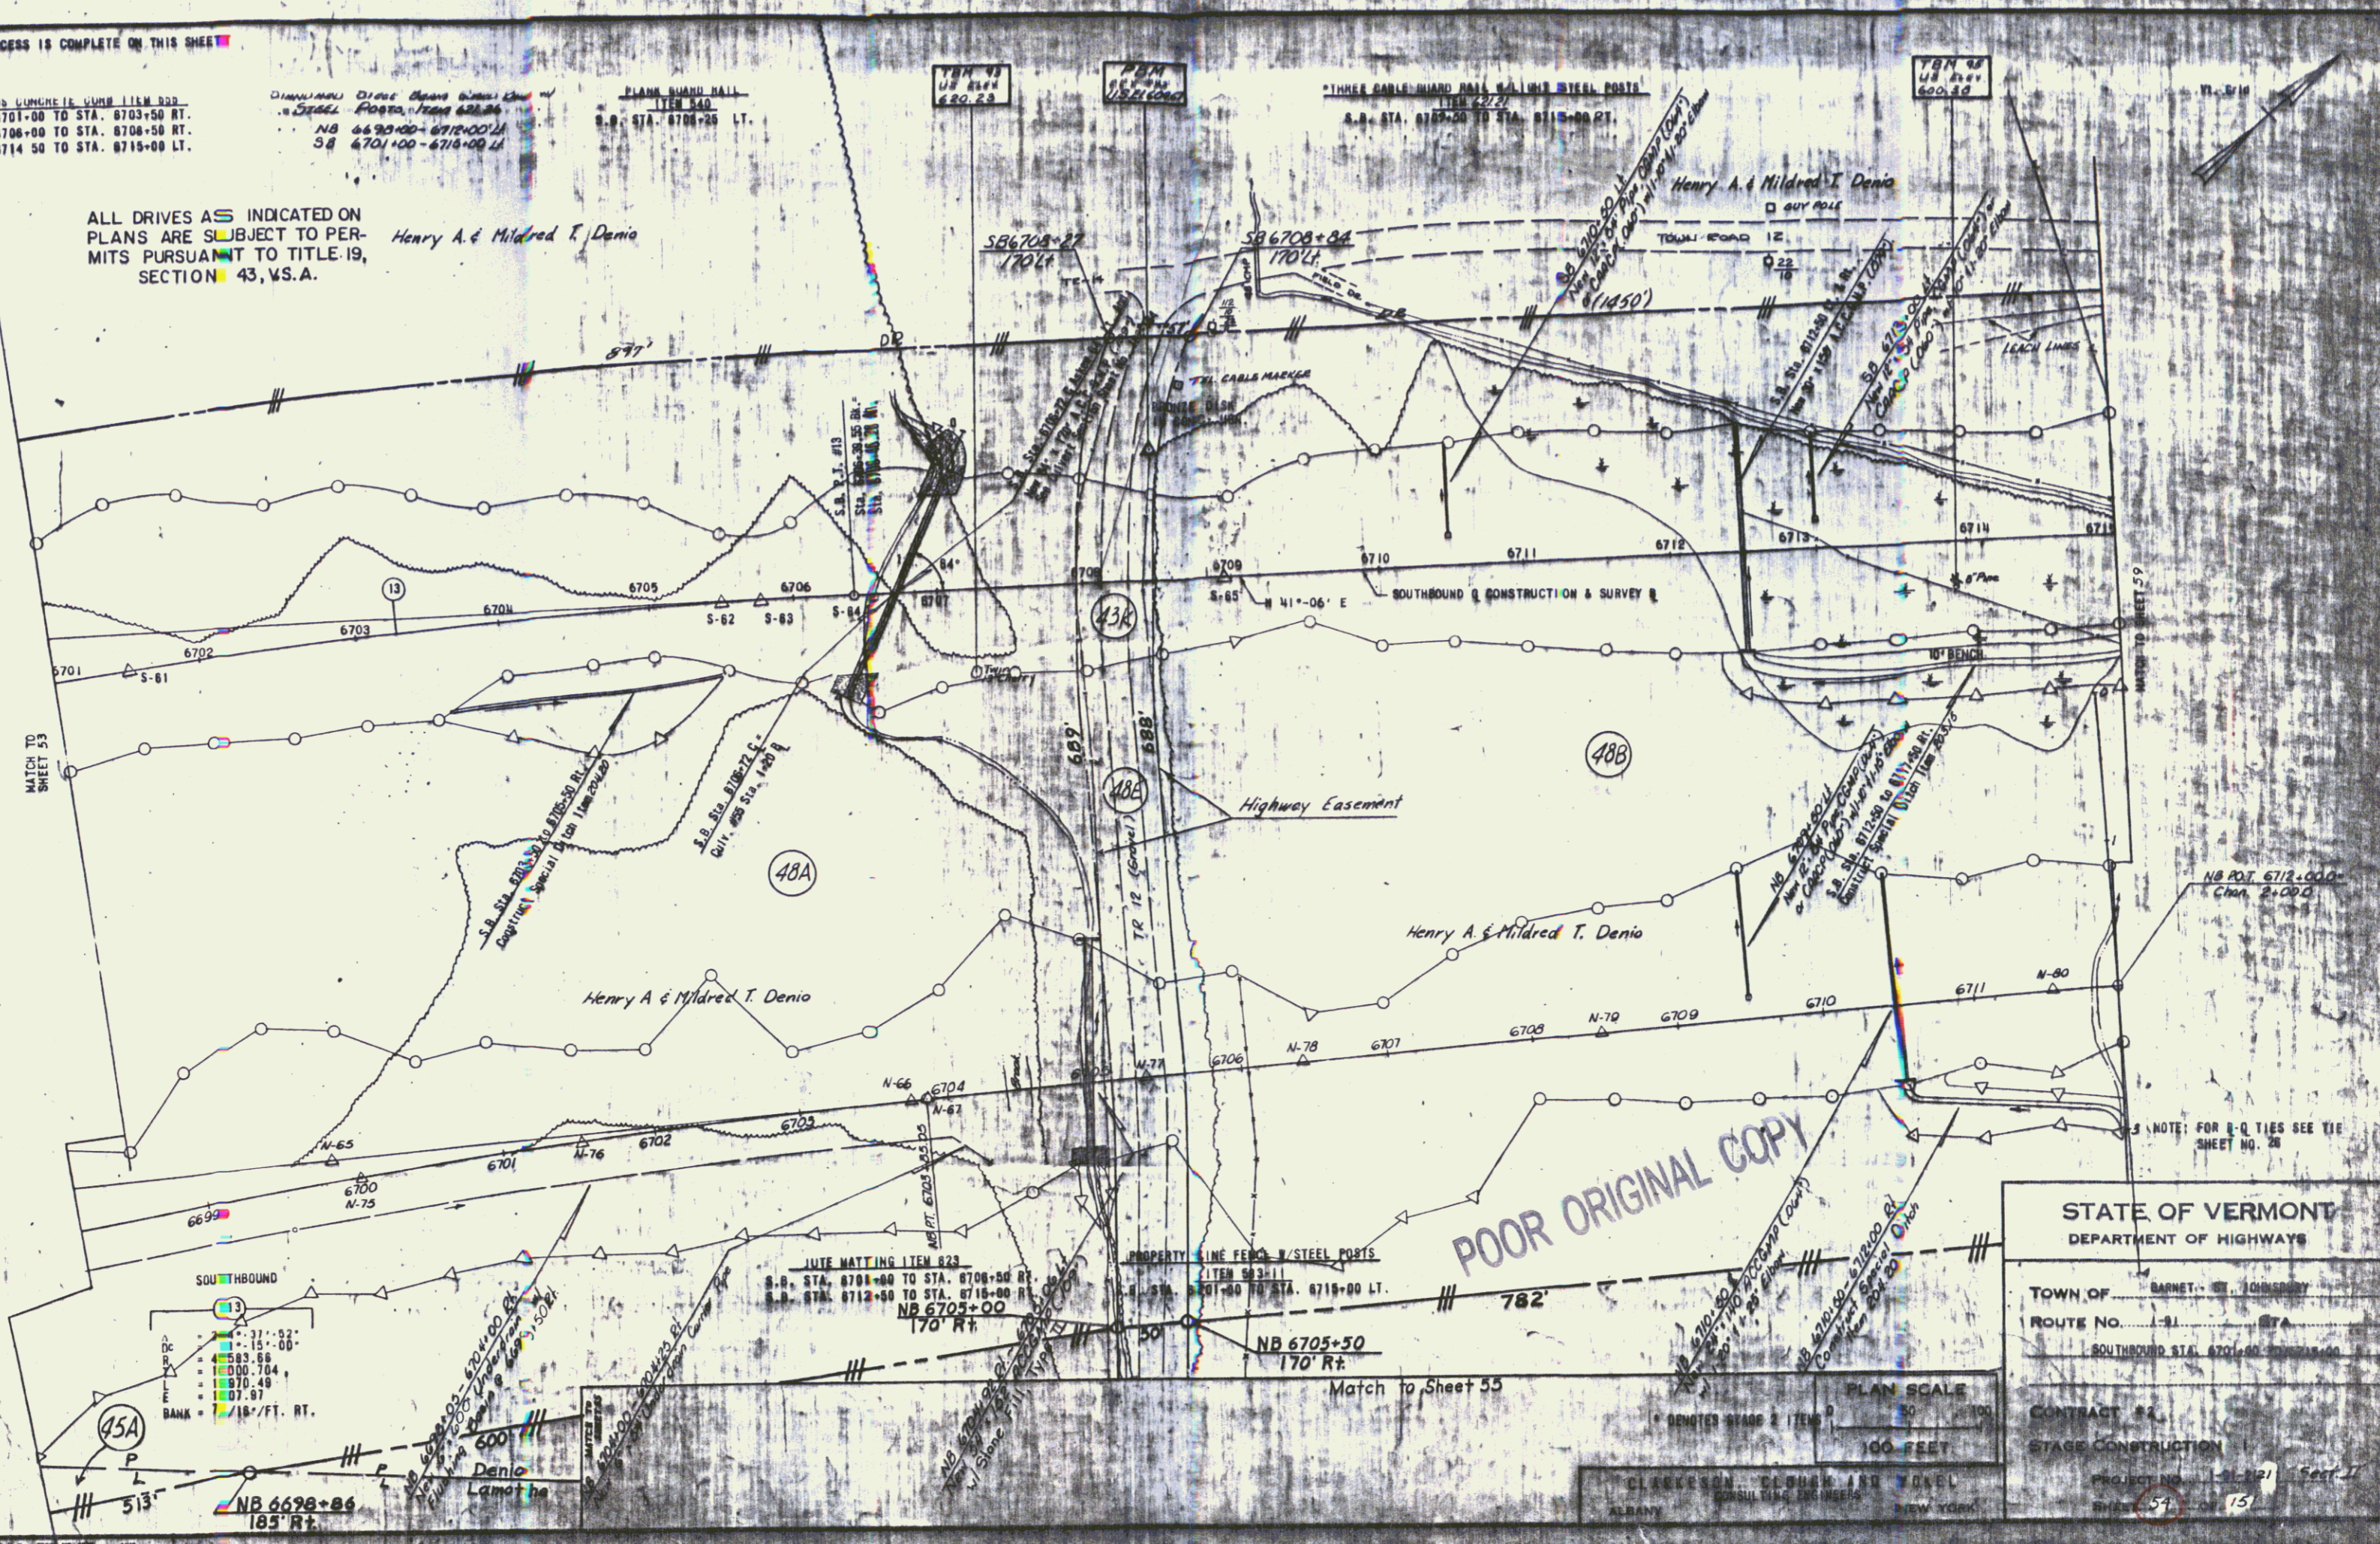

MATCH TO SHEET 53

MATCH TO SHEET 59

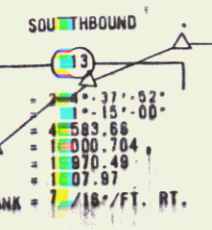

S.B. STA. 6708+00 TO STA. 6708+50 RT.
S.B. STA. 6712+00 TO STA. 6716+00 RT.
170' RT.

PROPERTY LINE FENCE W/ STEEL POSTS

NB 6705+50
170' RT.

Match to Sheet 55

STATE OF VERMONT
DEPARTMENT OF HIGHWAYS

TOWN OF BARNET, W. JOHNSBURY
SOUTHBOUND STA. 6701+00 TO STA. 6716+00

CONTRACT 84
STAGE CONSTRUCTION

PLAN SCALE
1" = 100 FEET

ALBANY NEW YORK