
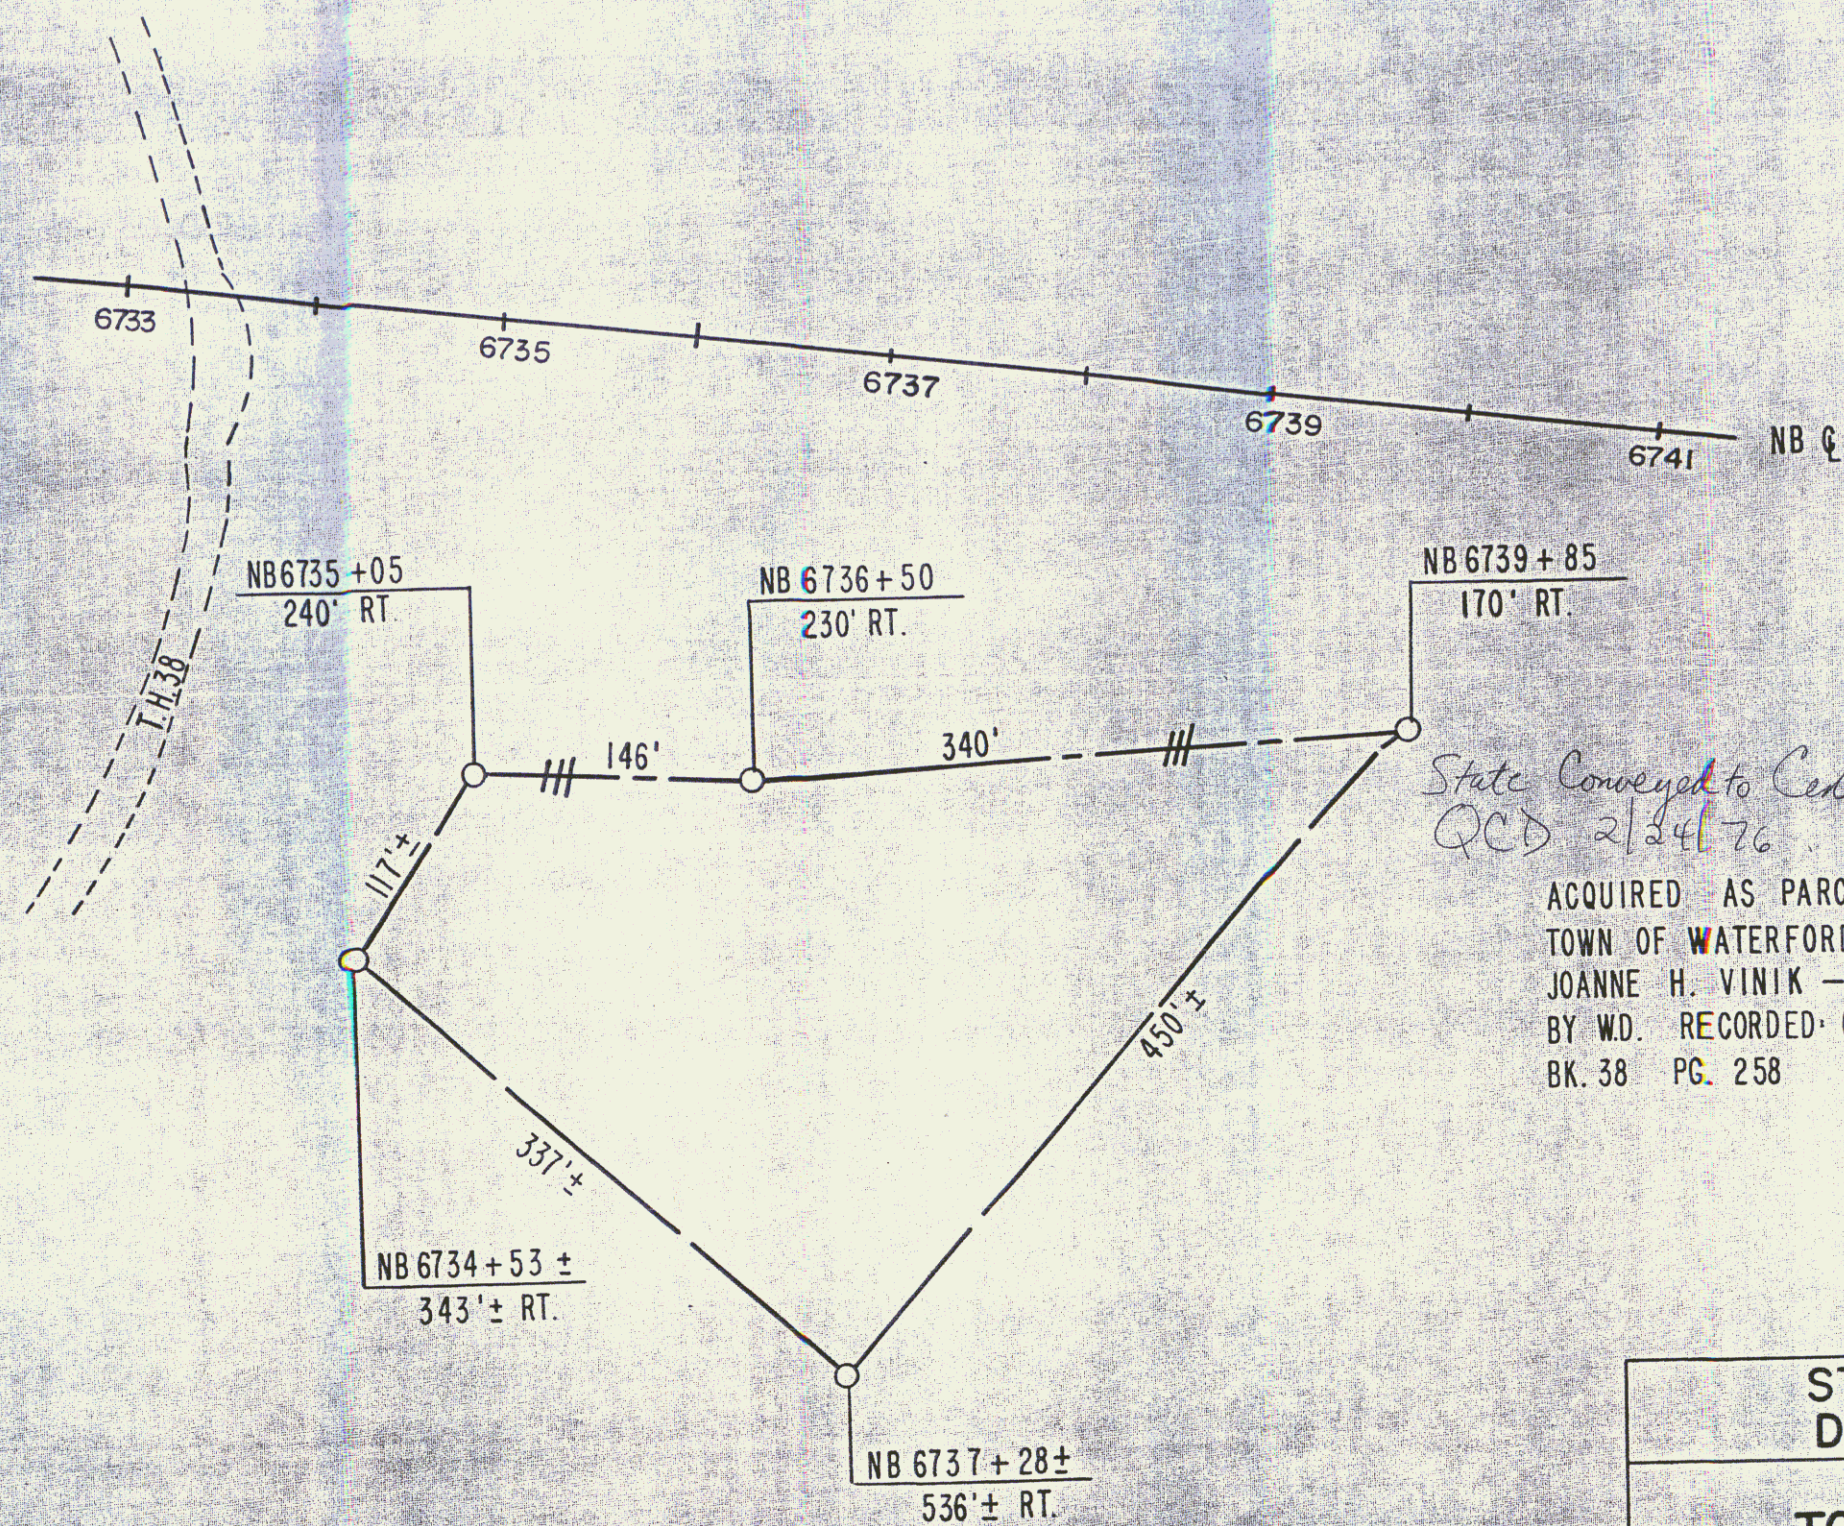


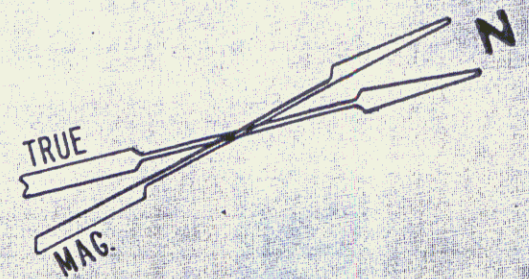

STATE OF VERMONT DEPT. OF HIGHWAYS		
TOWN OF WATERFORD		
PROJECT BARNET - ST. JOHNSBURY 191-2(21)		
APPROX. SCALE 1" = 100'	DATE 1-19-76	DRAWN BY KDP