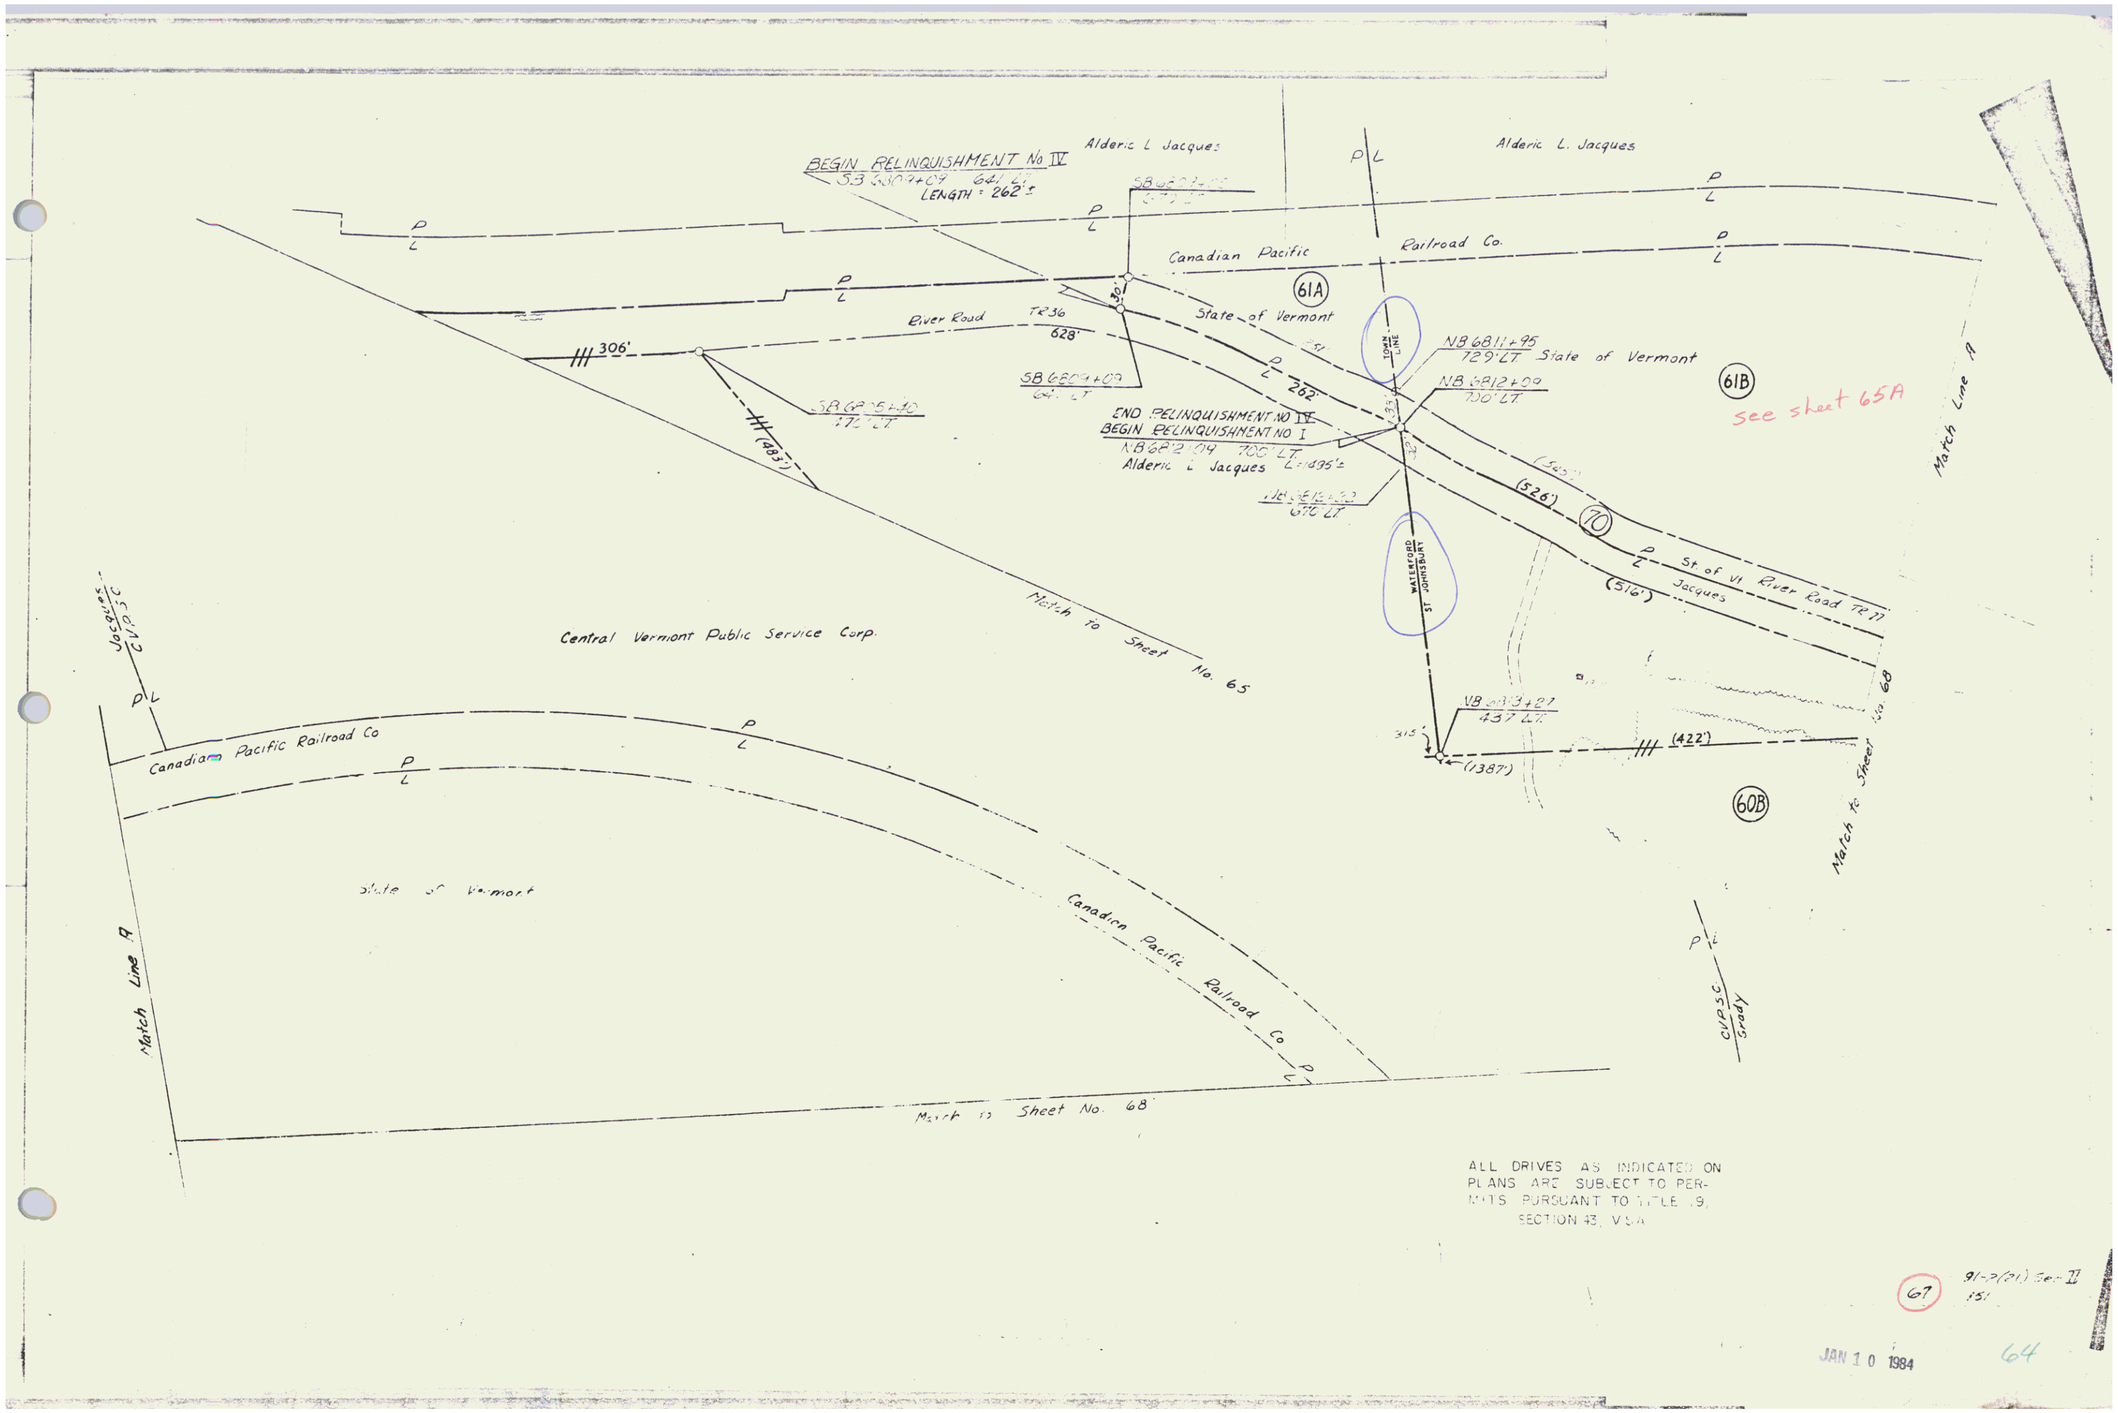


ALL DRIVES AS INDICATED ON PLANS ARE SUBJECT TO PERMITS PURSUANT TO TITLE 19, SECTION 43, VSA

67

91-7(21) Sec. II
151

JAN 10 1984

64