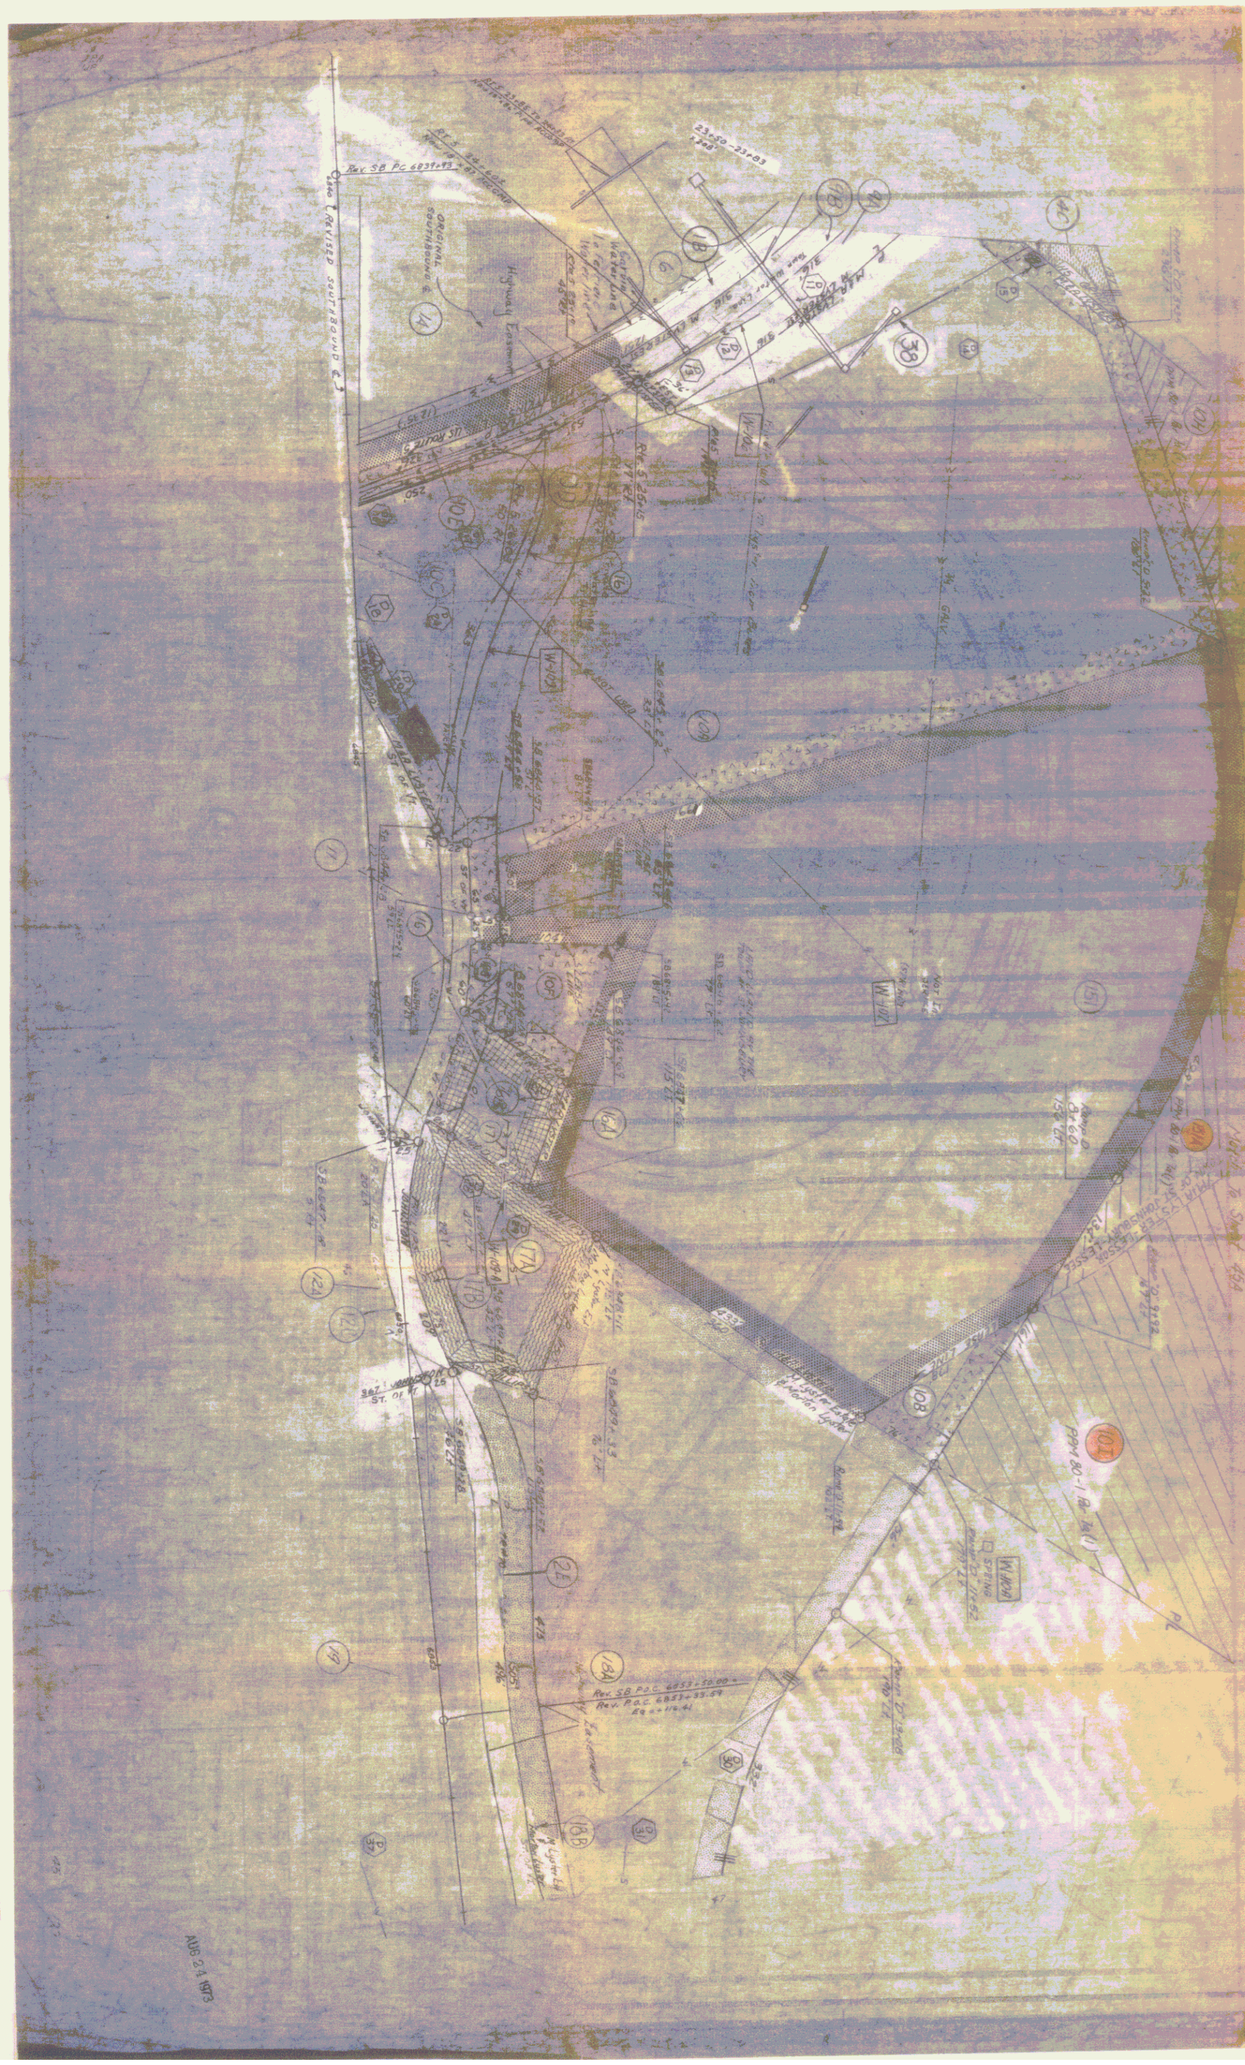
Rev. SB PC 6839+03
Lane 1 REVISED SOUTHBOUND ℄
ORIGINAL SOUTHBOUND ℄
Highway Easement
(US Route 12)
Rev. SB PC 6853+50.00
Rev. PRC 6853+33.59
Sta. 6+110.41
ST. OF
Rev. 80-1-08 PA 24(1)
W-102A
W-102
W-101
W-101A
W-104
W-104A
W-107
W-107A
W-108
W-108A
