


POOR ORIGINAL COPY

TR 66 21+00  
End Relinquishment No. 1

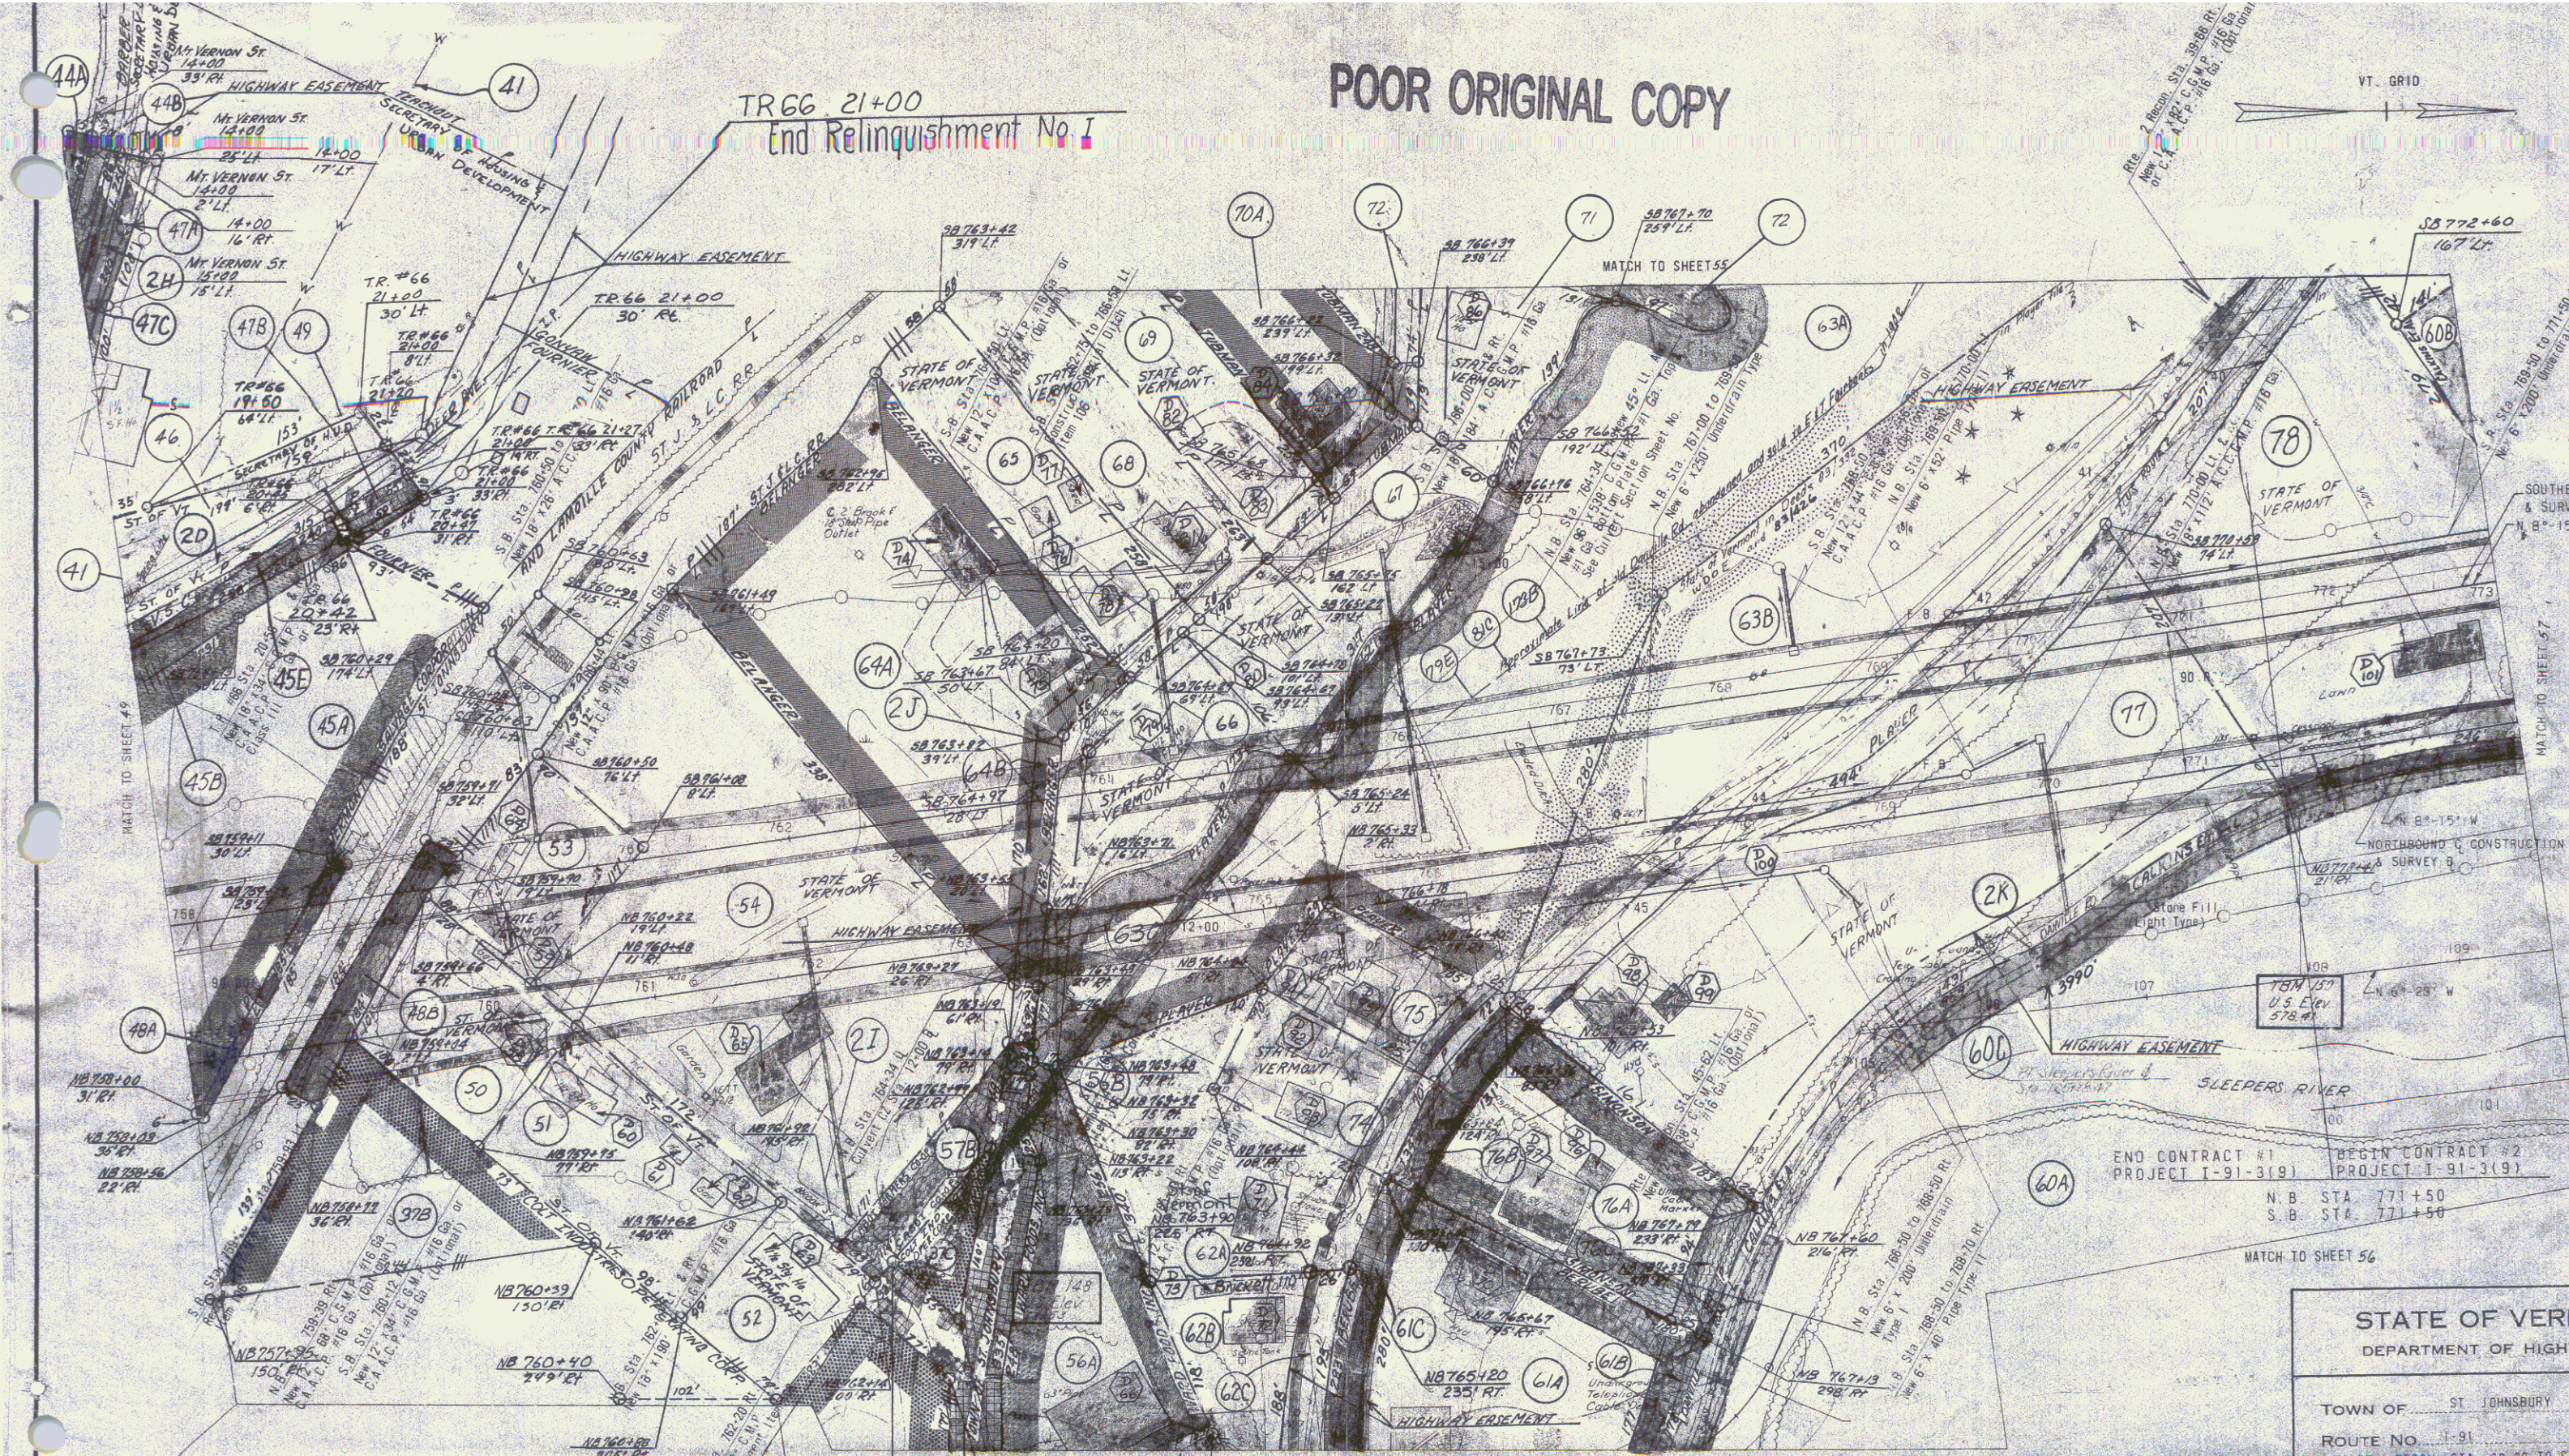


END CONTRACT #1 PROJECT I-91-3(9)  
N.B. STA. 771+50  
S.B. STA. 771+50  
BEGIN CONTRACT #2 PROJECT I-91-3(9)

STATE OF VERMONT  
DEPARTMENT OF HIGHWAYS

TOWN OF ST. JOHNSBURY  
ROUTE NO. 91  
ROUTE 2 RECON. STA. 39+22 TO STA. 49+19  
SOUTHBOUND STA. 758+10 TO STA. 775+00  
NORTHBOUND STA. 758+00 TO STA. 775+00  
VT. VERNON ST. STA. 14+00 TO STA. 18+00  
CONTRACT # 1-2

STAGE CONSTRUCTION I  
PROJECT NO. I-91-3(9)  
SHEET 52 OF 177

ALL DRIVES AS INDICATED ON  
PLANS ARE SUBJECT TO PER-  
MITS PURSUANT TO TITLE 19,  
SECTION 43, V.S.A.

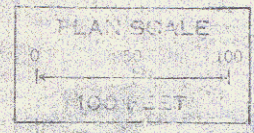

CLARKESON CLOUGH AND YONEL  
CONSULTING ENGINEERS  
ALBANY NEW YORK