



POOR ORIGINAL COPY

ROUTE 2 RECON.  
 Δ = 54° 40' 00"  
 Dc = 15' 18" 44"  
 R = 375.00  
 T = 193.83  
 L = 357.79  
 BANK = 7/8 FT. LT.

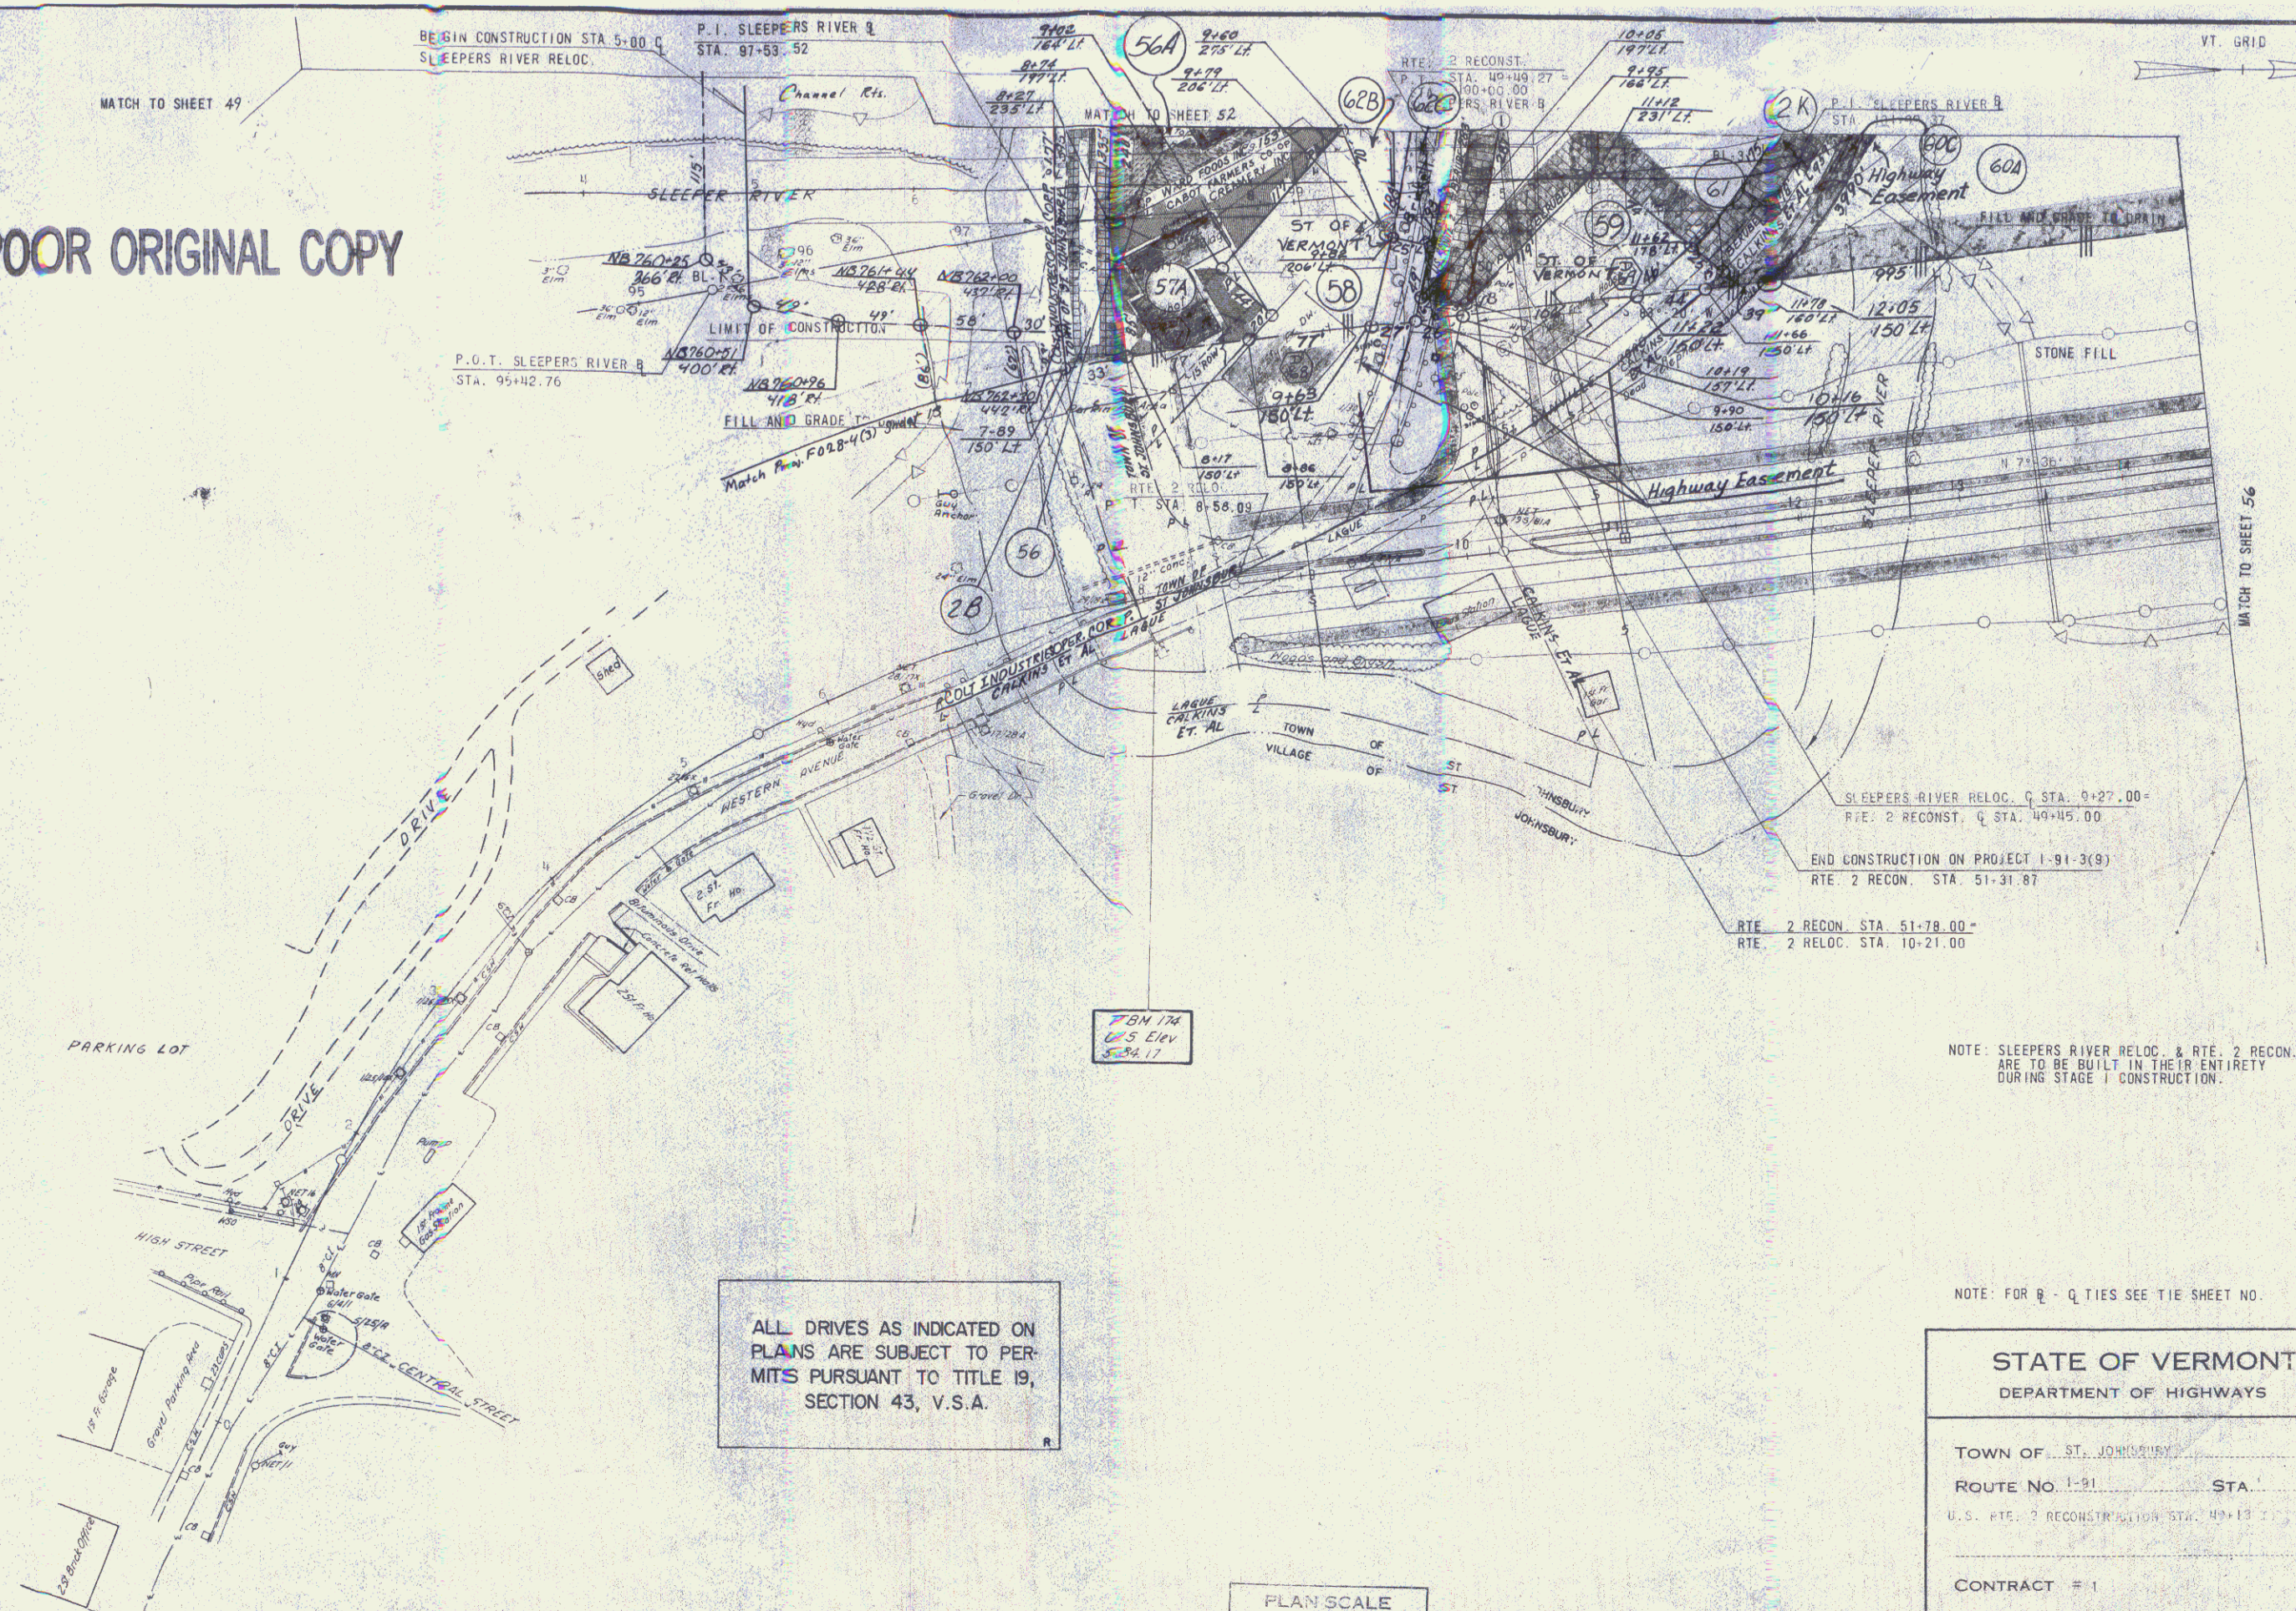

ALL DRIVES AS INDICATED ON PLANS ARE SUBJECT TO PERMITS PURSUANT TO TITLE 19, SECTION 43, V.S.A.

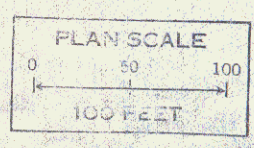

CLARKSON, GLOVER & YORKE  
 ALBANY CONSULTING ENGINEERS NEW YORK

STATE OF VERMONT  
 DEPARTMENT OF HIGHWAYS

TOWN OF ST. JOHNSBURY  
 ROUTE NO. 1-91 STA. \_\_\_\_\_  
 U.S. RTE. 2 RECONSTRUCTION STA. 49+13 TO 51+31.87

CONTRACT # 1  
 STAGE CONSTRUCTION I

PROJECT NO. 1-51-91  
 SHEET 54 OF 177 22

NOTE: SLEEPERS RIVER RELOC. & RTE. 2 RECON. ARE TO BE BUILT IN THEIR ENTIRETY DURING STAGE I CONSTRUCTION.

NOTE: FOR R - Q TIES SEE TIE SHEET NO.