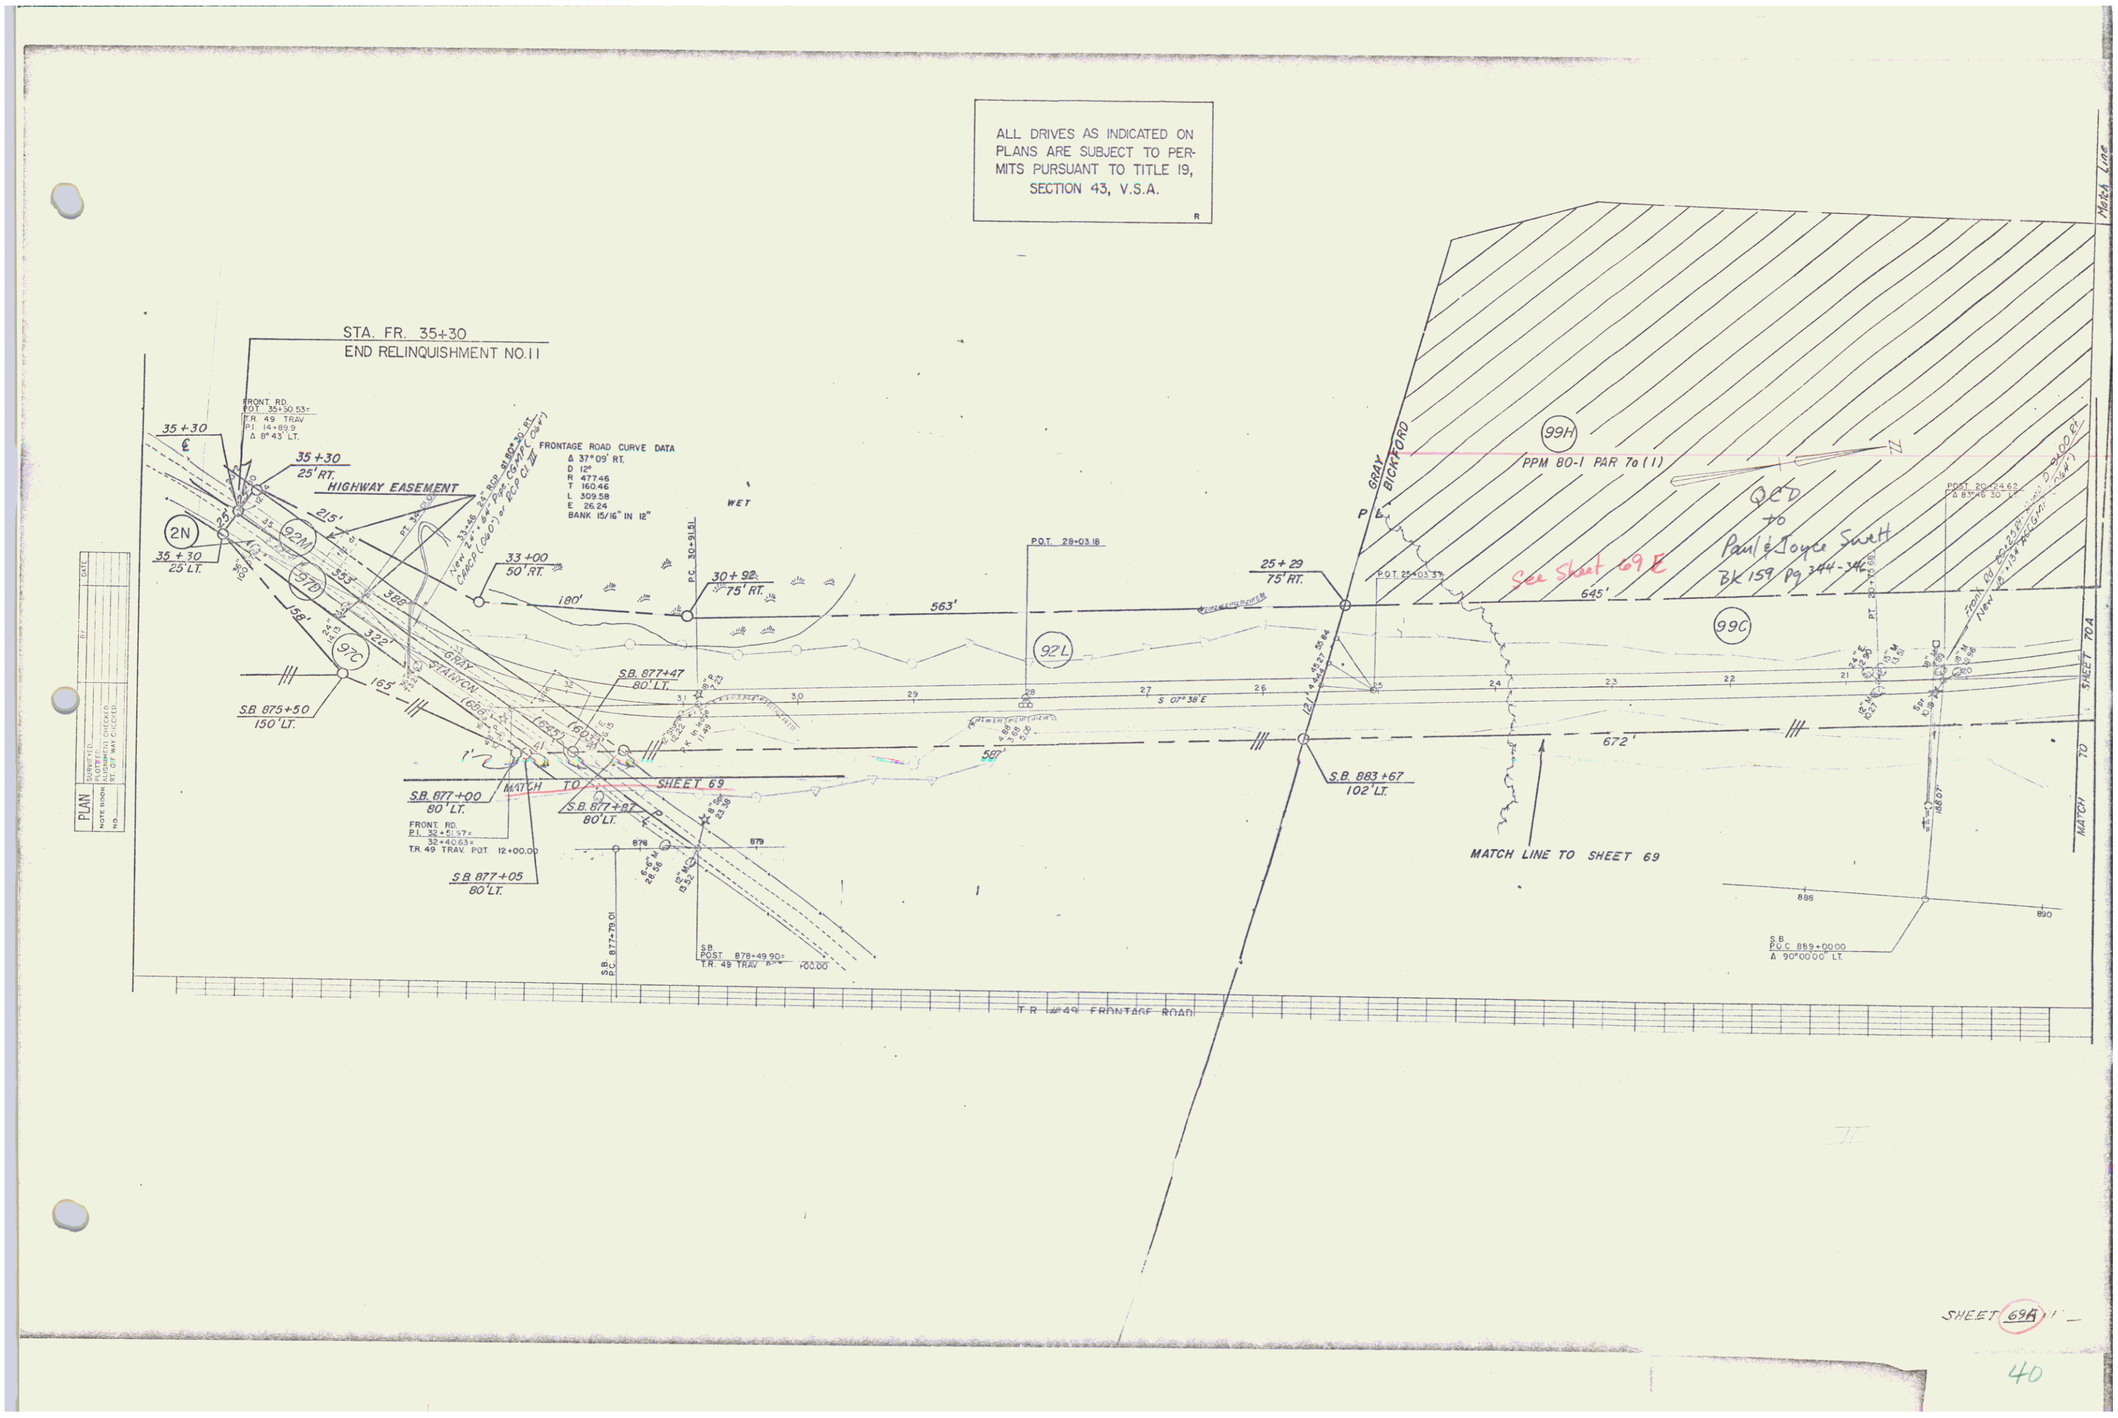
ALL DRIVES AS INDICATED ON PLANS ARE SUBJECT TO PERMITS PURSUANT TO TITLE 19, SECTION 43, V.S.A.
STA. FR. 35+30
END RELINQUISHMENT NO.11
HIGHWAY EASEMENT
FRONTAGE ROAD CURVE DATA
Δ 37°09' RT.
D 12°
R 477.46
T 160.46
L 309.58
E 26.24
BANK 15/16" IN 12"
WET
GRAY
BICKFORD
PPM 80-1 PAR 7a (1)
QCD to Paul & Joyce Swett BK 159 Pg 344-346
See Sheet 69 E
MATCH TO SHEET 69
MATCH LINE TO SHEET 69
MATCH TO SHEET 70A
T.R. #49 FRONTAGE ROAD
PLAN
SHEET 69A
40