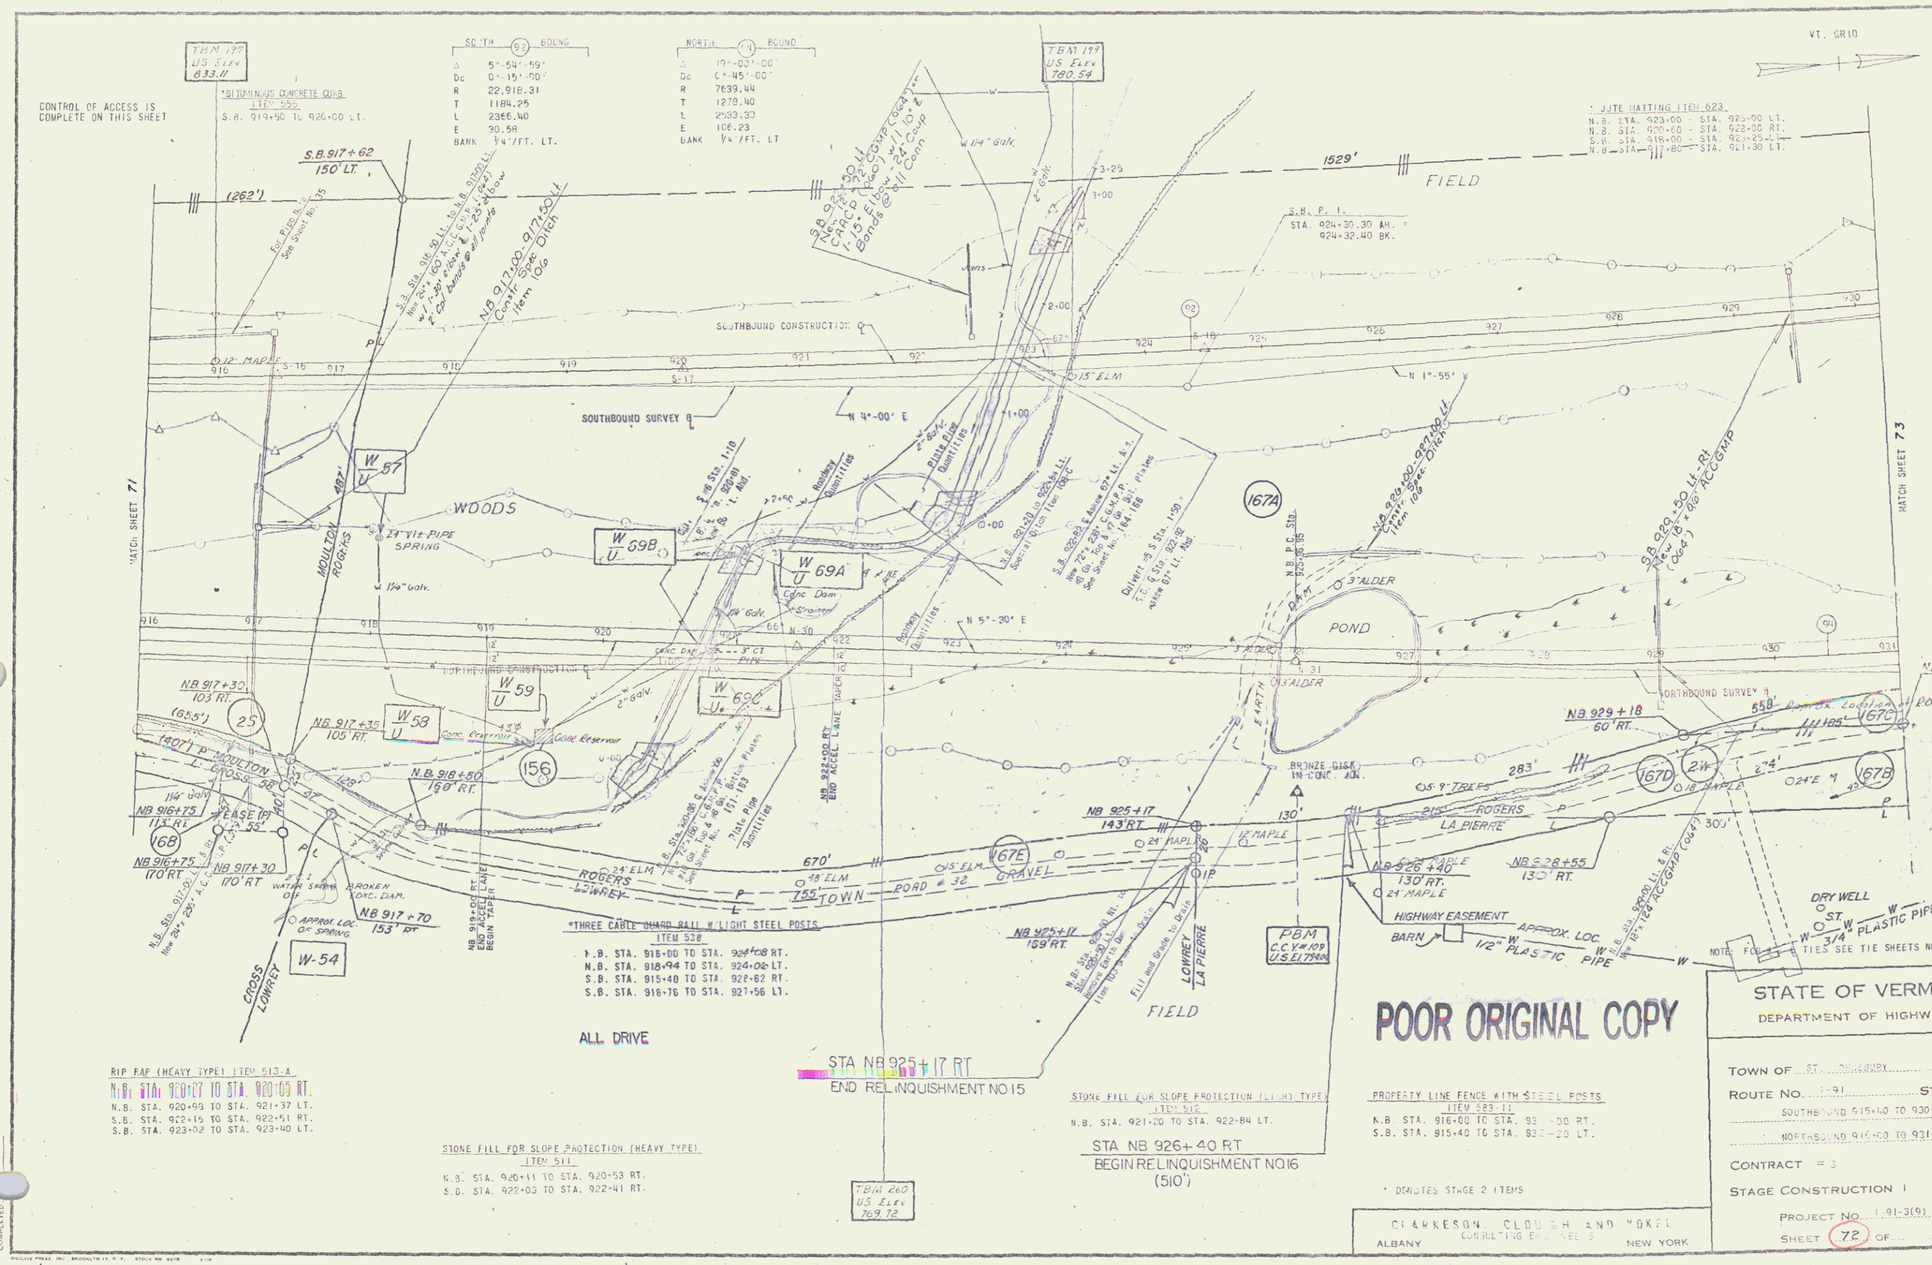
VT. GRID
TBM 199
US Elev
833.11
TBM 199
US Elev
780.54
CONTROL OF ACCESS IS COMPLETE ON THIS SHEET
*BITUMINOUS CONCRETE CURB
ITEM 559
S.B. 919+50 TO 926+00 LT.
SOUTH (93) BOUND
Δ 5°-54'-59"
Dc 0°-15'-00"
R 22,918.31
T 1184.25
L 2366.40
E 30.58
BANK ¼"/FT. LT.
NORTH (94) BOUND
Δ 19°-03'-00"
Dc 0°-45'-00"
R 7639.44
T 1278.40
L 2583.33
E 106.23
BANK ¼"/FT. LT
* JUTE MATTING ITEM 623
N.B. STA. 923+00 - STA. 925+00 LT.
N.B. STA. 920+60 - STA. 923+00 RT.
S.B. STA. 918+00 - STA. 921+65 LT.
N.B. STA. 917+80 - STA. 921+30 LT.
S.B. 917+62
150' LT.
(262')
1529'
FIELD
S.B. P. I.
STA. 924+30.30 AH. =
924+32.40 BK.
SOUTHBOUND CONSTRUCTION
SOUTHBOUND SURVEY B
12" MAPLE
15" ELM
WOODS
24" Vit. PIPE
SPRING
MOULTON ROGERS
W 57
U
W 69B
U
W 69A
U
Conc Dam
Strainer
W 69C
U
W 59
U
W 58
U
Conc Reservoir
Conc Reservoir
156
25
W-54
CROSS
LOWREY
ROGERS
LOWREY
24" ELM
48" ELM
755
TOWN
ROAD # 32
15" ELM
GRAVEL
67E
670'
LOWREY
LA PIERRE
FIELD
POND
3" ALDER
167A
167B
167C
167D
68
NB 917+30
103' RT.
NB 917+35
105' RT.
NB 916+75
113' RT.
NB 916+75
170' RT.
NB 917+30
170' RT
NB 917+70
153' RT.
N.B. 918+60
160' RT.
NB 925+17
143' RT.
NB 925+17
169' RT.
NB 929+18
60' RT.
NB 931+00
60' RT
NB 926+40
130' RT.
24" MAPLE
NB 928+55
130' RT.
HIGHWAY EASEMENT
APPROX. LOC.
BARN
1/2" PLASTIC PIPE
3/4" PLASTIC PIPE
DRY WELL
BRONZE DISK IN CONC. JCT.
PBM
CCV 109
US 217.40
TBM 260
US Elev
769.72
MATCH SHEET 71
MATCH SHEET 73
*THREE CABLE GUARD RAIL W/LIGHT STEEL POSTS
ITEM 538
N.B. STA. 918+00 TO STA. 924+08 RT.
N.B. STA. 918+94 TO STA. 924+06 LT.
S.B. STA. 915+40 TO STA. 922+62 RT.
S.B. STA. 918+76 TO STA. 927+56 LT.
ALL DRIVE
STA NB 925+17 RT
END RELINQUISHMENT NO 15
RIP RAP (HEAVY TYPE) ITEM 513-A
N.B. STA. 920+99 TO STA. 921+37 LT.
S.B. STA. 922+15 TO STA. 922+51 RT.
S.B. STA. 923+02 TO STA. 923+40 LT.
STONE FILL FOR SLOPE PROTECTION (HEAVY TYPE)
ITEM 511
N.B. STA. 920+11 TO STA. 920+53 RT.
S.B. STA. 922+03 TO STA. 922+41 RT.
STONE FILL FOR SLOPE PROTECTION (LIGHT TYPE)
ITEM 512
N.B. STA. 921+20 TO STA. 922+84 LT.
STA NB 926+40 RT
BEGIN RELINQUISHMENT NO 16
(510')
PROPERTY LINE FENCE WITH STEEL POSTS
ITEM 583-11
N.B. STA. 916+00 TO STA. 93 -00 RT.
S.B. STA. 915+40 TO STA. 93 -20 LT.
* DENOTES STAGE 2 ITEMS
CLARKESON, CLOUGH AND YORKE
CONSULTING ENGINEERS
ALBANY
NEW YORK
STATE OF VERMONT
DEPARTMENT OF HIGHWAYS
TOWN OF ST. JOHNSBURY
ROUTE NO. I-91 STA.
SOUTHBOUND 915+40 TO 930+20
NORTHBOUND 916+00 TO 931+00
CONTRACT # 3
STAGE CONSTRUCTION 1
PROJECT NO. I-91-3(9)
SHEET 72 OF
POOR ORIGINAL COPY

49