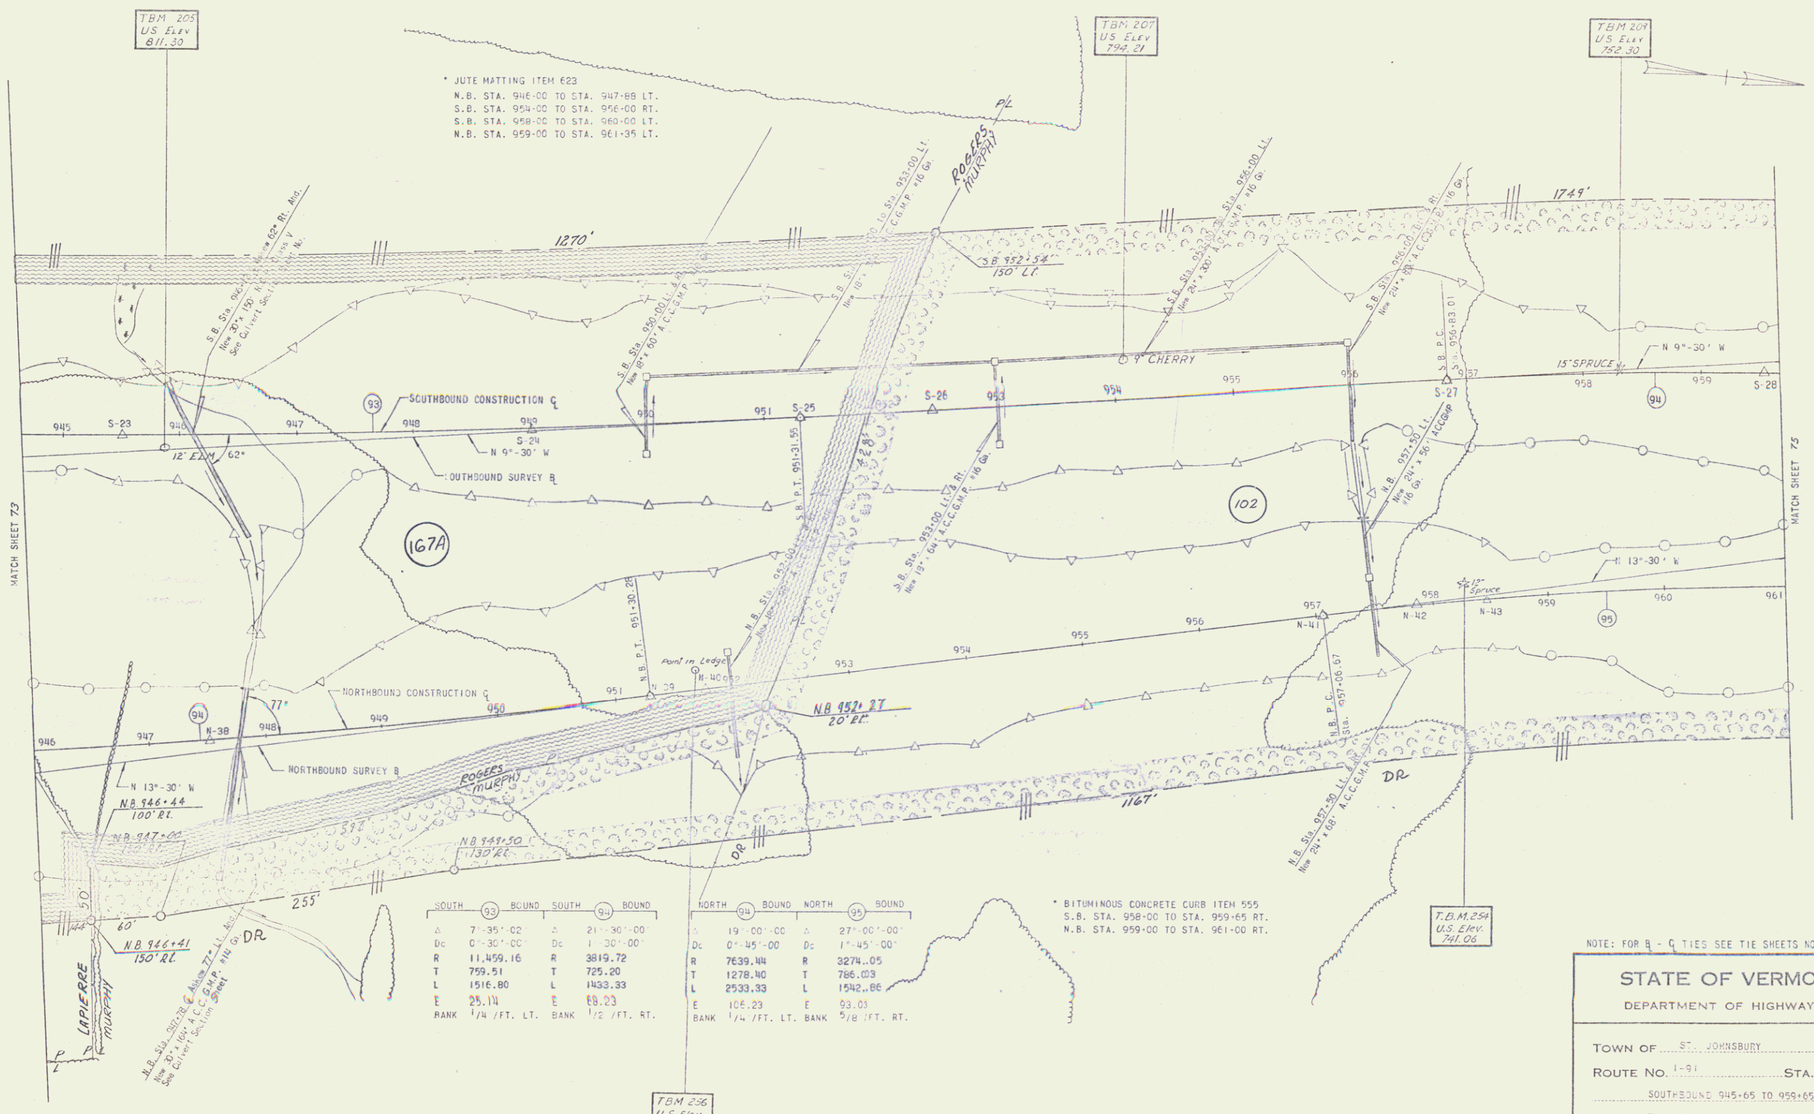


| SOUTH 93 | BOUND | SOUTH 94 | BOUND |
|---|---|---|---|
| Δ | 7°-35'-02" | Δ | 21°-30'-00" |
| Dc | 0°-30'-00" | Dc | 1°-30'-00" |
| R | 11,459.16 | R | 3819.72 |
| T | 759.51 | T | 725.20 |
| L | 1516.80 | L | 1433.33 |
| E | 25.14 | E | 68.23 |
| BANK | 1/4 /FT. LT. | BANK | 1/2 /FT. RT. |

| NORTH 94 | BOUND | NORTH 95 | BOUND |
|---|---|---|---|
| Δ | 19°-00'-00" | Δ | 27°-00'-00" |
| Dc | 0°-45'-00" | Dc | 1°-45'-00" |
| R | 7639.44 | R | 3274.05 |
| T | 1278.40 | T | 786.03 |
| L | 2533.33 | L | 1542.86 |
| E | 106.23 | E | 93.03 |
| BANK | 1/4 /FT. LT. | BANK | 5/8 /FT. RT. |

* BITUMINOUS CONCRETE CURB ITEM 555
S.B. STA. 958+00 TO STA. 959+65 RT.
N.B. STA. 959+00 TO STA. 961+00 RT.

* ITEM 542 THREE CABLE GUARD RAIL W/STEEL POSTS
N.B. STA. 946+00 TO STA. 951+30 RT.
N.B. STA. 956+74 TO STA. 961+00 RT.
S.B. STA. 957+50 TO STA. 959+65 RT.

NOTE: FOR B - C TIES SEE TIE SHEETS NO.

* DENOTES STAGE 2 ITEMS

CLARKESON, CLOUGH AND YOKEL
CONSULTING ENGINEERS
ALBANY NEW YORK

# STATE OF VERMONT
DEPARTMENT OF HIGHWAYS

TOWN OF ST. JOHNSBURY
ROUTE NO. I-91 STA.
SOUTHBOUND 945+65 TO 959+65
NORTHBOUND 946+00 TO 961+00
CONTRACT = 3
STAGE CONSTRUCTION 1
PROJECT NO. I-91-3(31)
SHEET 74 OF 177