Draw (7)

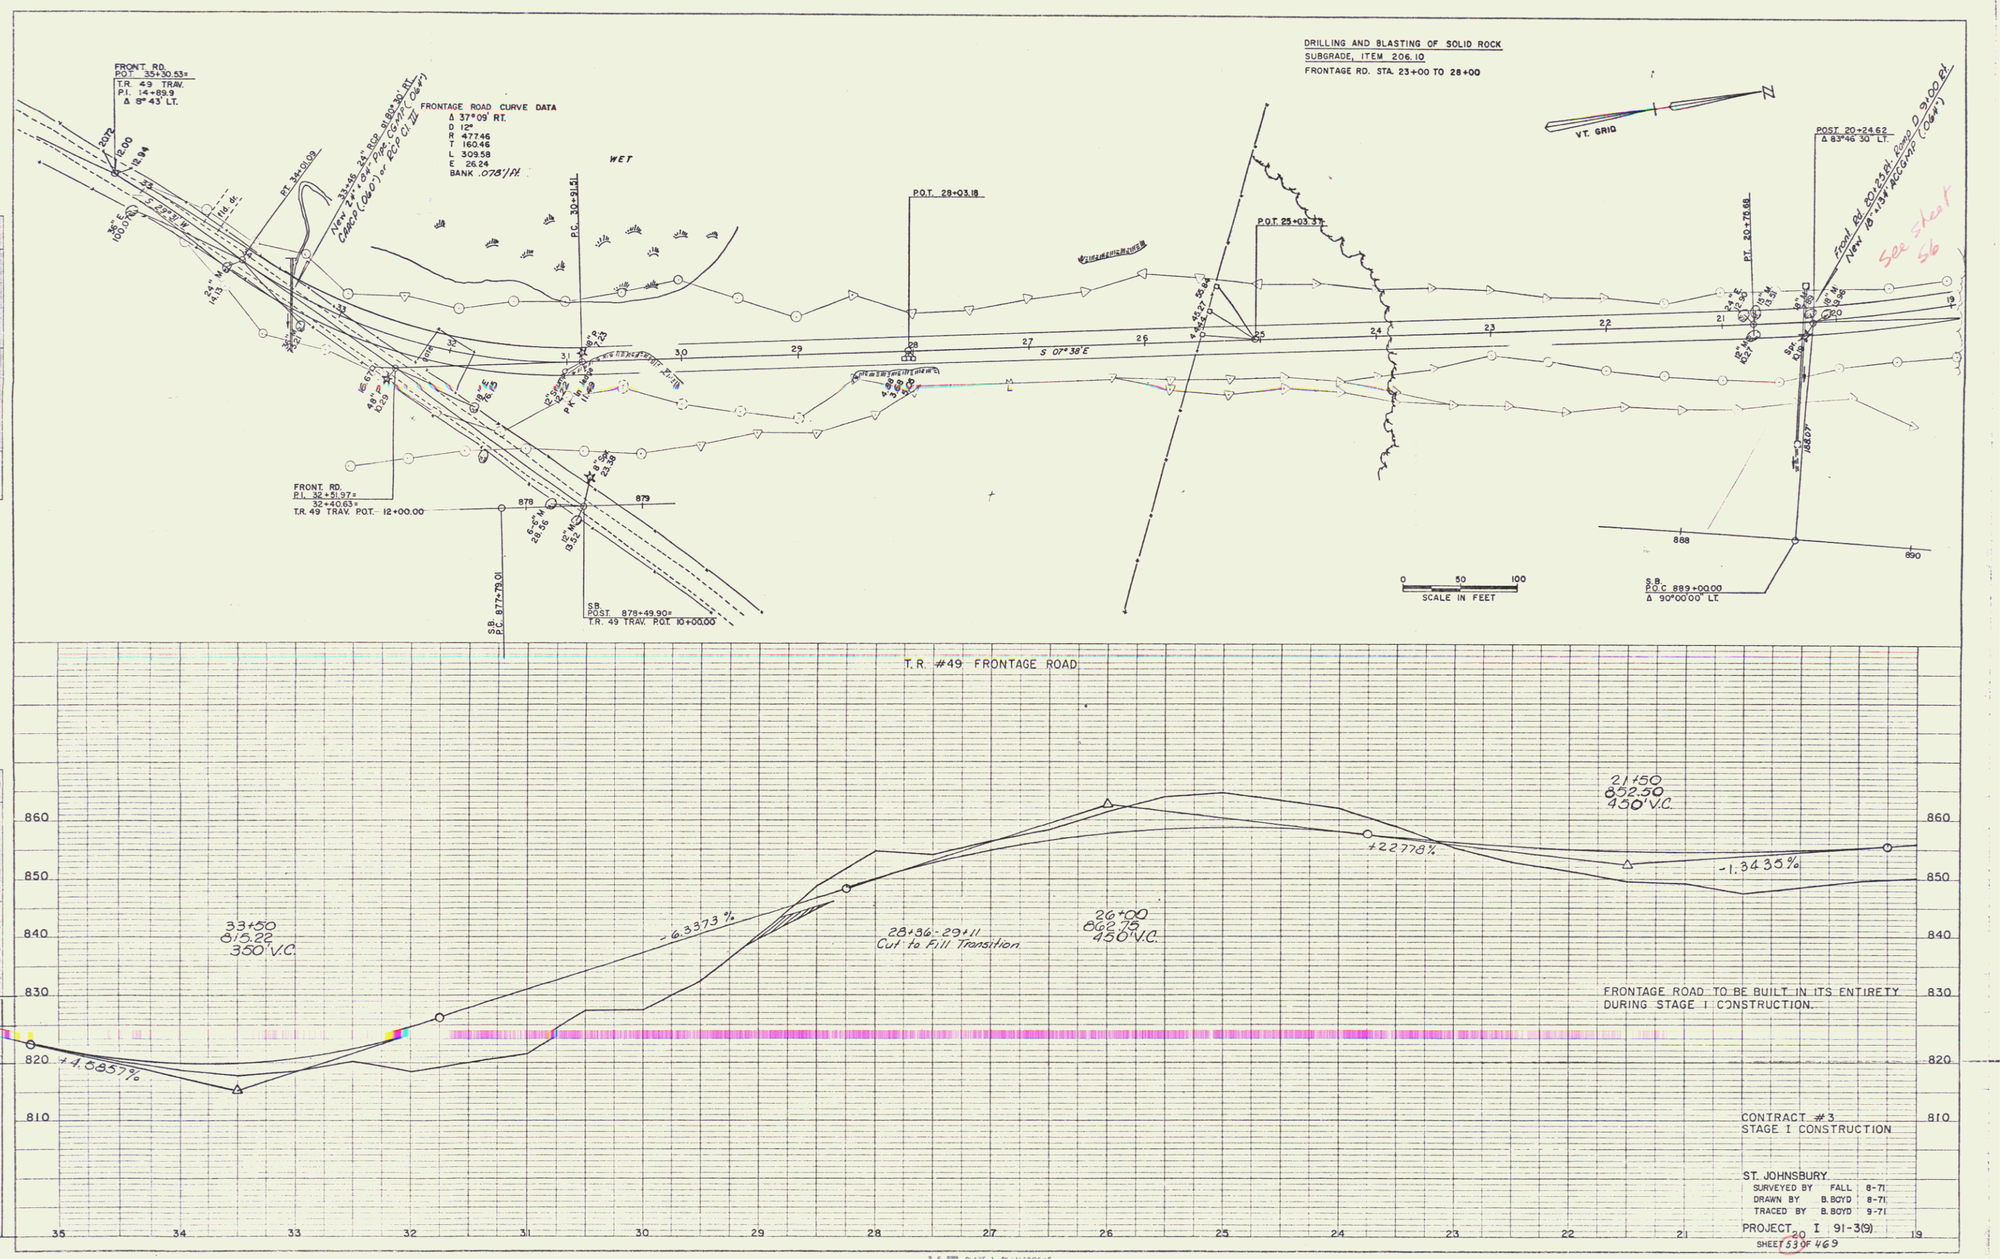
DRILLING AND BLASTING OF SOLID ROCK
SUBGRADE, ITEM 206.10
FRONTAGE RD. STA. 23+00 TO 28+00
FRONT. RD.
P.O.T. 35+30.53±
T.R. 49 TRAV.
P.I. 14+89.9
Δ 8° 43' LT.
FRONTAGE ROAD CURVE DATA
Δ 37°09' RT.
D 12°
R 477.46
T 160.46
L 309.58
E 26.24
BANK .078'/ft.
WET
P.C. 30+91.51
P.O.T. 28+03.18
P.O.T. 25+03.37
S 07°38' E
V.T. GRID
N
POST 20+24.62
Δ 83°46 30 LT.
See sheet 56
FRONT. RD.
P.I. 32+51.97±
32+40.63±
T.R. 49 TRAV. P.O.T. 12+00.00
S.B.
P.C. 877+79.01
S.B.
POST. 878+49.90±
T.R. 49 TRAV. P.O.T. 10+00.00
S.B.
P.O.C. 889+00.00
Δ 90°00'00" LT.
0 50 100
SCALE IN FEET
T.R. #49 FRONTAGE ROAD
33+50
815.22
350' V.C.
-6.3373%
28+36-29+11
Cut to Fill Transition
26+00
450' V.C.
+2.2778%
21+50
852.50
450' V.C.
-1.3435%
FRONTAGE ROAD TO BE BUILT IN ITS ENTIRETY
DURING STAGE I CONSTRUCTION.
CONTRACT #3
STAGE I CONSTRUCTION
ST. JOHNSBURY
SURVEYED BY FALL 8-71
DRAWN BY B. BOYD 8-71
TRACED BY B. BOYD 9-71
PROJECT I 91-3(9)
PLAN
PROFILE
PLATE 1, PLAN-PROFILE
KEUFFEL & ESSER CO.

106