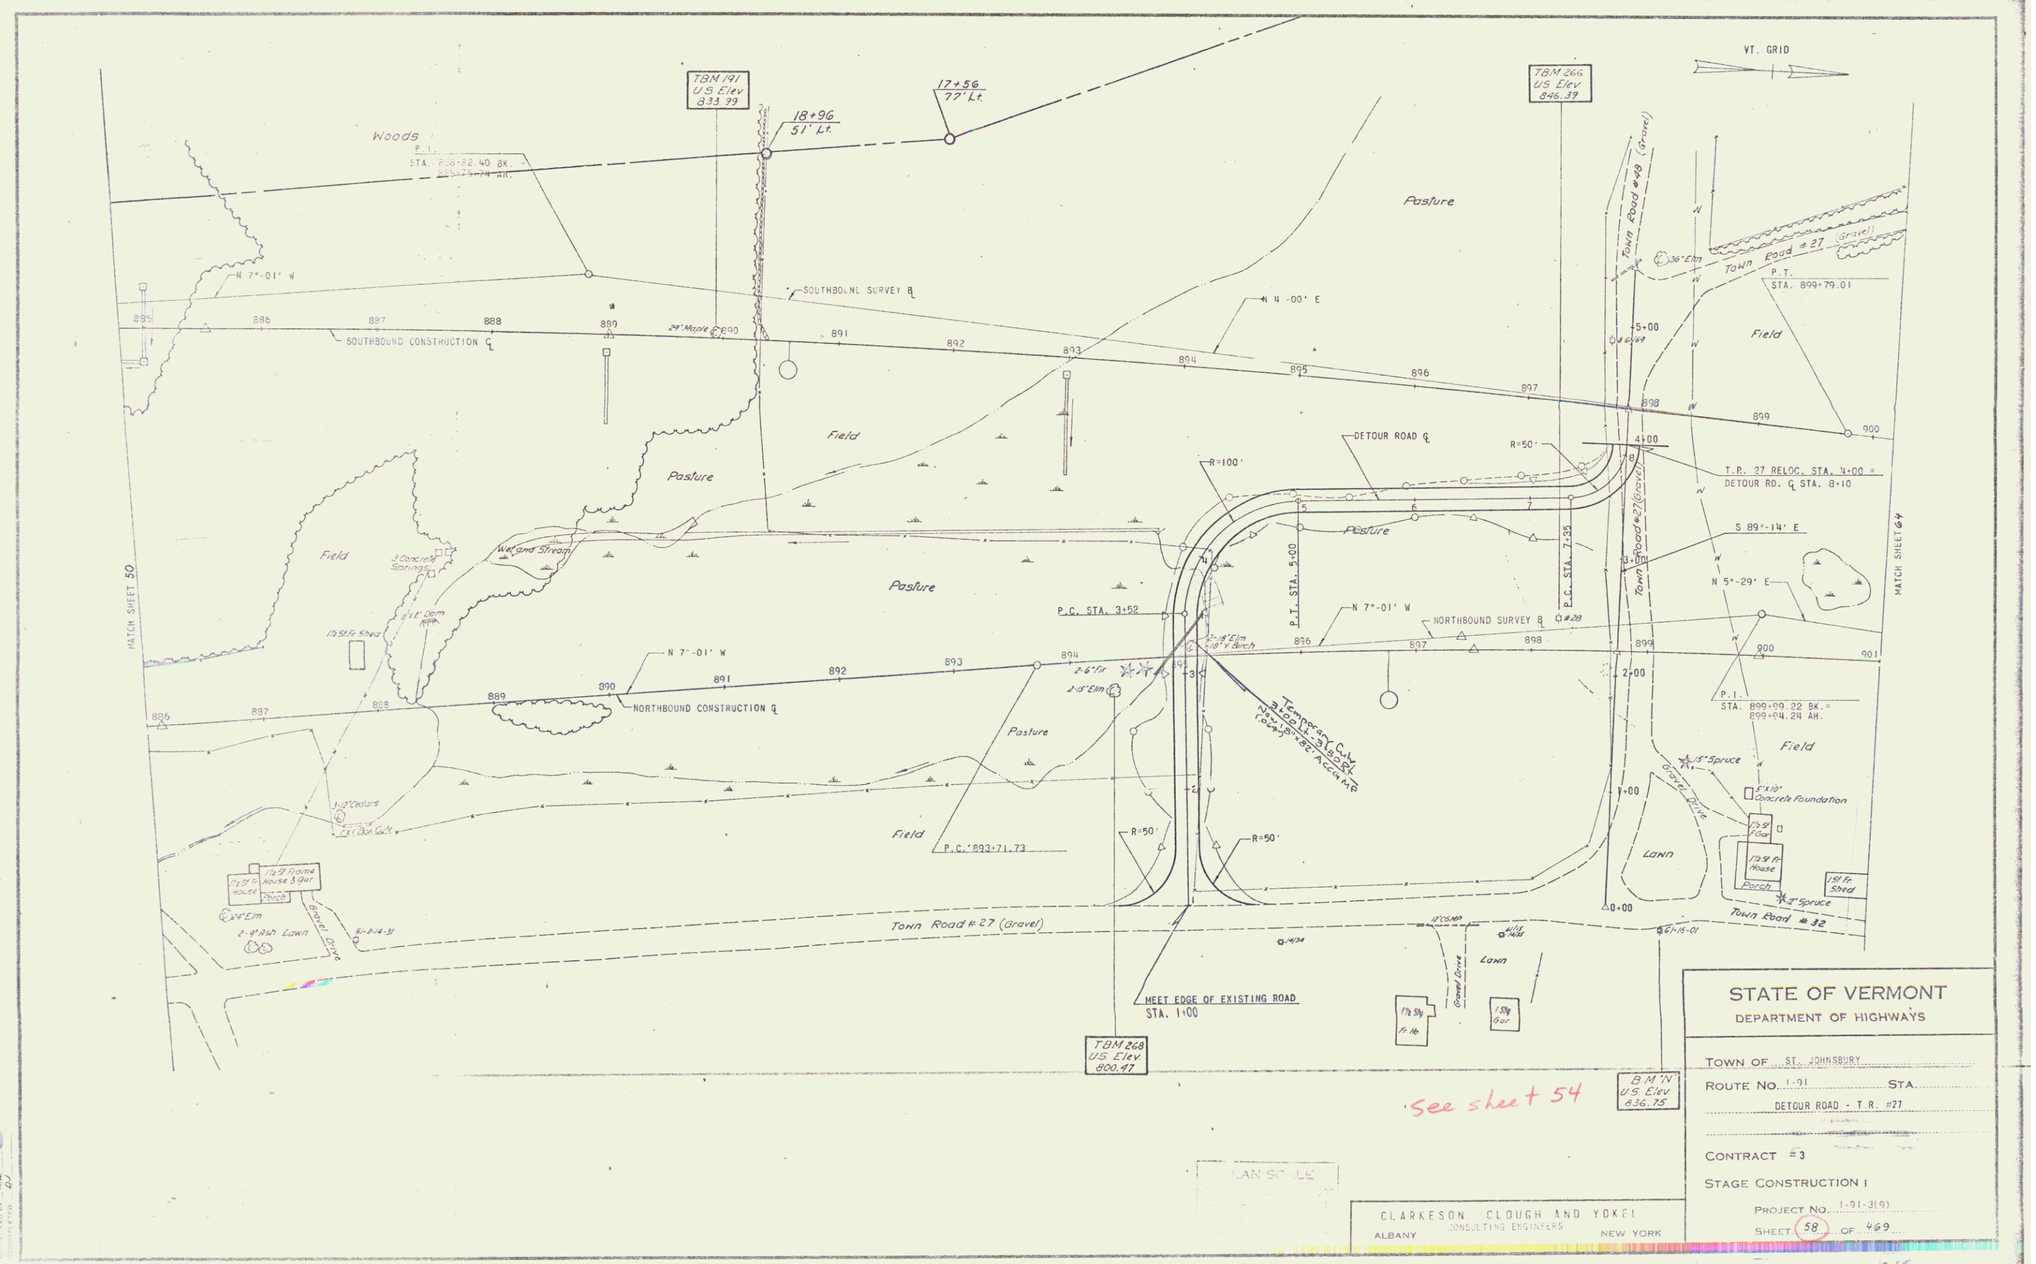
VT. GRID
TBM 191
U.S. Elev
833.99
18+96
51' Lt.
17+56
77' Lt.
TBM 266
US Elev
846.39
Woods
P.I.
STA. 888+82.40 BK. =
888+75.74 AH.
N 7°-01' W
SOUTHBOUND CONSTRUCTION ℄
SOUTHBOUND SURVEY ℄
N 4°-00' E
Pasture
Field
Town Road #48 (Gravel)
Town Road #27 (Gravel)
36" Elm
P.T.
STA. 899+79.01
DETOUR ROAD ℄
R=100'
R=50'
T.R. 27 RELOC. STA. 4+00 =
DETOUR RD. ℄ STA. 8+10
S 89°-14' E
N 5°-29' E
P.C. STA. 3+52
P.T. STA. 5+00
P.C. STA. 7+35
N 7°-01' W
NORTHBOUND SURVEY ℄
NORTHBOUND CONSTRUCTION ℄
Wetland Stream
3 Concrete Springs
6'x8' Dam
17'x9' Shed
3-12" Cedars
1'x1' Box Gdn.
17'x9' Frame House & Gar
Porch
14" Elm
2-9" Rsh Lawn
Gravel Drive
6-8-14-31
Town Road #27 (Gravel)
P.C. 893+71.73
2-6" Fir
2-5" Elm
Temporary Cut
Elev. 835.0
Nov. 1973 ACCM MP
8" Elm
8" Birch
P.I.
STA. 899+09.22 BK. =
899+04.24 AH.
5" Spruce
1'x10' Concrete Foundation
17'x9' Gar
17'x9' Fr. House
Porch
15' Fr. Shed
Lawn
Town Road #32
61-16-01
12" CMP
MEET EDGE OF EXISTING ROAD
STA. 1+00
TBM 268
U.S. Elev.
800.97
17'x9' Fr. 16
15'x9' Gar
B.M. N
U.S. Elev
836.75
MATCH SHEET 50
MATCH SHEET 64
See sheet 54
PLAN SCALE
CLARKESON, CLOUGH AND YOKEL
CONSULTING ENGINEERS
ALBANY
NEW YORK
STATE OF VERMONT
DEPARTMENT OF HIGHWAYS
TOWN OF ST. JOHNSBURY
ROUTE NO. I-91 STA.
DETOUR ROAD - T.R. #27
CONTRACT #3
STAGE CONSTRUCTION I
PROJECT NO. I-91-3(9)
SHEET 58 OF 469